


U. S. PUBLIC LAND SURVEY MONUMENT RECORD

SECTION 20 T 15 N, R 5 W, TOWN OF WASHINGTON

LA CROSSE COUNTY

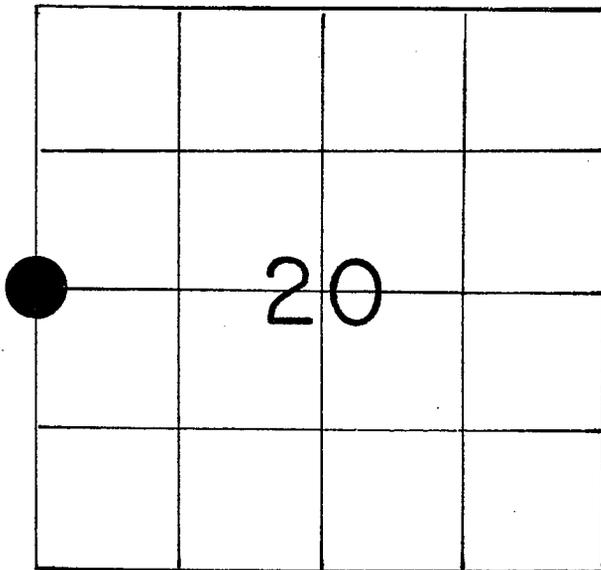

LOCATION OF LANDMARK

WISCONSIN COORDINATE SYSTEM

North

East

Theta Angle

Horiz. Order

Vert. Order

TYPE OF LANDMARK

Brass cap Lunde marker

BEARINGS ARE REFERENCED TO

Assumed

Crew: WILLIAM C. JUNG
PETER F. FOLLANSBEE

Date: 10/01/1990

Describe any record evidence, monument evidence, testimonial evidence or any other material evidence you considered and whether the monument was found or restored through acceptance of an obliterated evidence location.

Rob Lampman set a pipe at this corner in August of 1984. I accepted the location of the pipe, removed it, and replaced it with a Lunde marker set in a mound of rocks. I also set a sign and post on the South side of the Lunde and buried a bottle with a shell casing on the Southwest side of the marker.

Describe or show any material discrepancy between the location of the restored corner and that of the corner previously restored or reestablished.

NONE KNOWN

RECORD OF DURABLE WITNESS MONUMENTS
MAGNETIC

NO	DESCRIPTION	BEARING	DISTANCE
1	Ex. Nail in NE-side 11" Boxelder	S 33° W	Sl. = 22.03'
2	Ex. Nail in SW-side 20" White Oak	S 23° E	Sl. = 48.48'
3	Ex. Nail in SW-side 22" White Oak	S 36° E	Sl. = 36.82'
4	Ex. Nail in SW-side 13" dbl. Bl'k Cherry	N 72° E	26.56 Ft.

W 1/4-COR., SEC. 20-15-5.
SET BRASS CAP LUNDE MARKER
TO REPLACE AN IRON PIPE. SET
LUNDE IN A MOUND OF ROCKS
WITH SIGN AND POST ON SOUTH
SIDE. BURIED A BOTTLE CONTAINING
A BLANK BULLET ON THE SW-SIDE.

(NOTE: ALL DISTANCES ARE
TO EXIST. NAILS IN EXIST.
DOUBLE BLAZED B. T. 's)


APPROX. CENTER OF GULLY. →

(NOT TO SCALE)

PLAN VIEW DRAWING OF REFERENCE TIES


MAP SHOWING DISTANCE AND DIRECTION TO OTHER PUBLIC LAND
SURVEY CORNERS USED FOR REESTABLISHING THE CORNER

(not to scale)

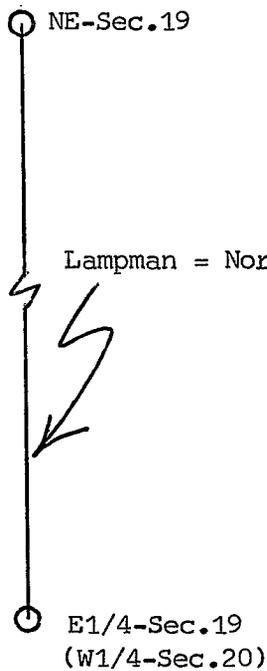

I, William C. Jung, Deputy County Surveyor
HEREBY CERTIFY THAT THE CORNER LOCATION SHOWN ON THIS RECORD
WAS DETERMINED BY ME OR UNDER MY DIRECTION AND CONTROL AND
THAT THIS U. S. PUBLIC LAND SURVEY MONUMENT RECORD IS CORRECT
AND COMPLETE TO THE BEST OF MY KNOWLEDGE AND BELIEF.

William C. Jung January 11, 1991
Signature Date

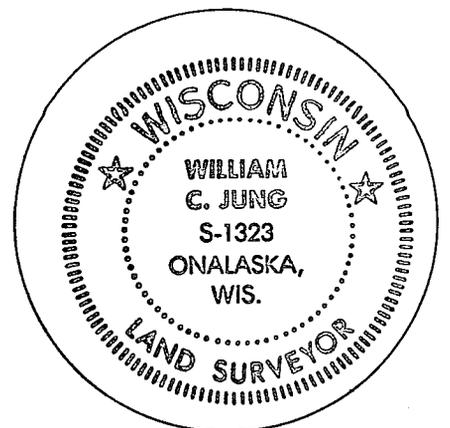

Seal