


## U. S. PUBLIC LAND SURVEY MONUMENT RECORD

SECTION 20 T 15 N, R 5 W, TOWN OF WASHINGTON

LA CROSSE COUNTY

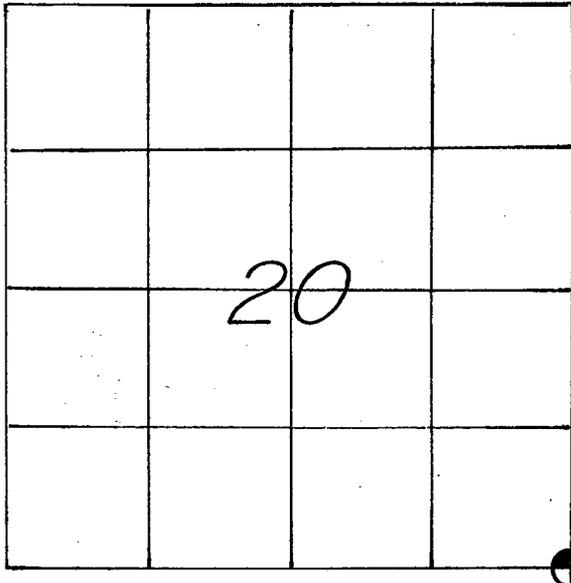

LOCATION OF LANDMARK

Crew: WILLIAM C. JUNG  
 PETER F. FOLLANSBEE  
 Date: 4/15/1997

WISCONSIN COORDINATE SYSTEM

North

East

Theta Angle

Horiz. Order

Vert. Order

TYPE OF LANDMARK

Brass cap Lunde marker.

BEARINGS ARE REFERENCED TO

Assumed North.

Describe any record evidence, monument evidence, testimonial evidence or any other material evidence you considered and whether the monument was found or restored through acceptance of an obliterated evidence location.

I accepted the old occupied corner as the best available evidence of the original government corner position and monumented it with a Lunde marker.

Describe or show any material discrepancy between the location of the restored corner and that of the corner previously restored or reestablished.

None Known.


RECORD OF DURABLE WITNESS MONUMENTS  
MAGNETIC

NO	DESCRIPTION	BEARING	DISTANCE
1	Set P.K. Nail in SW-side 7" Hickory	N 79°W	20.32 Ft.
2	Set P.K. Nail in N.-side 10½" Hickory	S 71°E	44.79 Ft.
3	Set P.K. Nail in SW-side 4½" Hickory	S 49°E	11.20 Ft.
4	Set P.K. Nail in SW-side 9" Hickory	S 31°E	46.75 Ft.

( Note: all 4 Bearing Trees are double blazed. )

( F I E L D )

( Not to scale )

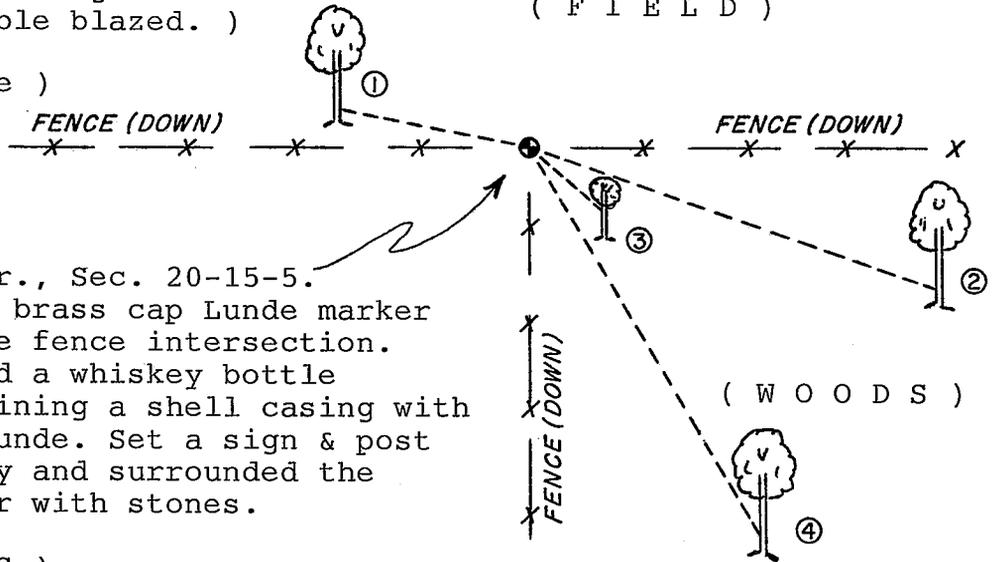


SE-Cor., Sec. 20-15-5.  
Set a brass cap Lunde marker at the fence intersection.  
Buried a whiskey bottle containing a shell casing with the Lunde. Set a sign & post nearby and surrounded the corner with stones.

( W O O D S )

PLAN VIEW DRAWING OF REFERENCE TIES

MAP SHOWING DISTANCE AND DIRECTION TO OTHER PUBLIC LAND SURVEY CORNERS USED FOR REESTABLISHING THE CORNER

(not to scale)

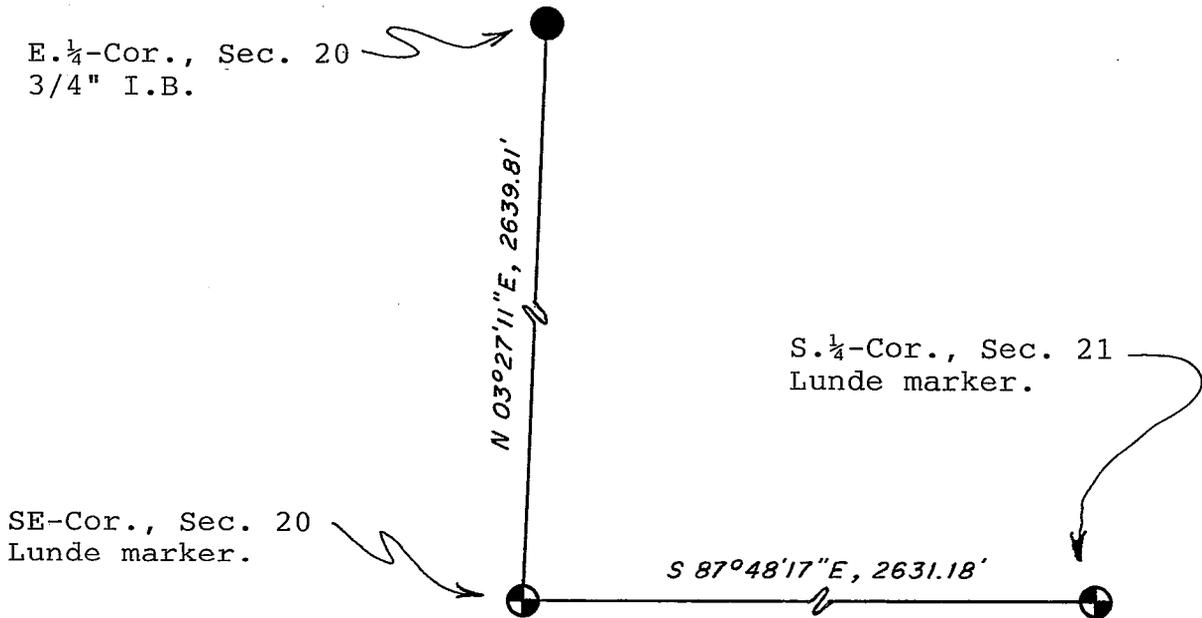

I, William C. Jung, County Surveyor  
HEREBY CERTIFY THAT THE CORNER LOCATION SHOWN ON THIS RECORD  
WAS DETERMINED BY ME OR UNDER MY DIRECTION AND CONTROL AND  
THAT THIS U. S. PUBLIC LAND SURVEY MONUMENT RECORD IS CORRECT  
AND COMPLETE TO THE BEST OF MY KNOWLEDGE AND BELIEF.

William C. Jung  
Signature

6/13/97  
Date



Seal