


21505210000

U. S. PUBLIC LAND SURVEY MONUMENT RECORD

SECTION 28 T 15 N, R 5 W, TOWN OF WASHINGTON

LA CROSSE COUNTY

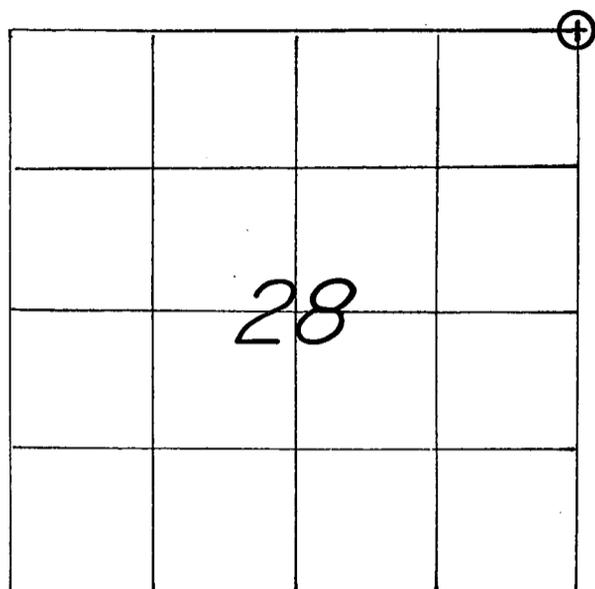

LOCATION OF LANDMARK

CREW: **WILLIAM C. JUNG**
PETER F. FOLLANSBEE
 DATE: **4/24/2001**

WISCONSIN COORDINATE SYSTEM

North **640,925.240**East **1,712,007.709**

Theta Angle

Horiz. Order

Vert. Order

DATUM: **'83 ('91)**

TYPE OF LANDMARK

3/4" x 30" IRON BAR WITH AN ALUMINUM CAP.

BEARINGS ARE REFERENCED TO

GRID NORTH AS PER SECTION DATA.

Describe any record evidence, monument evidence, testimonial evidence or any other material evidence you considered and whether the monument was found or restored through acceptance of an obliterated evidence location.

After discussing this corner with Chris Fechner, RLS 2448, I set the corner at a location previously computed by him. The corner falls 14ft. West of an existing fence, but lines up with another old line fence to the South. The corner was monumented with an iron bar with cap.

Describe or show any material discrepancy between the location of the restored corner and that of the corner previously restored or reestablished.

NONE KNOWN.

RECORD OF DURABLE WITNESS MONUMENTS
MAG.


NO	DESCRIPTION	BEARING	DISTANCE
1	SET A NAIL IN S.W.-SIDE OF A 21" WHITE OAK	N 46° W	22.48 FT.
2	SET A NAIL IN W.-SIDE OF A DOUBLE WHITE OAK	N 10° E	SLOPE = 11.66'
3	SET A NAIL IN S.W.-SIDE OF AN 11-1/2" ASH?	S 10° E	SLOPE = 10.75'
4	SET A NAIL IN S.E.-SIDE OF A 24-1/2" OAK	S 35° W	SLOPE = 34.80'

(NOT TO SCALE)

(WOODS)

N.E.-COR., SEC. 28-15-5.
SET A 3/4" x 30" IRON BAR WITH AN ALUMINUM CAP FLUSH TO THE GROUND. THE CORNER LOCATION IS ON LINE WITH A FENCE UP THE HILL TO THE SOUTH.


(NOTE: THE FOUR BEARING TREES ARE DOUBLE BLAZED)

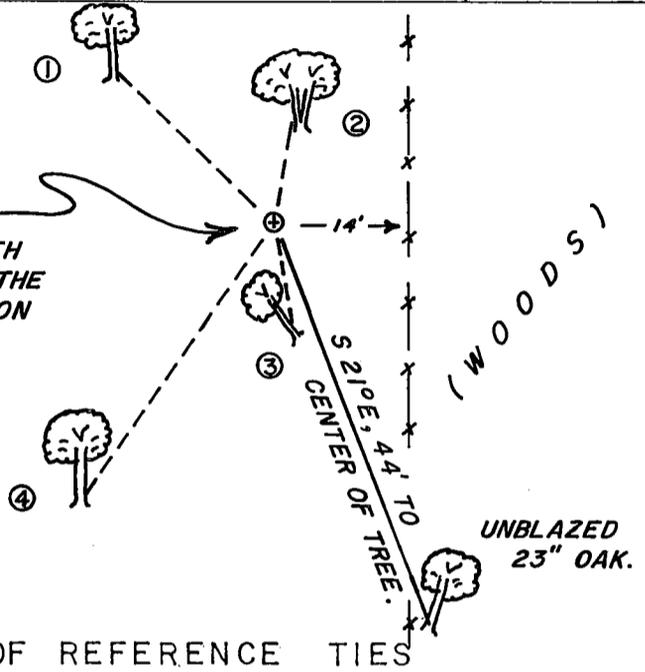

PLAN VIEW DRAWING OF REFERENCE TIES


MAP SHOWING DISTANCE AND DIRECTION TO OTHER PUBLIC LAND SURVEY CORNERS USED FOR REESTABLISHING THE CORNER

(GRID BEARINGS & DISTANCES)
(GRID FACTOR: 0.999898977)

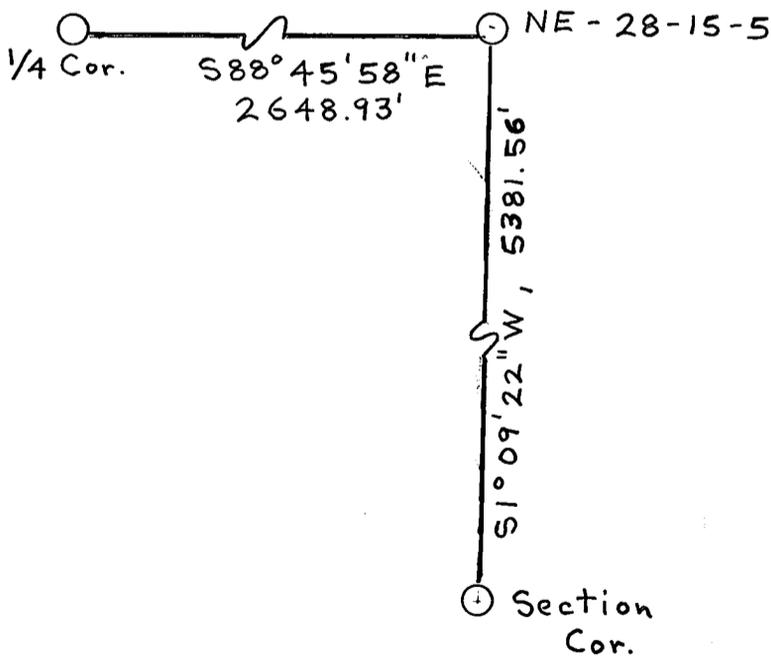

I, WILLIAM C. JUNG, COUNTY SURVEYOR
HEREBY CERTIFY THAT THE CORNER LOCATION SHOWN ON THIS RECORD WAS DETERMINED BY ME OR UNDER MY DIRECTION AND CONTROL AND THAT THIS U. S. PUBLIC LAND SURVEY MONUMENT RECORD IS CORRECT AND COMPLETE TO THE BEST OF MY KNOWLEDGE AND BELIEF.

William C. Jung 7/9/01
Signature Date

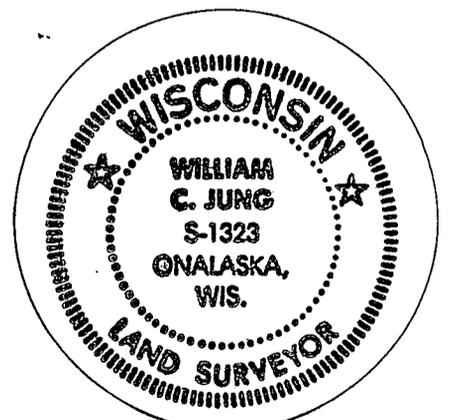

Seal