


U. S. PUBLIC LAND SURVEY MONUMENT RECORD

SECTION 23 T 15 N, R 5 W, TOWN OF WASHINGTON

LA CROSSE COUNTY

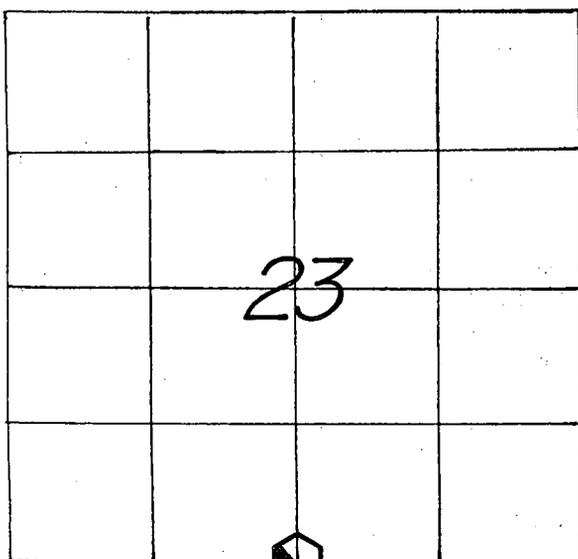

LOCATION OF LANDMARK

CREW: **WILLIAM C. JUNG**  
**PETER F. FOLLANSBEE**  
 DATE: 6/13/2006

WISCONSIN COORDINATE SYSTEM
North
East
Theta Angle
Horiz. Order
Vert. Order

TYPE OF LANDMARK  
**30" ALUMINUM BERNTSEN MARKER.**

BEARINGS ARE REFERENCED TO  
**ASSUMED NORTH AS PER SECTION DATA.**

Describe any record evidence, monument evidence, testimonial evidence or any other material evidence you considered and whether the monument was found or restored through acceptance of an obliterated evidence location.

K. Don Pederson set a spike at this corner at the "single proportionate" position. I agree with the way that he set the corner. I removed his spike and replaced it with 30" Berntsen, down 10" in a field.


Describe or show any material discrepancy between the location of the restored corner and that of the corner previously restored or reestablished.

This may or may not fit Bob Chalsma's 1/4 corner position on his 1983 survey.


RECORD OF DURABLE WITNESS MONUMENTS

ASSUMED(MAG.) BEARINGS

NO	DESCRIPTION	BEARING	DISTANCE
1	SET A 3/4" x 30" IRON BAR WITH A RED PLASTIC CAP	S 04°00'06"W	309.50 FT.
2	SET A 3/4" x 30" IRON BAR WITH A RED PLASTIC CAP	S 24°50'40"W	332.60 FT.
3	SET A 3/4" x 30" IRON BAR WITH A RED PLASTIC CAP	S 51°17'02"W	309.50 FT.
4	SET A 3/4" x 30" IRON BAR WITH A RED PLASTIC CAP	S 74°36'49"W	241.09 FT.

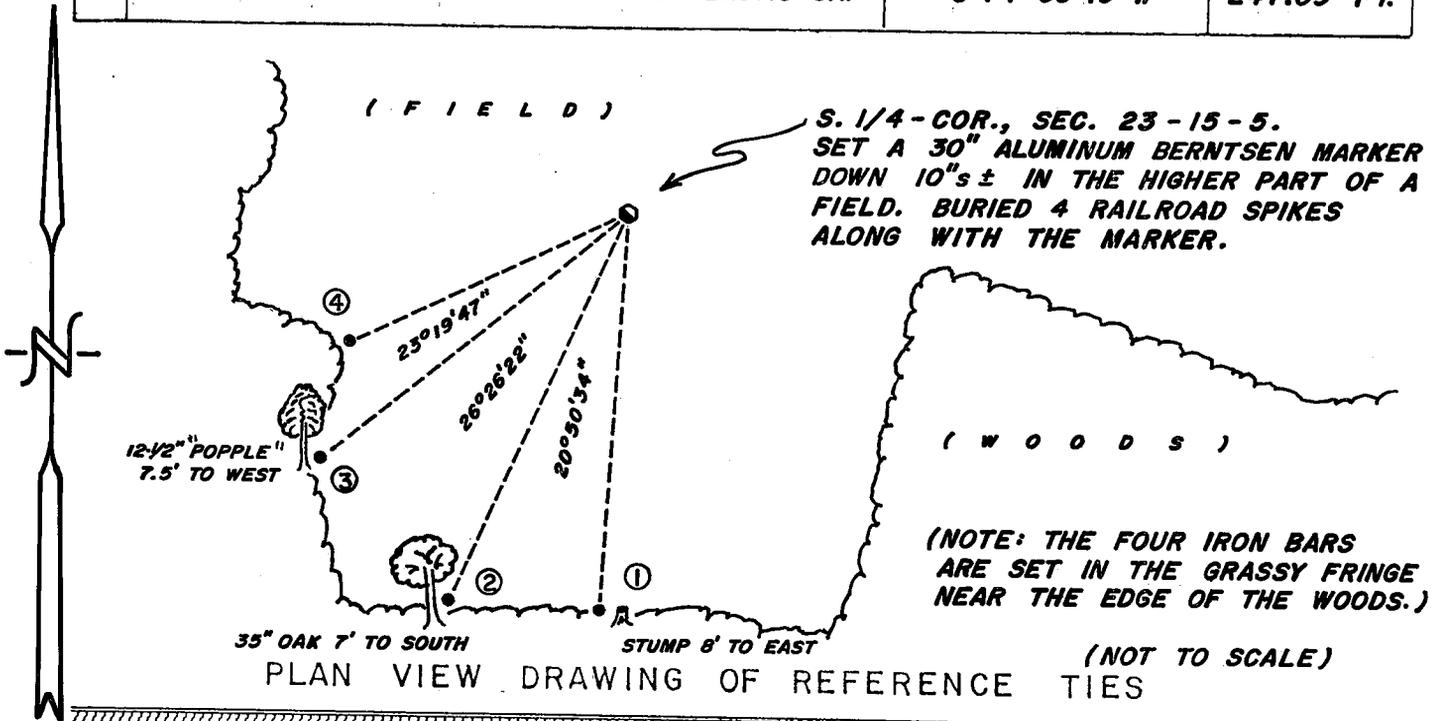

MAP SHOWING DISTANCE AND DIRECTION TO OTHER PUBLIC LAND SURVEY CORNERS USED FOR REESTABLISHING THE CORNER

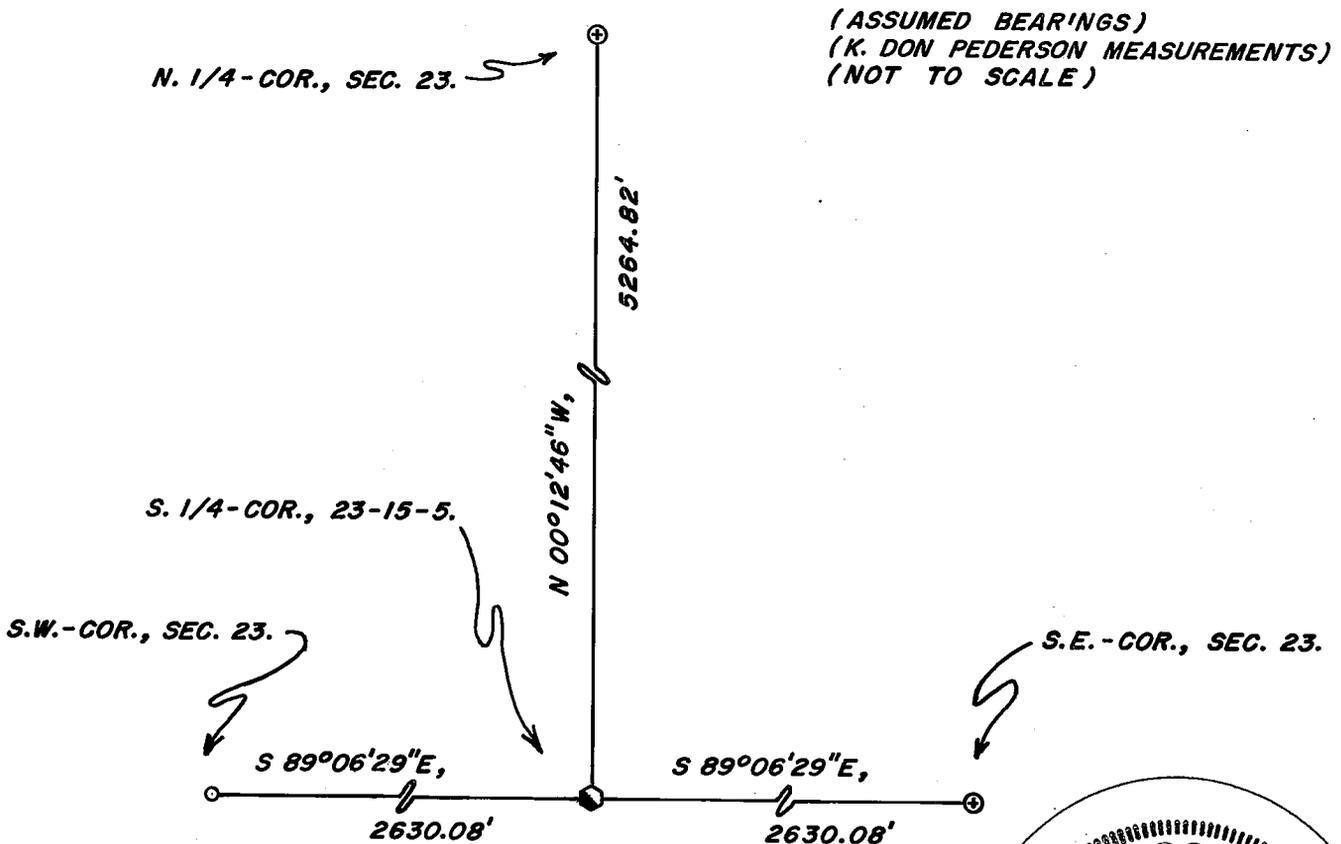

I, WILLIAM C. JUNG, COUNTY SURVEYOR  
 HEREBY CERTIFY THAT THE CORNER LOCATION SHOWN ON THIS RECORD  
 WAS DETERMINED BY ME OR UNDER MY DIRECTION AND CONTROL AND  
 THAT THIS U. S. PUBLIC LAND SURVEY MONUMENT RECORD IS CORRECT  
 AND COMPLETE TO THE BEST OF MY KNOWLEDGE AND BELIEF.

William C. Jung 7/6/06  
 Signature Date



Seal