


21505250020

U. S. PUBLIC LAND SURVEY MONUMENT RECORD

SECTION 36 T 15 N, R 5 W, TOWN OF WASHINGTON

LA CROSSE COUNTY

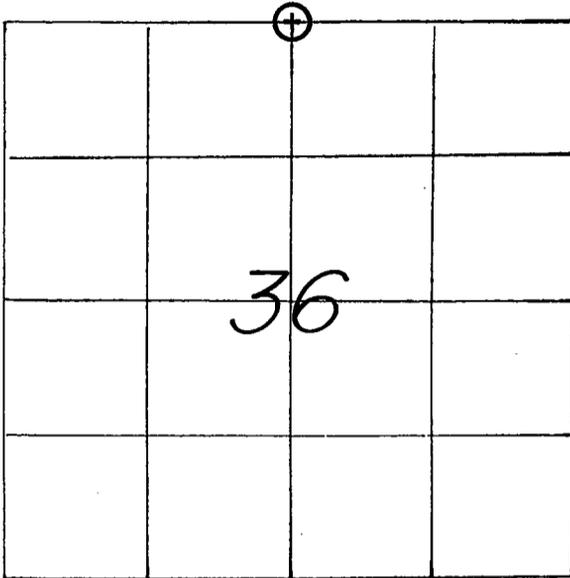

WISCONSIN COORDINATE SYSTEM

North

East

Theta Angle

Horiz. Order

Vert. Order

TYPE OF LANDMARK

3/4" x 30" IRON BAR WITH ALUMINUM CAP.BEARINGS ARE REFERENCED TO
ASSUMED NORTH.

LOCATION OF LANDMARK

CREW: WILLIAM C. JUNG
 PETER F. FOLLANSBEE
 DATE 1/22/1998

Describe any record evidence, monument evidence, testimonial evidence or any other material evidence you considered and whether the monument was found or restored through acceptance of an obliterated evidence location.

In my opinion the large old burr oak to the Southeast is the original government survey bearing tree. Using this tree, I set an iron bar with a cap at the corner.


Describe or show any material discrepancy between the location of the restored corner and that of the corner previously restored or reestablished.

None known.


RECORD OF DURABLE WITNESS MONUMENTS

MAGNETIC

NO	DESCRIPTION	BEARING	DISTANCE
1	SET A NAIL IN THE S-SIDE 12" BURR OAK (DOUBLE BLAZED)	S 66° W	12.36 FT.
2	SET A NAIL IN THE SW-SIDE 7-1/2" ASH (DOUBLE BLAZED)	N 29° W	SLOPE= 19.40'
3	SET A P.K. NAIL IN NW-SIDE 3" OAK (UNBLAZED)	N 41° E	22.21 FT.
4	SET A P.K. NAIL IN NW-SIDE 3-1/4" HICKORY (UNBLAZED)	N 58° E	9.58 FT.

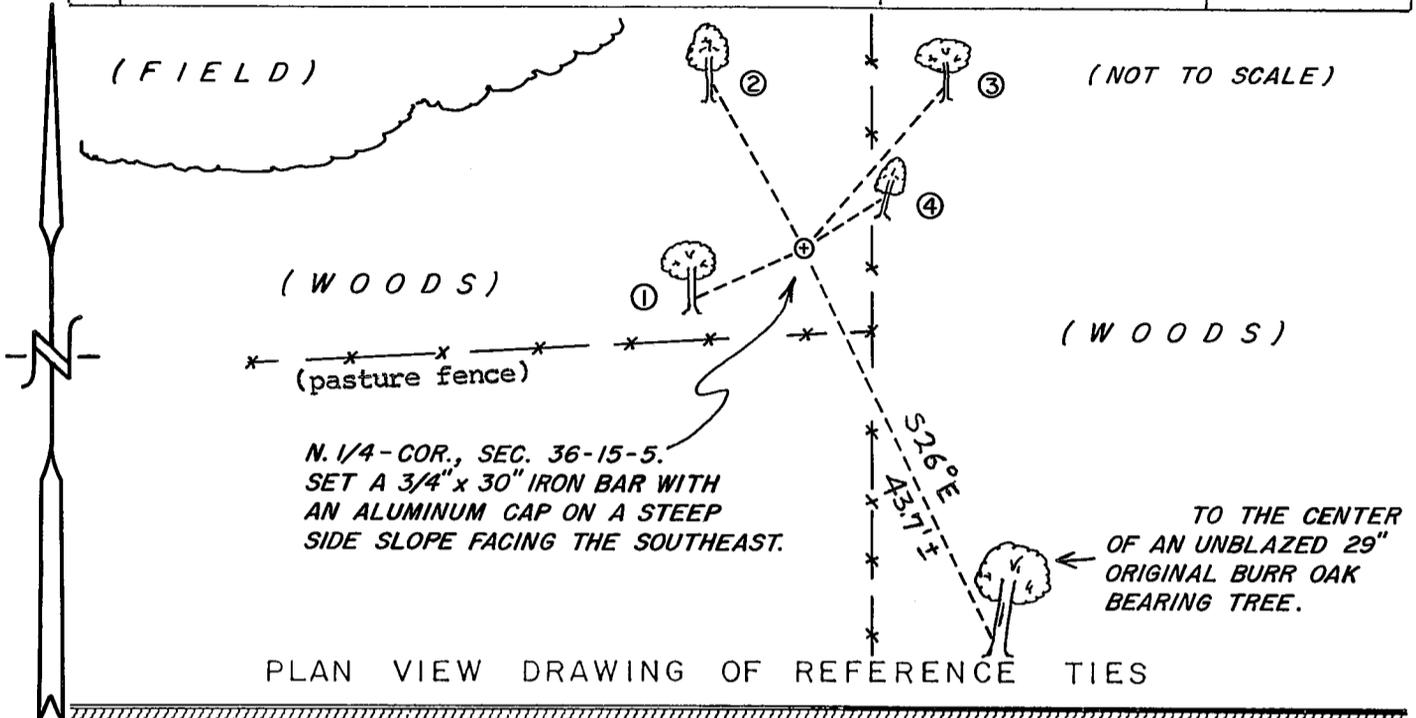


MAP SHOWING DISTANCE AND DIRECTION TO OTHER PUBLIC LAND SURVEY CORNERS USED FOR REESTABLISHING THE CORNER

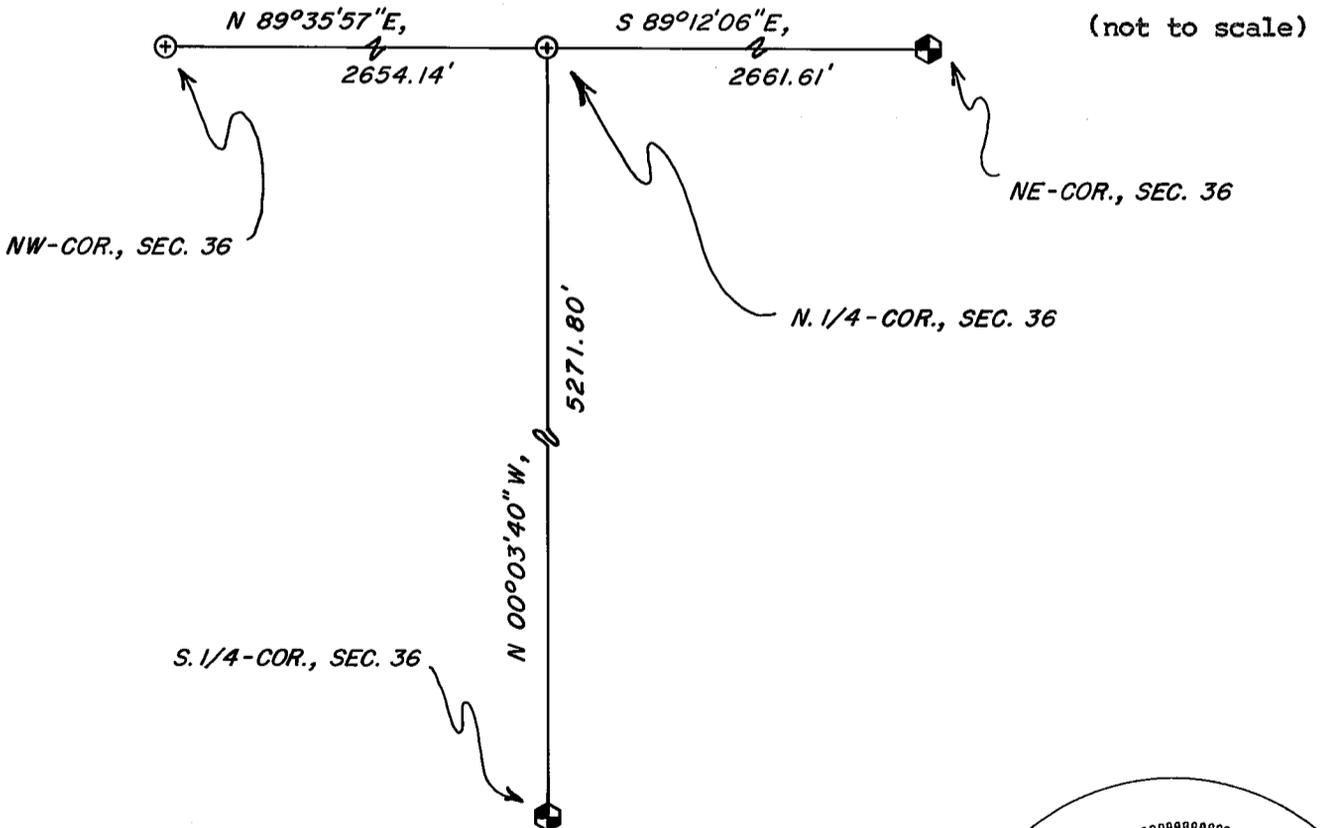

I, WILLIAM C. JUNG, COUNTY SURVEYOR
 HEREBY CERTIFY THAT THE CORNER LOCATION SHOWN ON THIS RECORD WAS DETERMINED BY ME OR UNDER MY DIRECTION AND CONTROL AND THAT THIS U. S. PUBLIC LAND SURVEY MONUMENT RECORD IS CORRECT AND COMPLETE TO THE BEST OF MY KNOWLEDGE AND BELIEF.

William C. Jung
 Signature

March 16, 1998
 Date

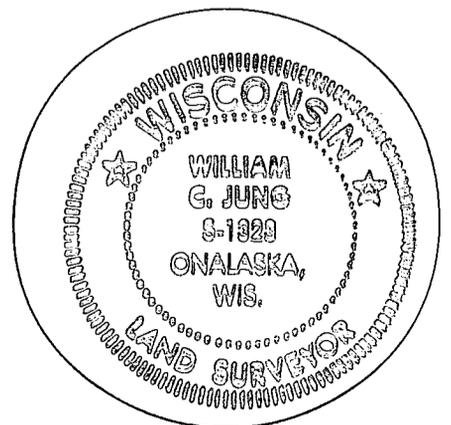

Seal