


21505262000

U. S. PUBLIC LAND SURVEY MONUMENT RECORD

SECTION 25 T 15 N, R 5 W, TOWN OF WASHINGTON

LA CROSSE COUNTY

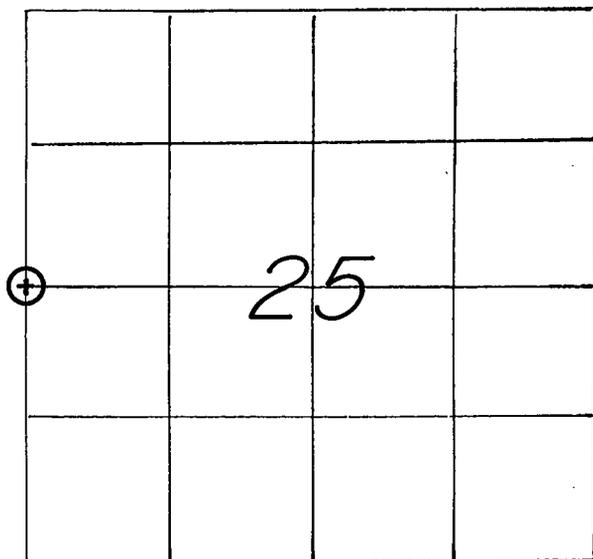

LOCATION OF LANDMARK

CREW: WILLIAM C. JUNG
 PETER F. FOLLANSBEE
 DATE: 1/20/1998

WISCONSIN COORDINATE SYSTEM
North
East
Theta Angle
Horiz. Order
Vert. Order
TYPE OF LANDMARK
3/4" x 30" IRON BAR WITH ALUMINUM CAP
BEARINGS ARE REFERENCED TO
ASSUMED NORTH.

Describe any record evidence, monument evidence, testimonial evidence or any other material evidence you considered and whether the monument was found or restored through acceptance of an obliterated evidence location.


I accepted the old occupied corner location as the best available evidence of the original government corner location and monumented it with an iron bar with a cap. The location of this corner is where the old corner was before farmland consolidation. Ray Korn agreed that this is where the old occupied corner was.

Describe or show any material discrepancy between the location of the restored corner and that of the corner previously restored or reestablished.

None known.


RECORD OF DURABLE WITNESS MONUMENTS

NO	DESCRIPTION	BEARING	DISTANCE
1	SET A P.K. NAIL IN THE ROAD CENTERLINE	WEST ±	71.73 FT.
2	SET A 3/4" x 30" IRON BAR 22'± EASTERLY OF CENTERLINE	N. WESTERLY	45.19 FT.
3	SET A 3/4" x 30" IRON BAR 21'± EASTERLY OF CENTERLINE	NORTHERLY	81.41 FT.
4	SET A 1-1/4" x 24" IRON PIPE 18"s NORTH OF FENCE	EAST ±	40.25 FT.

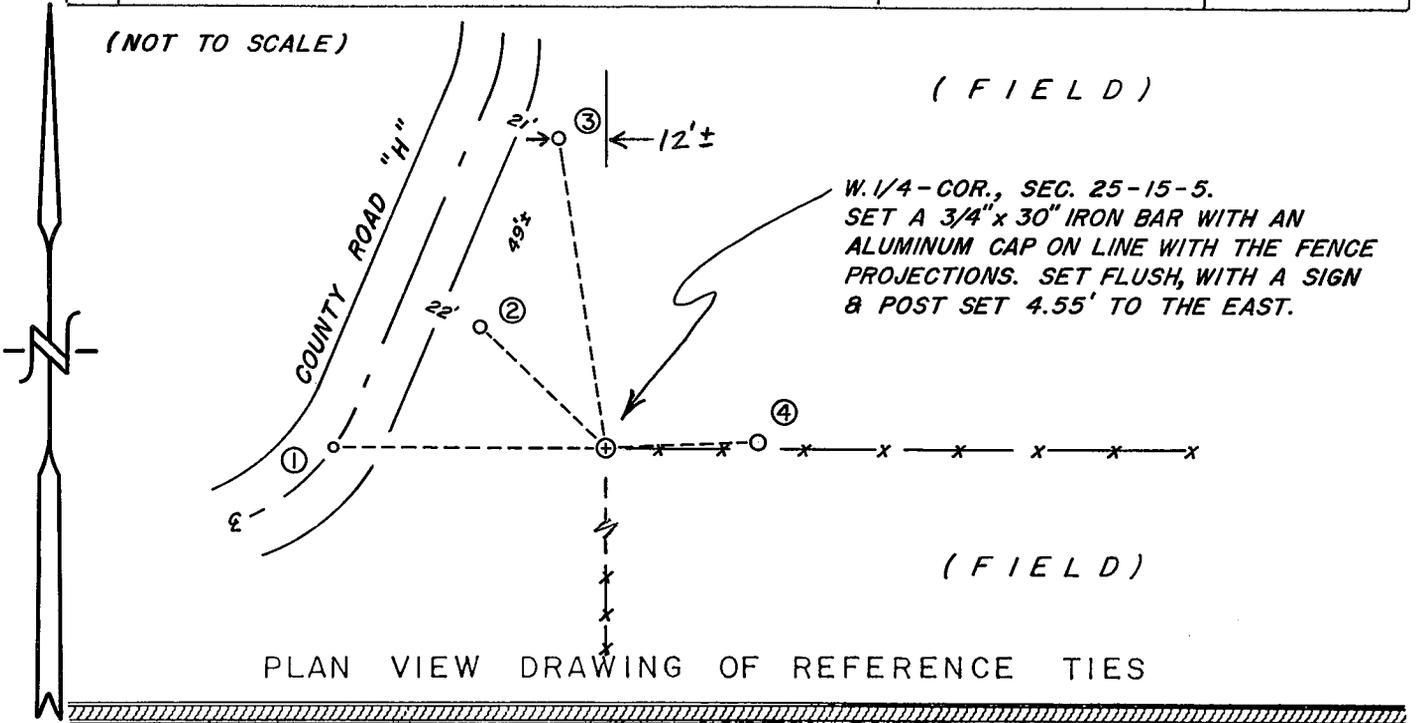


MAP SHOWING DISTANCE AND DIRECTION TO OTHER PUBLIC LAND SURVEY CORNERS USED FOR REESTABLISHING THE CORNER

(not to scale)

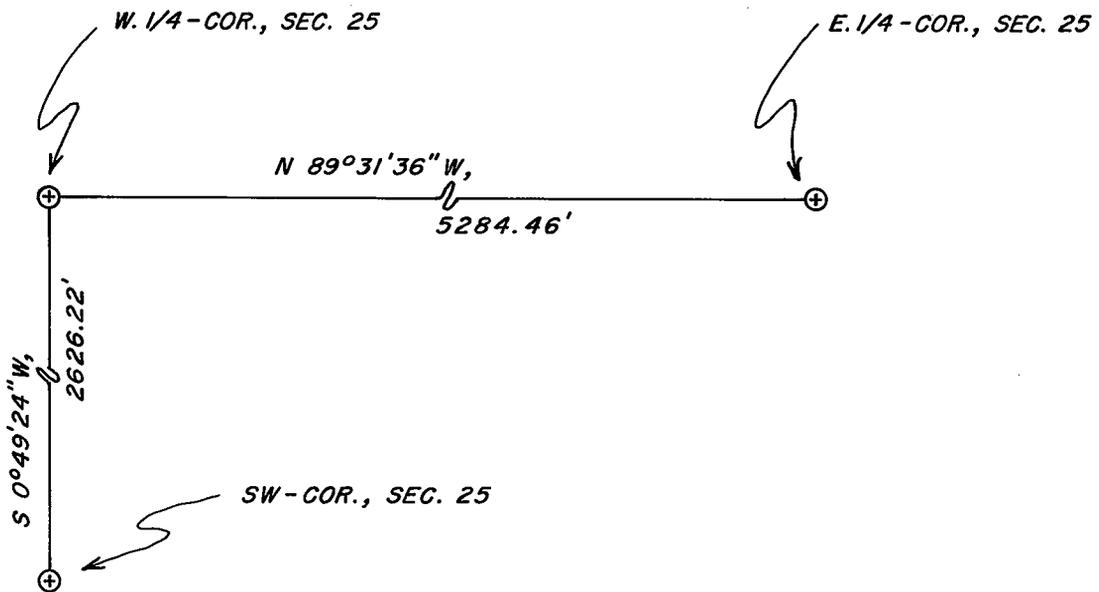

I, WILLIAM C. JUNG, COUNTY SURVEYOR
 HEREBY CERTIFY THAT THE CORNER LOCATION SHOWN ON THIS RECORD
 WAS DETERMINED BY ME OR UNDER MY DIRECTION AND CONTROL AND
 THAT THIS U. S. PUBLIC LAND SURVEY MONUMENT RECORD IS CORRECT
 AND COMPLETE TO THE BEST OF MY KNOWLEDGE AND BELIEF.

William C. Jung March 13, 1998
 Signature Date

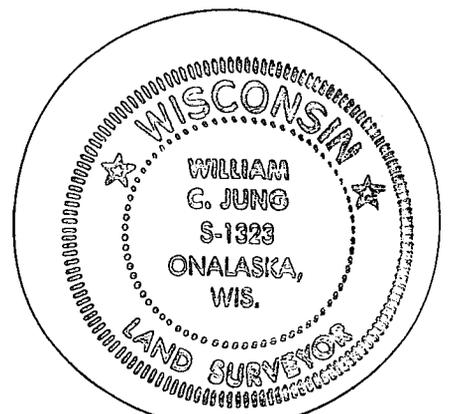

Seal