


21505270020

U. S. PUBLIC LAND SURVEY MONUMENT RECORD

SECTION 34 T 15 N, R 5 W, TOWN OF Washington

LA CROSSE COUNTY

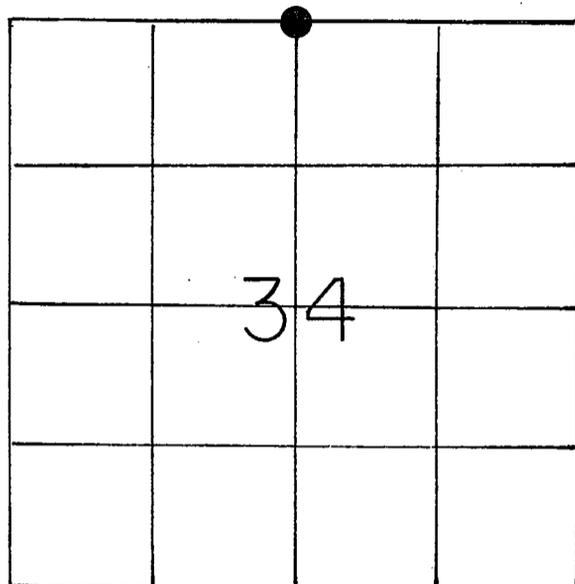

LOCATION OF LANDMARK

WISCONSIN COORDINATE SYSTEM

North

East

Theta Angle

Horiz. Order

Vert. Order

TYPE OF LANDMARK

Iron pipe ***

BEARINGS ARE REFERENCED TO

Assumed

Crew: William C. Jung

Peter F. Follansbee

Date: 2/16/88 and 6/27/88

Describe any record evidence, monument evidence, testimonial evidence or any other material evidence you considered and whether the monument was found or restored through acceptance of an obliterated evidence location.

I set the corner "as per law", equidistant and on line between the section corners.

Describe or show any material discrepancy between the location of the restored corner and that of the corner previously restored or reestablished.

None known.

*** Revised: August 4, 1988

On 6/27/88 I removed the iron pipe and replaced it with a brass capped Lunde marker. I could not find any evidence of the original government corner. I also buried a whiskey bottle with a note by the Lunde marker.

