


U. S. PUBLIC LAND SURVEY MONUMENT RECORD

SECTION 27 T 15 N, R 5 W, TOWN OF WASHINGTON

LA CROSSE COUNTY

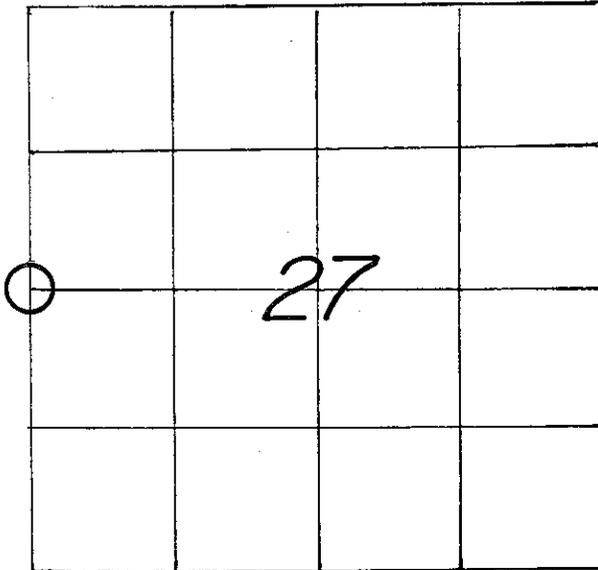

LOCATION OF LANDMARK

CREW: **BRYAN H. MEYER**
PETER F. FOLLANSBEE
 DATE: **4/15/2009**

WISCONSIN COORDINATE SYSTEM	
North	638,212.011
East	1,711,980.058
Theta Angle	
Horiz. Order	
Vert. Order	
DATUM:	NAD 1983 ('91)
TYPE OF LANDMARK	
1-1/4" IRON PIPE	
BEARINGS ARE REFERENCED TO	
GRID NORTH AS PER SECTION DATA.	

Describe any record evidence, monument evidence, testimonial evidence or any other material evidence you considered and whether the monument was found or restored through acceptance of an obliterated evidence location.


Describe or show any material discrepancy between the location of the restored corner and that of the corner previously restored or reestablished.

RECORD OF DURABLE WITNESS MONUMENTS


MAGNETIC

NO	DESCRIPTION	BEARING	DISTANCE
1	SET A NAIL IN N.-SIDE OF AN 8-1/2" ASH	N 55° W	27.37 FT.
2	SET A NAIL IN W.-SIDE OF AN 11" BURR OAK	N 28° E	46.48 FT.
3	SET A NAIL IN S.-SIDE OF A DOUBLE BURR OAK	S 50° E	30.12 FT.
4	SET A NAIL IN W.-SIDE OF AN 11-1/2" BURR OAK	S 10° W	10.01 FT.

(NOT TO SCALE)

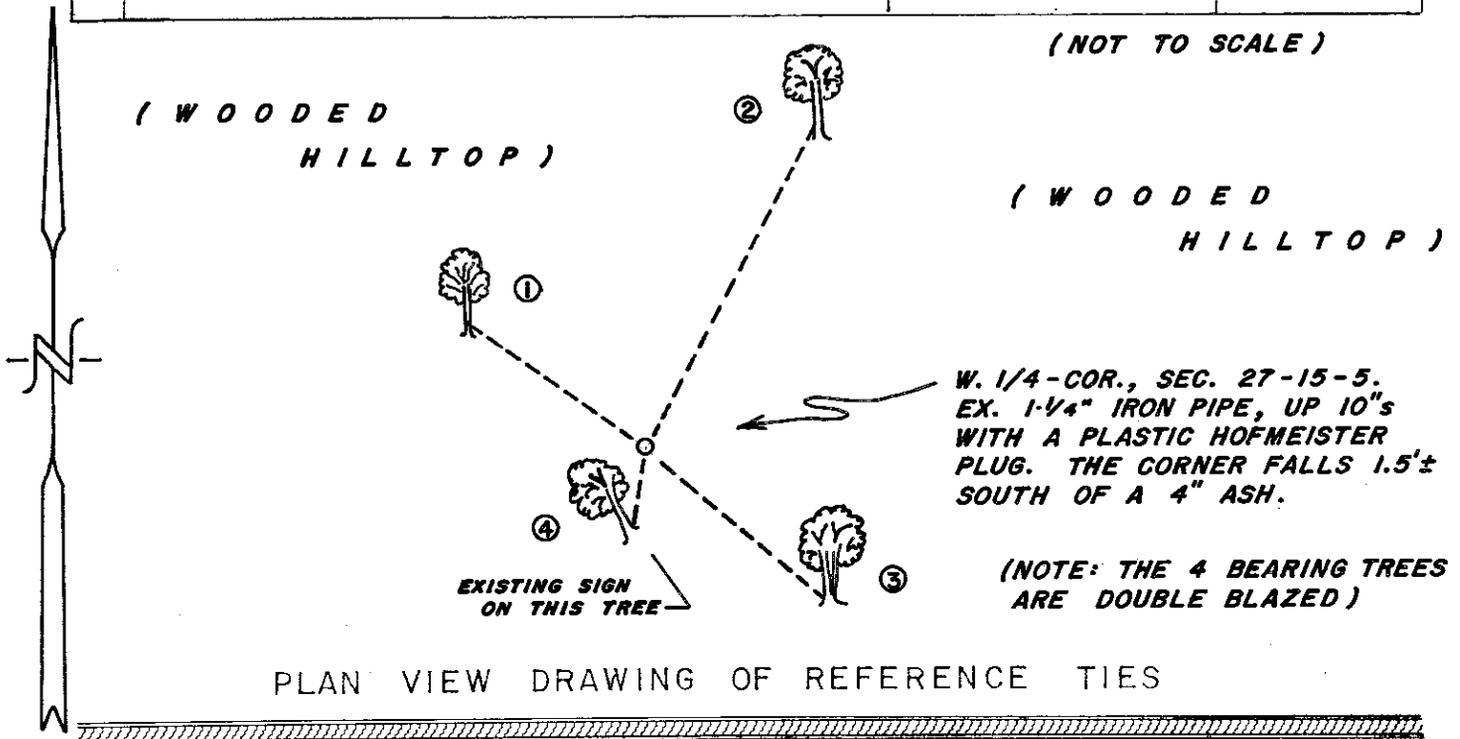


MAP SHOWING DISTANCE AND DIRECTION TO OTHER PUBLIC LAND SURVEY CORNERS USED FOR REESTABLISHING THE CORNER

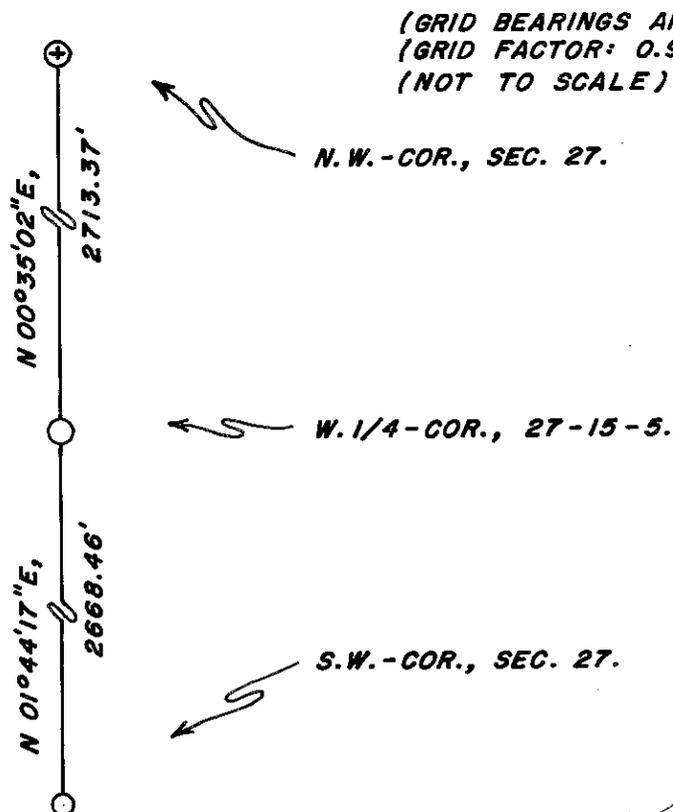

I, BRYAN H. MEYER, COUNTY SURVEYOR
HEREBY CERTIFY THAT THE CORNER LOCATION SHOWN ON THIS RECORD
WAS DETERMINED BY ME OR UNDER MY DIRECTION AND CONTROL AND
THAT THIS U. S. PUBLIC LAND SURVEY MONUMENT RECORD IS CORRECT
AND COMPLETE TO THE BEST OF MY KNOWLEDGE AND BELIEF.

Bryan H. Meyer
Signature

July 14, 2010
Date

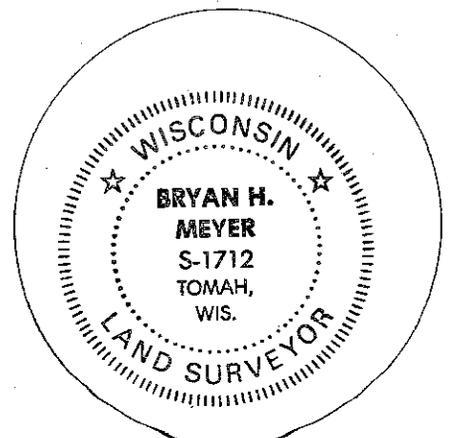


Seal

21505282000

U. S. PUBLIC LAND SURVEY MONUMENT RECORD

SECTION 27 T 15 N, R 5 W, TOWN OF WASHINGTON

LA CROSSE COUNTY

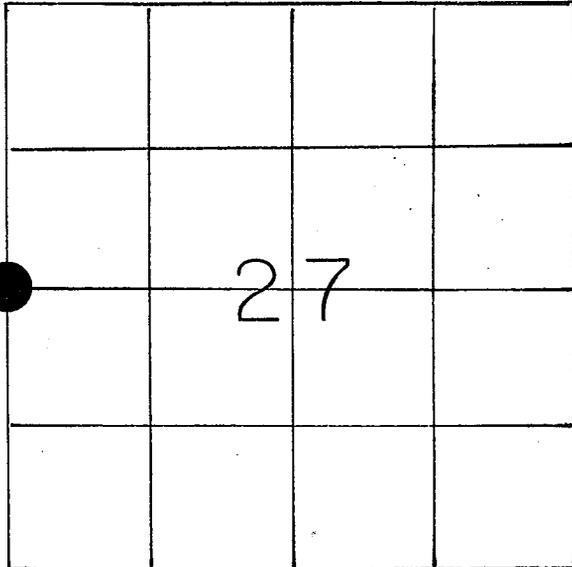

LOCATION OF LANDMARK

CREW: WILLIAM C. JUNG
PETER F. FOLLANSBEE

FEBRUARY 4, 1988

Describe any record evidence, monument evidence, testimonial evidence or any other material evidence you considered and whether the monument was found or restored through acceptance of an obliterated evidence location.

Greg Hofmeister set an iron pipe at this corner in 1982. I accepted this pipe as the best available evidence of the original government corner position.

Describe or show any material discrepancy between the location of the restored corner and that of the corner previously restored or reestablished.

(NONE KNOWN)

WISCONSIN COORDINATE SYSTEM

North

East

Theta Angle

Horiz. Order

Vert. Order

TYPE OF LANDMARK

FOUND 1 1/4" IRON PIPE, UP 10" ON W. SIDEHILL

BEARINGS ARE REFERENCED TO

TRUE NORTH


(as per Hofmeister survey)

RECORD OF DURABLE WITNESS MONUMENTS
MAGNETIC

NO	DESCRIPTION	BEARING	DISTANCE
1	SET P.K. NAIL IN 3" HICKORY (?) (DBL. BLAZED)	N 28°W	8.27 Ft.
2	SET P.K. NAIL IN 7" BURR OAK (DBL. BLAZED)	N 23°E	SL, 49.20 Ft.
3	SET P.K. NAIL IN 6" DBL. BURR OAK (DBL. BLAZED)	S 57°E	30.23 Ft.
4	SET P.K. NAIL IN 9" BURR OAK (DBL. BLAZED)	S 05°W	10.37 Ft.
5	FND P.K. NAIL IN SINGLE BLAZED BIRCH	WEST +	12.77 Ft.



WOODED HILLTOP

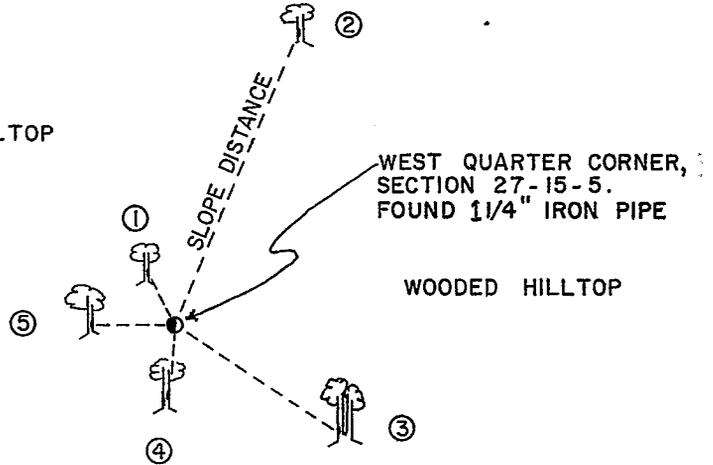


PLAN VIEW DRAWING OF REFERENCE TIES

MAP SHOWING DISTANCE AND DIRECTION TO OTHER PUBLIC LAND SURVEY CORNERS USED FOR REESTABLISHING THE CORNER

(NOT TO SCALE)


HOFMEISTER MEASUREMENT

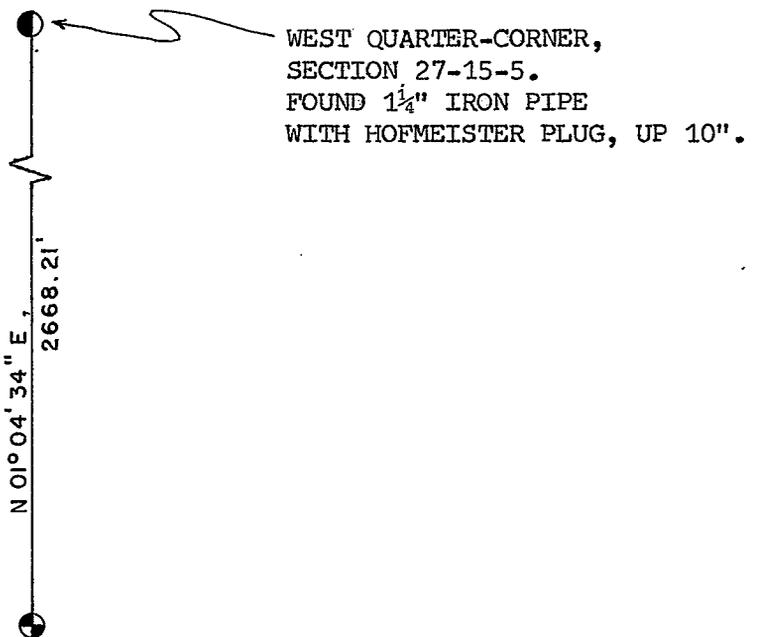

I, WILLIAM C. JUNG, DEPUTY COUNTY SURVEYOR,
HEREBY CERTIFY THAT THE CORNER LOCATION SHOWN ON THIS RECORD
WAS DETERMINED BY ME OR UNDER MY DIRECTION AND CONTROL AND
THAT THIS U. S. PUBLIC LAND SURVEY MONUMENT RECORD IS CORRECT
AND COMPLETE TO THE BEST OF MY KNOWLEDGE AND BELIEF.

William C. Jung
Signature

2/11/88
Date

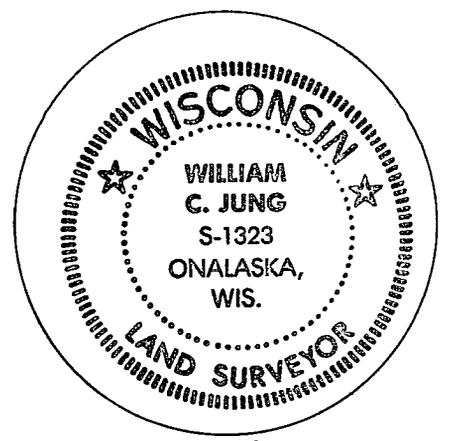

Seal