


U. S. PUBLIC LAND SURVEY MONUMENT RECORD

SECTION 33 T 15 N, R 5 W, TOWN OF WASHINGTON
 LA CROSSE COUNTY

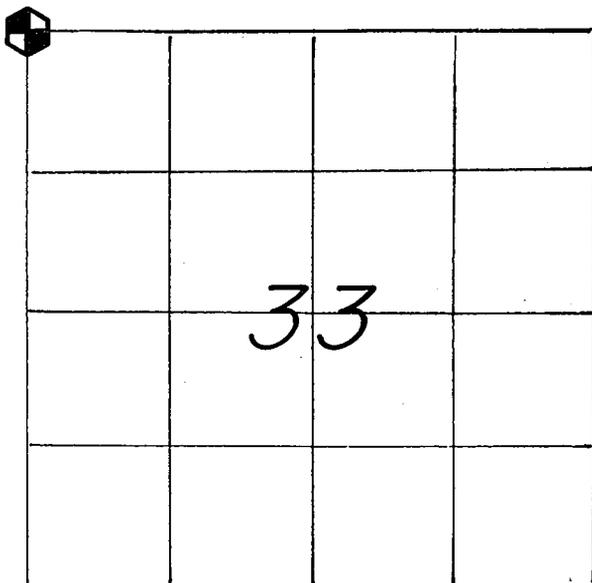

LOCATION OF LANDMARK

CREW: WILLIAM C. JUNG
 PETER F. FOLLANSBEE
 DATE: 4/25/2001

WISCONSIN COORDINATE SYSTEM	
North	635,685.285
East	1,706,604.774
Theta Angle	
Horiz. Order	
Vert. Order	
DATUM:	'83('91)
TYPE OF LANDMARK	
BRASS CAP LUNDE MARKER.	
BEARINGS ARE REFERENCED TO	
GRID NORTH AS PER SECTION DATA.	

Describe any record evidence, monument evidence, testimonial evidence or any other material evidence you considered and whether the monument was found or restored through acceptance of an obliterated evidence location.


The corner was set on line with the Southwest and S.1/16th-S.E. 1/4 corners of Section 29, and at a distance from the S.1/16-SE equal to 1/3rd of the distance between the aforesaid SW and S.1/16-SE corners. At the SW corner we had previously found an original bearing tree and original line tree. At the S.1/16-SE corner we found the "mound of stone" called for by Middlebrook in his 1876 survey. In my opinion this computed location best fits the section data and evidence in all four directions. Double proportionate measurement would not be appropriate in this situation. This falls very close to where Vince Hundt, the land owner to the NE, thought the corner was. The corner was monumented with a Lunde marker.

Describe or show any material discrepancy between the location of the restored corner and that of the corner previously restored or reestablished.

NONE KNOWN.


RECORD OF DURABLE WITNESS MONUMENTS
MAGNETIC

NO	DESCRIPTION	BEARING	DISTANCE
1	SET A NAIL IN S.E.-SIDE OF AN OLD APPLE TREE	N 42° E	60.85 FT.
2	SET A NAIL IN W.-SIDE OF A SMALL ASH?	S 27° E	22.62 FT.
3	SET A NAIL IN E.-SIDE OF A SMALL ASH?	S 19° W	33.66 FT.
4	SET A NAIL IN S.E.-SIDE OF A SMALL ASH?	S 39° W	51.11 FT.

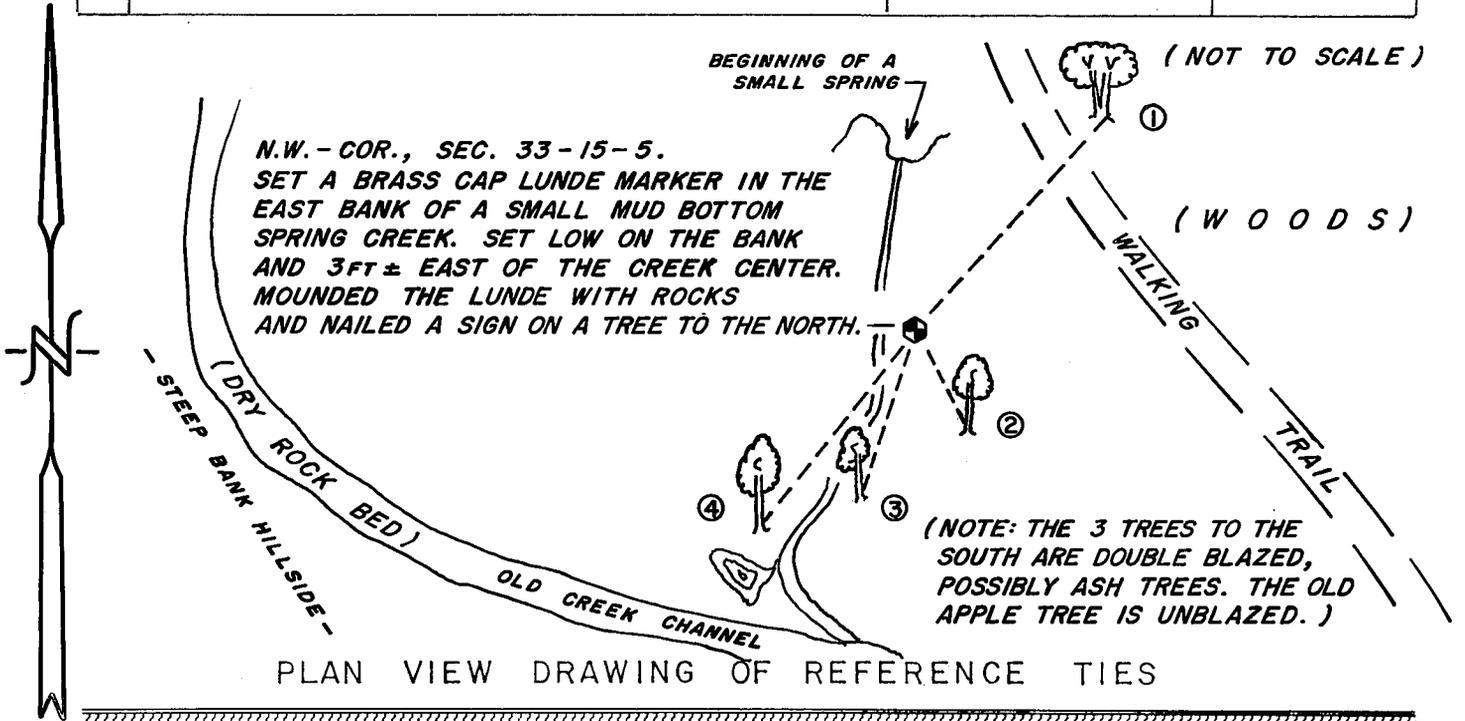

MAP SHOWING DISTANCE AND DIRECTION TO OTHER PUBLIC LAND SURVEY CORNERS USED FOR REESTABLISHING THE CORNER

(GRID BEARINGS AND DISTANCES)
(GRID FACTOR: 0.999898977)

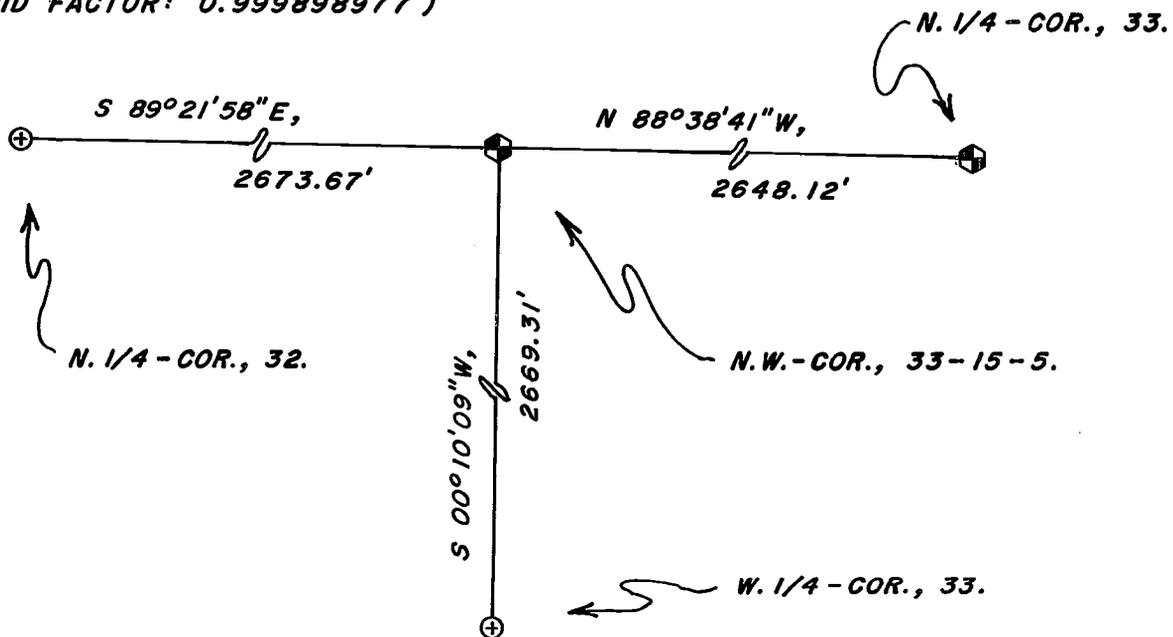

I, WILLIAM C. JUNG, COUNTY SURVEYOR
HEREBY CERTIFY THAT THE CORNER LOCATION SHOWN ON THIS RECORD WAS DETERMINED BY ME OR UNDER MY DIRECTION AND CONTROL AND THAT THIS U. S. PUBLIC LAND SURVEY MONUMENT RECORD IS CORRECT AND COMPLETE TO THE BEST OF MY KNOWLEDGE AND BELIEF.

William C. Jung 7/9/01
Signature Date



Seal