


U. S. PUBLIC LAND SURVEY MONUMENT RECORD

SECTION 31 T 15 N, R 5 W, TOWN OF WASHINGTON

LA CROSSE COUNTY

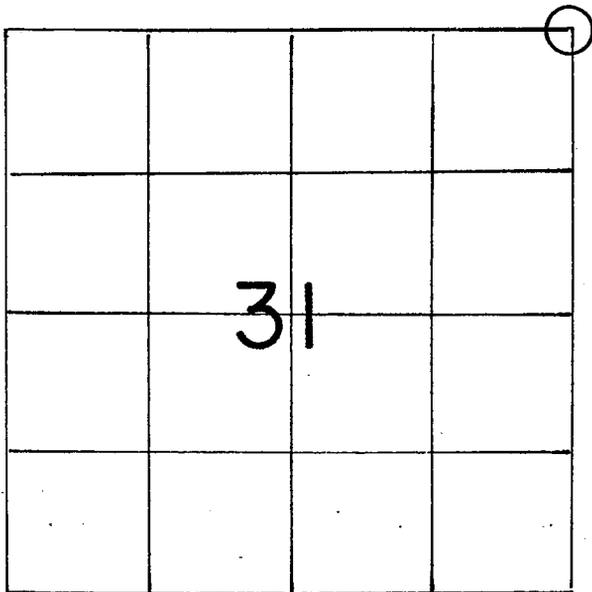

LOCATION OF LANDMARK

Crew: WILLIAM C. JUNG
PETER F. FOLLANSBEE

Date: 3/23/1995

Describe any record evidence, monument evidence, testimonial evidence or any other material evidence you considered and whether the monument was found or restored through acceptance of an obliterated evidence location.

I found what I believe to be an original government line tree to the South and an original government bearing tree to the Southwest. Coming off the tree to the Southwest, the line tree to the South fits as does the old fence to the South. The trees are both living and what I thought would be the correct size. I set a Lunde at the corner. The white oak 102.83 feet to the East fits the original notes for species and distance, but the bearing is off some. The tree size also seems a bit small. It ***** Describe or show any material discrepancy between the location of the restored corner and that of the corner previously restored or reestablished.

None Known.

*****could be an original though.

WISCONSIN COORDINATE SYSTEM

North

East

Theta Angle

Horiz. Order

Vert. Order

TYPE OF LANDMARK

Set brass cap Lunde marker.


BEARINGS ARE REFERENCED TO

Grid North.

RECORD OF DURABLE WITNESS MONUMENTS


MAGNETIC

NO	DESCRIPTION	BEARING	DISTANCE
1	Set P.K. Nail in N.-side 26" White Oak	S 60° W	12.41 Ft.
2	Set P.K. Nail in S.-side 12" White Oak	N 70° E	55.72 Ft.
3	Set P.K. Nail in S.-side 23" White Oak	N 89° E	102.83 Ft.
4	Set P.K. Nail in NE-side 3½" Hickory(unblazed)	S 08° E	29.94 Ft.

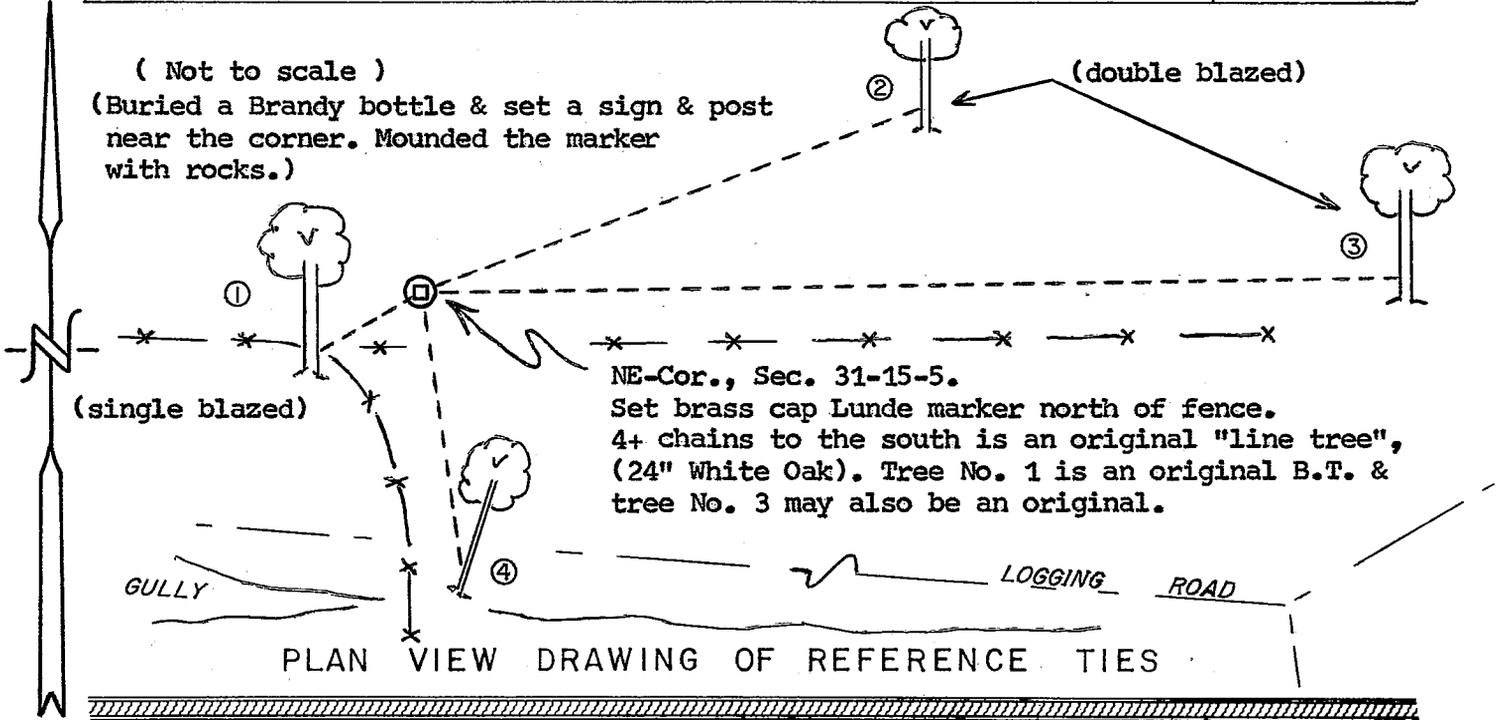

MAP SHOWING DISTANCE AND DIRECTION TO OTHER PUBLIC LAND SURVEY CORNERS USED FOR REESTABLISHING THE CORNER

(Not to scale)

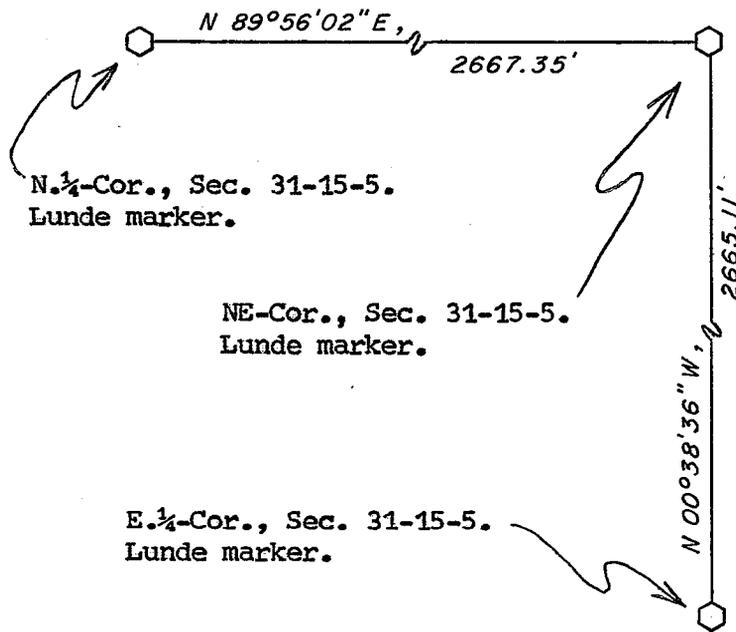

I, William C. Jung, County Surveyor
 HEREBY CERTIFY THAT THE CORNER LOCATION SHOWN ON THIS RECORD WAS DETERMINED BY ME OR UNDER MY DIRECTION AND CONTROL AND THAT THIS U. S. PUBLIC LAND SURVEY MONUMENT RECORD IS CORRECT AND COMPLETE TO THE BEST OF MY KNOWLEDGE AND BELIEF.

William C. Jung
 Signature

3/31/95
 Date



Seal