


21505302020

U. S. PUBLIC LAND SURVEY MONUMENT RECORD

SECTION 30 T 15 N, R 5 W, TOWN OF WASHINGTON

LA CROSSE COUNTY

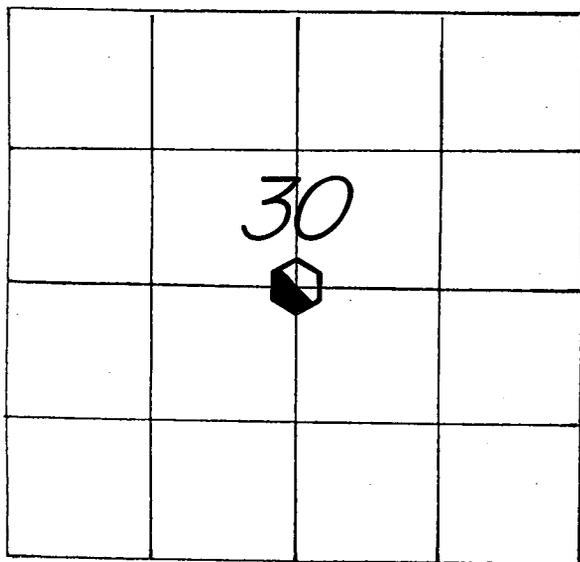

LOCATION OF LANDMARK

CREW: **WILLIAM C. JUNG**
PETER F. FOLLANSBEE
 DATE: 10/03/2007

WISCONSIN COORDINATE SYSTEM	
North	638,392.706
East	1,698,653.903
Theta Angle	
Horiz. Order	
Vert. Order	
DATUM:	1983('91)
TYPE OF LANDMARK	
30" ALUMINUM BERNTSEN MARKER.	
BEARINGS ARE REFERENCED TO	
GRID NORTH AS PER SECTION DATA.	

Describe any record evidence, monument evidence, testimonial evidence or any other material evidence you considered and whether the monument was found or restored through acceptance of an obliterated evidence location.

Mike Lydon set an iron bar at this corner in 2006. We found his iron bar, removed it, and replaced it with a Berntsen marker. Middlebrook set a stone at this corner in June of 1876. We searched three times for this stone but could not find it. The stone was probably destroyed in the 1970's when the Rundahls were bulldozing from here to the North.

Describe or show any material discrepancy between the location of the restored corner and that of the corner previously restored or reestablished.

NONE KNOWN.

