


U. S. PUBLIC LAND SURVEY MONUMENT RECORD

SECTION 32 T 15 N, R 5 W, TOWN OF WASHINGTON

LA CROSSE COUNTY

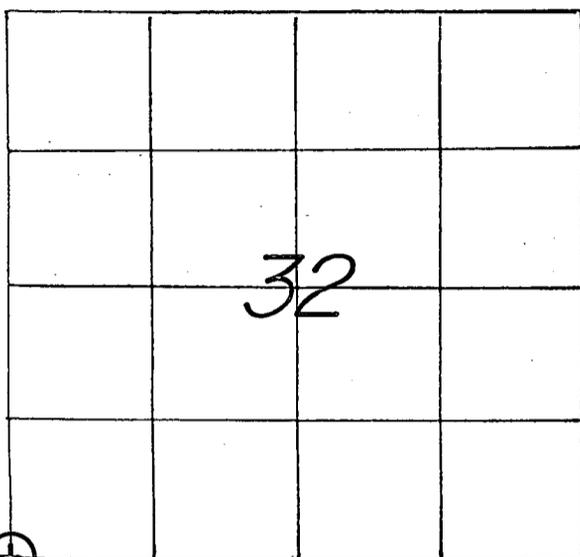

LOCATION OF LANDMARK

CREW: **WILLIAM G. JUNG**
PETER F. FOLLANSBEE
 DATE: **11/01/2006**

WISCONSIN COORDINATE SYSTEM

North **630,423.877**East **1,701,345.124**

Theta Angle

Horiz. Order

Vert. Order

DATUM: **1983('91)**

TYPE OF LANDMARK

3/4" x 30" IRON BAR WITH AN ALUMINUM CAP.

BEARINGS ARE REFERENCED TO

GRID NORTH AS PER SECTION DATA.

Describe any record evidence, monument evidence, testimonial evidence or any other material evidence you considered and whether the monument was found or restored through acceptance of an obliterated evidence location.

Uriah Briggs set a wood post for the original government corner in 1845. Middlebrook, the LaCrosse County Surveyor, found Briggs' corner in 1876. William Knowler, the Vernon County Surveyor, found Briggs' corner in 1888. In 1995 I found what I believe was the remains of Knowler's bearing tree to the Southwest. I found the tree downed and rotted with a stump depression. I set a flathead bolt at the corner using Knowler's call. I removed our bolt from 1995 and replaced it with an iron bar and cap and mounded it with rocks.


Describe or show any material discrepancy between the location of the restored corner and that of the corner previously restored or reestablished.

NONE KNOWN.

RECORD OF DURABLE WITNESS MONUMENTS

NO	DESCRIPTION	MAGNETIC	
		BEARING	DISTANCE
1	EX. P.K. NAIL IN N.-SIDE OF A 7" HICKORY	S 65° W	4.55 FT.
2	SET A NAIL IN W.-SIDE OF A 4-3/4" WHITE OAK	N 01° E	21.66 FT.
3	SET A NAIL IN N.W.-SIDE OF A 7-1/2" HICKORY	N 22° E	27.16 FT.
4	EX. P.K. NAIL IN S.W.-SIDE OF A 16" OAK	S 35° E	6.02 FT.


(NOTE: THE FOUR BEARING TREES ARE DOUBLE BLAZED.)

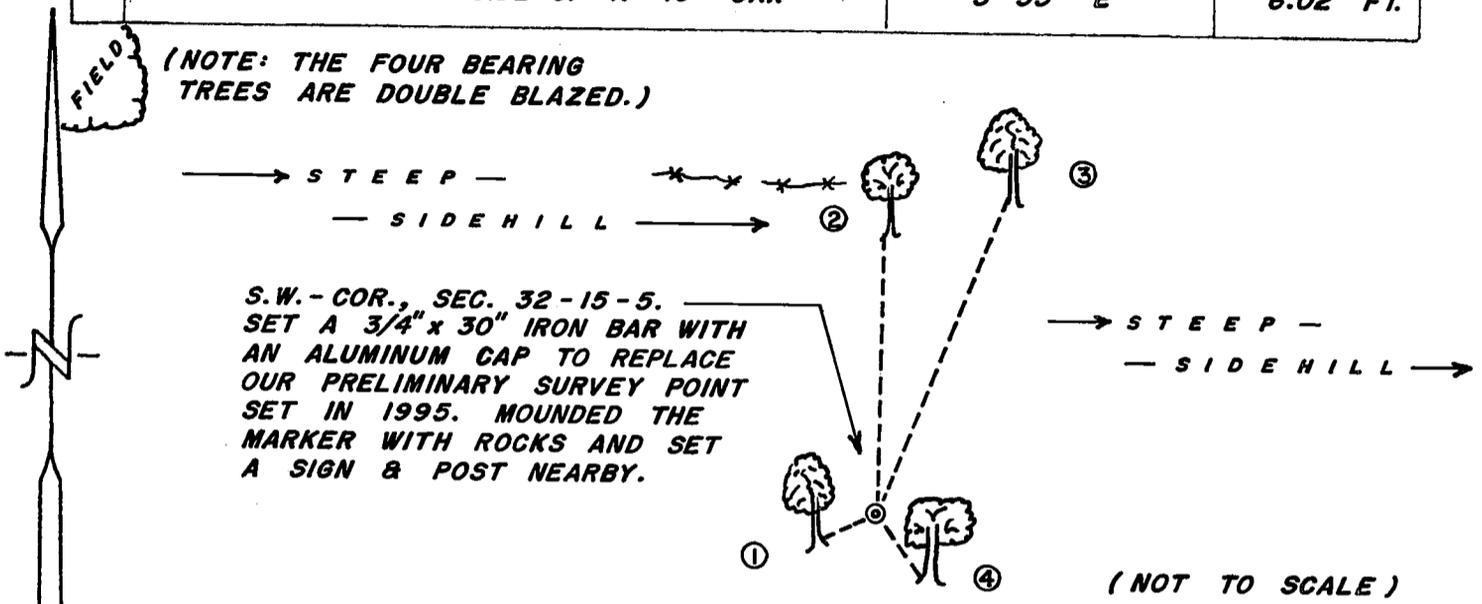

PLAN VIEW DRAWING OF REFERENCE TIES

MAP SHOWING DISTANCE AND DIRECTION TO OTHER PUBLIC LAND SURVEY CORNERS USED FOR REESTABLISHING THE CORNER

(GRID BEARINGS AND DISTANCES)
 (GRID FACTOR: 0.999895)
 (NOT TO SCALE)

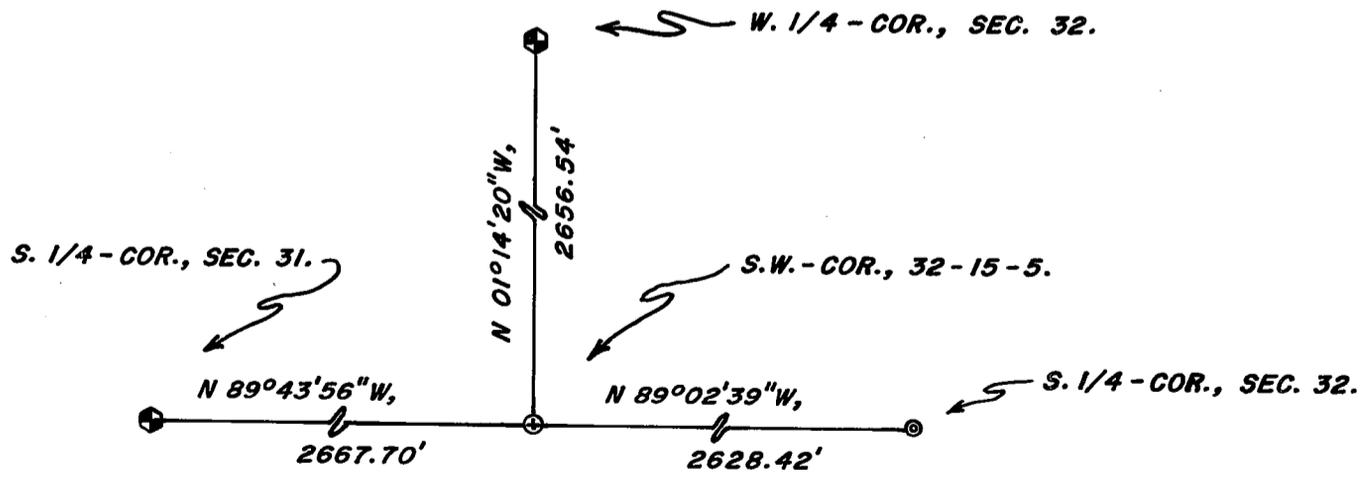

I, WILLIAM G. JUNG, COUNTY SURVEYOR
 HEREBY CERTIFY THAT THE CORNER LOCATION SHOWN ON THIS RECORD WAS DETERMINED BY ME OR UNDER MY DIRECTION AND CONTROL AND THAT THIS U. S. PUBLIC LAND SURVEY MONUMENT RECORD IS CORRECT AND COMPLETE TO THE BEST OF MY KNOWLEDGE AND BELIEF.

William G. Jung 11/20/06
 Signature Date



Seal