


U. S. PUBLIC LAND SURVEY MONUMENT RECORD

SECTION 34 T 15 N, R 5 W, TOWN OF Washington

LA CROSSE COUNTY

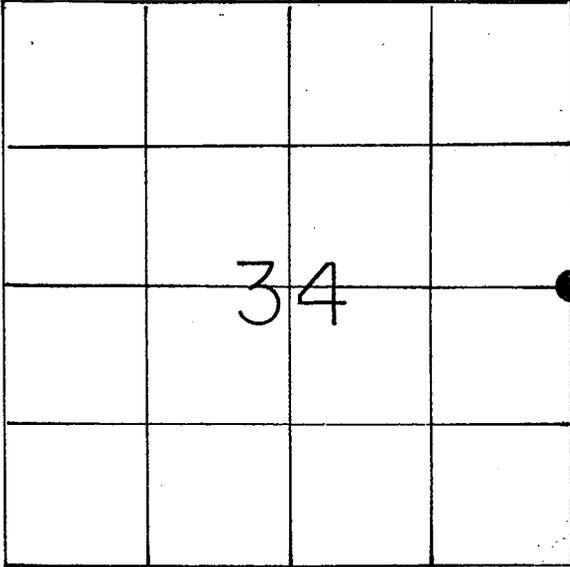

LOCATION OF LANDMARK

WISCONSIN COORDINATE SYSTEM

North

East

Theta Angle

Horiz. Order

Vert. Order

TYPE OF LANDMARK

Brass capped Lunde marker ***

BEARINGS ARE REFERENCED TO

Assumed

Crew: William C. Jung

Peter F. Follansbee

Date: 2/17/88

Crew: William C. Jung

Peter F. Follansbee

Date: 3/13/07

Describe any record evidence, monument evidence, testimonial evidence or any other material evidence you considered and whether the monument was found or restored through acceptance of an obliterated evidence location.

I set the corner "as per law", equidistant and on line between the section corners.

Describe or show any material discrepancy between the location of the restored corner and that of the corner previously restored or reestablished.


None known.

*** Revised: August 4, 1988

I mounded the marker with rocks on 6/27/88. A line of steel fence posts bears about N54°W from the corner. I don't know who put them in. They were not in last winter.

RECORD OF DURABLE WITNESS MONUMENTS


NO	DESCRIPTION	MAGNETIC	
		BEARING	DISTANCE
1	P.K. nail in double blazed 29" 29" black oak	S55°W	11.77
2	P.K. nail in double blazed 26" 32" white oak	N77°W	slope=46.34
3	P.K. set nail in double blazed 7" 6" aspen	N15°W N29°W	33.84 33.33
4	P.K. nail in double blazed 14" 18" white oak	N48°E	19.75

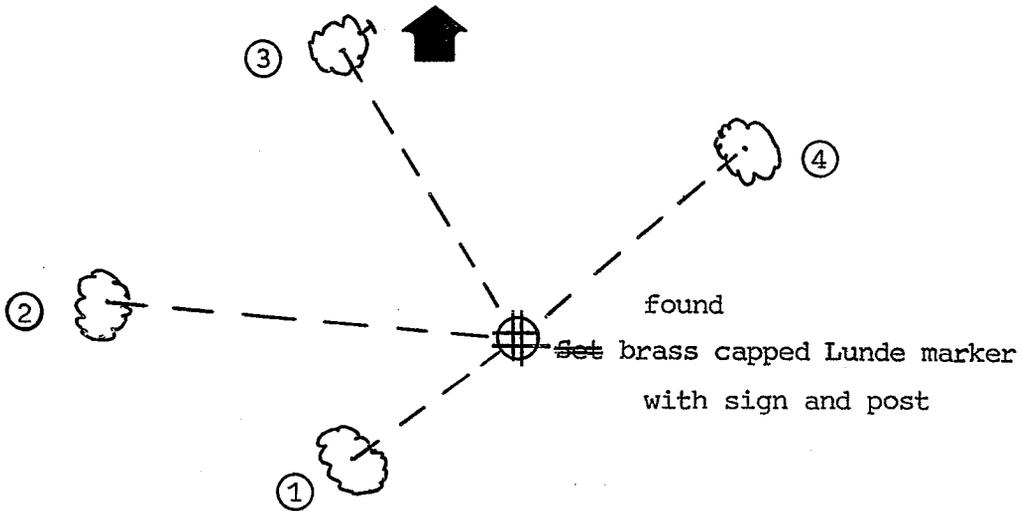

PLAN VIEW DRAWING OF REFERENCE TIES

MAP SHOWING DISTANCE AND DIRECTION TO OTHER PUBLIC LAND SURVEY CORNERS USED FOR REESTABLISHING THE CORNER


(not to scale)

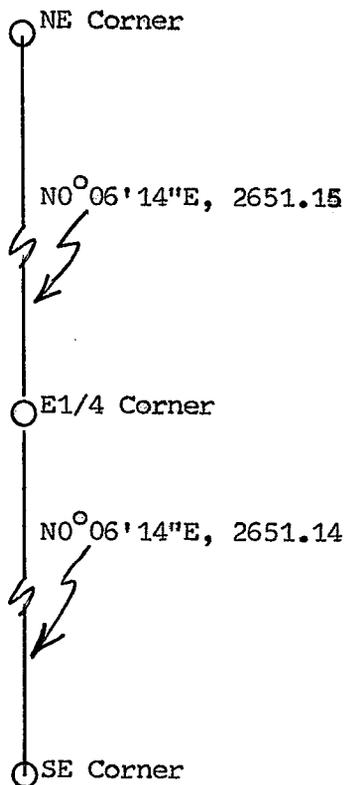

I, William C. Jung, ~~Deputy~~ County Surveyor
 HEREBY CERTIFY THAT THE CORNER LOCATION SHOWN ON THIS RECORD
 WAS DETERMINED BY ME OR UNDER MY DIRECTION AND CONTROL AND
 THAT THIS U. S. PUBLIC LAND SURVEY MONUMENT RECORD IS CORRECT
 AND COMPLETE TO THE BEST OF MY KNOWLEDGE AND BELIEF.

William C. Jung
 Signature

2/19/88
 Date
 Revised: 3/22/07

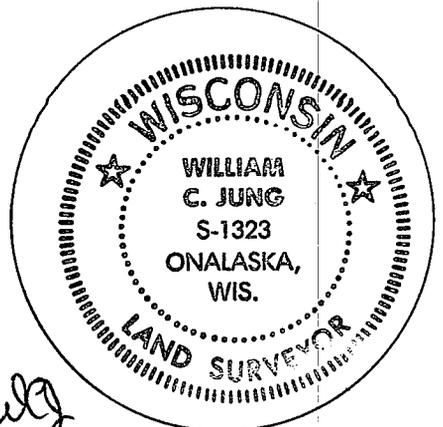

Seal