


U. S. PUBLIC LAND SURVEY MONUMENT RECORD

SECTION 35 T 15 N, R 5 W, TOWN OF WASHINGTON

LA CROSSE COUNTY

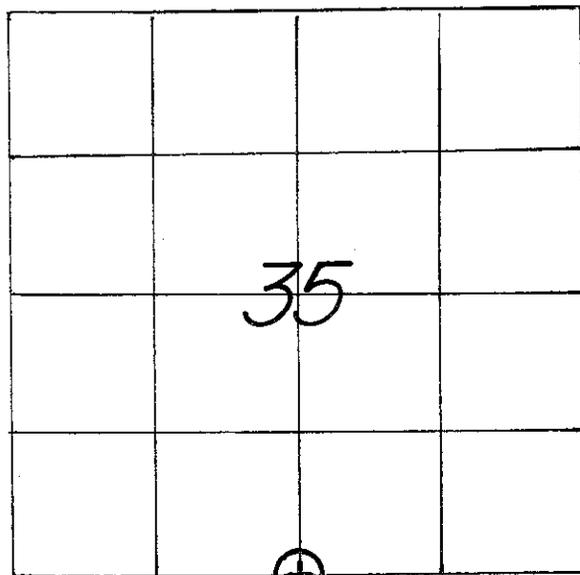

LOCATION OF LANDMARK

CREW: **BRYAN H. MEYER**
PETER F. FOLLANSBEE
 DATE: **9/03/2009**

WISCONSIN COORDINATE SYSTEM	
North	630,218.831
East	1,719,833.897
Theta Angle	
Horiz. Order	
Vert. Order	
DATUM:	NAD 1983 ('91)

TYPE OF LANDMARK
3/4" x 30" IRON BAR WITH AN ALUMINUM CAP.

BEARINGS ARE REFERENCED TO
GRID NORTH AS PER SECTION DATA.

Describe any record evidence, monument evidence, testimonial evidence or any other material evidence you considered and whether the monument was found or restored through acceptance of an obliterated evidence location.


Describe or show any material discrepancy between the location of the restored corner and that of the corner previously restored or reestablished.

RECORD OF DURABLE WITNESS MONUMENTS

MAGNETIC


NO	DESCRIPTION	BEARING	DISTANCE
1	SET A NEW NAIL IN N.W.-SIDE OF A 20" WILLOW	S 80° W	35.72 FT.
2	SET A RAILROAD SPIKE IN THE ROAD CENTERLINE	N 08° E	80.09 FT.
3	EX. CHISELLED CROSS ON N.E.-COR. OF BRIDGE ABUTMENT	S 18° E	57.50 FT.
4	EX. P.K. NAIL IN THE CENTERLINE AT N.-END OF BRIDGE	S.'EASTERLY ±	55.01 FT.

(NOT TO SCALE)

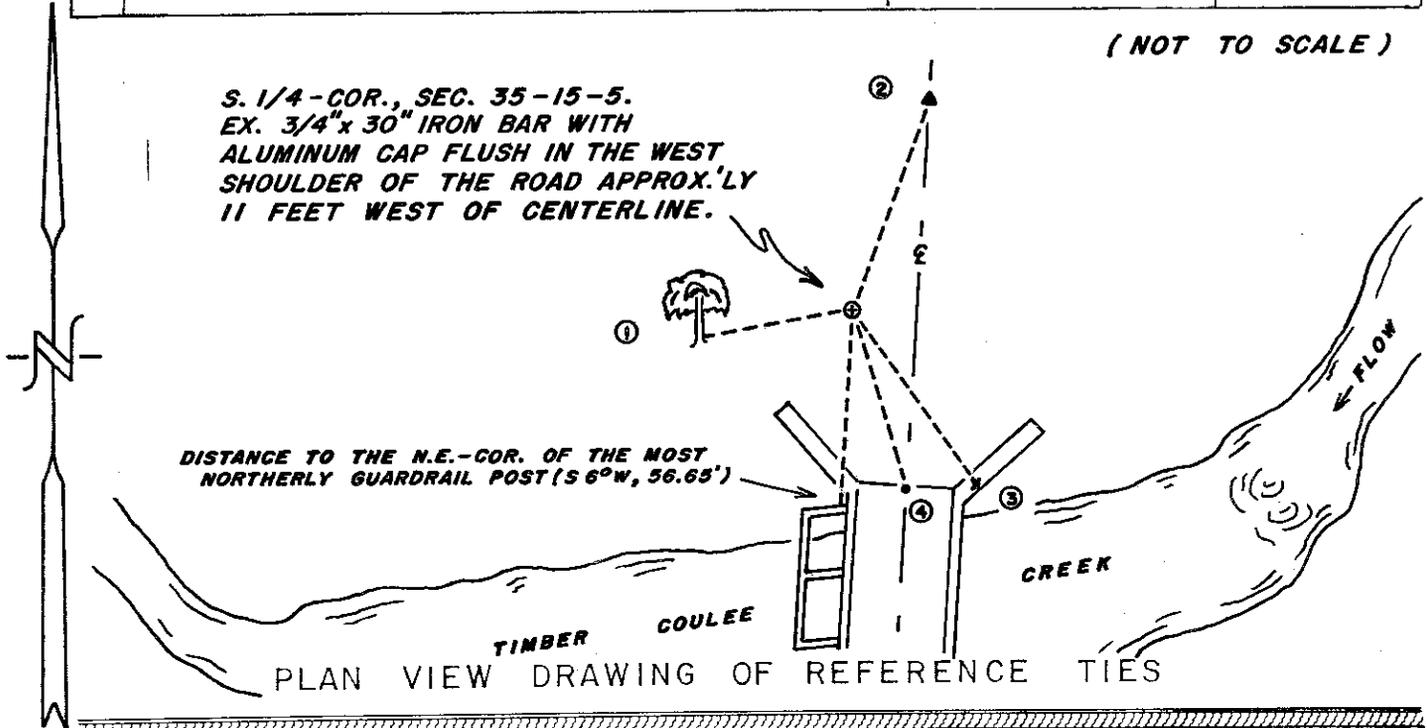


MAP SHOWING DISTANCE AND DIRECTION TO OTHER PUBLIC LAND SURVEY CORNERS USED FOR REESTABLISHING THE CORNER

(GRID BEARINGS AND DISTANCES)
 (GRID FACTOR: 0.999898977)
 (NOT TO SCALE)

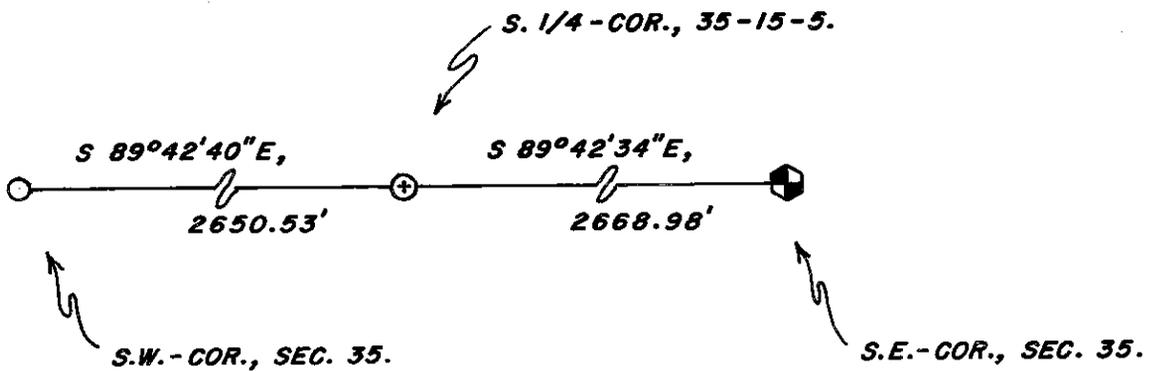


I, BRYAN H. MEYER, COUNTY SURVEYOR
 HEREBY CERTIFY THAT THE CORNER LOCATION SHOWN ON THIS RECORD
 WAS DETERMINED BY ME OR UNDER MY DIRECTION AND CONTROL AND
 THAT THIS U. S. PUBLIC LAND SURVEY MONUMENT RECORD IS CORRECT
 AND COMPLETE TO THE BEST OF MY KNOWLEDGE AND BELIEF.

Bryan H. Meyer 7/14/2010
 Signature Date

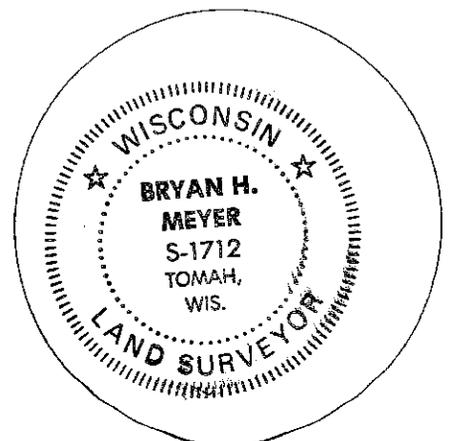

U. S. PUBLIC LAND SURVEY MONUMENT RECORD

SECTION 35 T 15 N, R 5 W, TOWN OF WASHINGTON
 LA CROSSE COUNTY

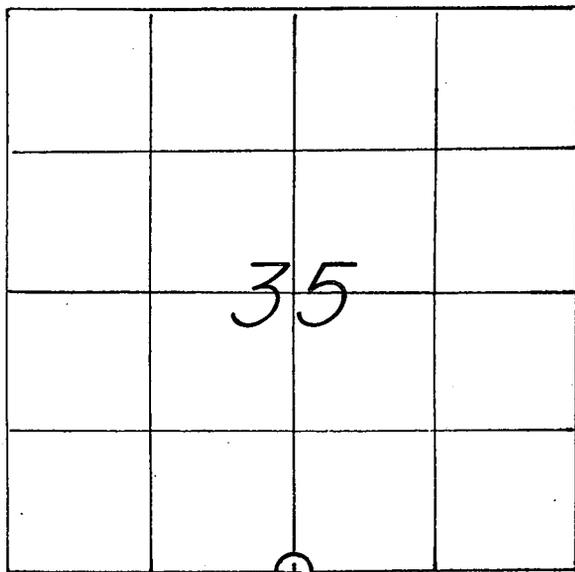

WISCONSIN COORDINATE SYSTEM
North
East
Theta Angle
Horiz. Order
Vert. Order
TYPE OF LANDMARK
3/4" x 30" IRON BAR WITH ALUMINUM CAP.
BEARINGS ARE REFERENCED TO
ASSUMED NORTH.

LOCATION OF LANDMARK
 CREW: WILLIAM C. JUNG
 PETER F. FOLLANSBEE
 DATE: 12/15/1997

Describe any record evidence, monument evidence, testimonial evidence or any other material evidence you considered and whether the monument was found or restored through acceptance of an obliterated evidence location.


The corner was set on line between the section corners and at distances from the section corners proportional to those recorded by Khowr in 1883. This fits the field evidence very well. I set an iron bar with a cap at the corner.

Describe or show any material discrepancy between the location of the restored corner and that of the corner previously restored or reestablished.

None known.


RECORD OF DURABLE WITNESS MONUMENTS
(1-3) Magnetic

NO	DESCRIPTION	BEARING	DISTANCE
1	SET A NAIL IN THE NW-SIDE 16" WILLOW (UNBLAZED)	S 80° W	35.97 FT.
2	SET A NAIL IN THE SW-SIDE 14" ELM (UNBLAZED)	N 28° W	SLOPE= 128.50'
3	CHISELLED CROSS (+) ON NE-COR. OF BRIDGE ABUTMENT	S 18° E	57.50 FT.
4	SET A P.K. NAIL IN THE CENTERLINE AT N-END OF BRIDGE	S.'EASTERLY ±	55.01 FT.

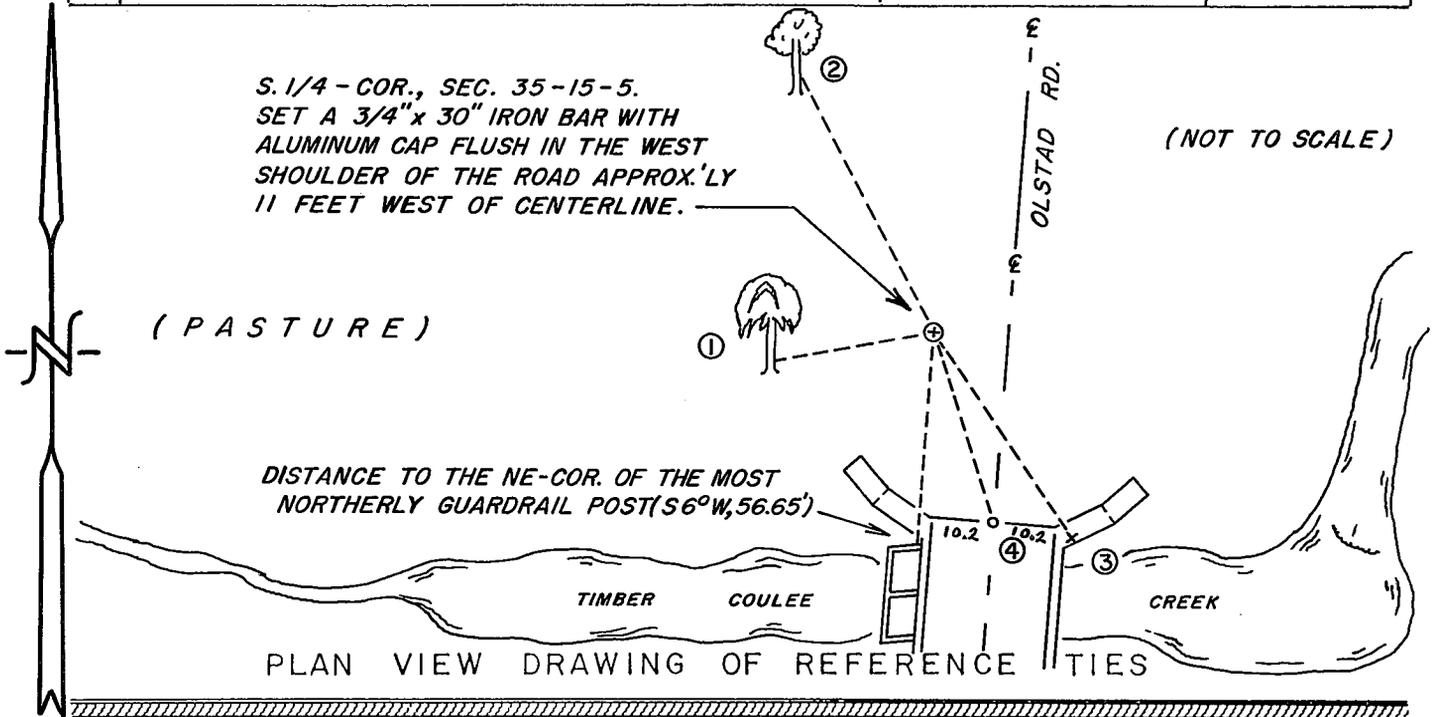

MAP SHOWING DISTANCE AND DIRECTION TO OTHER PUBLIC LAND SURVEY CORNERS USED FOR REESTABLISHING THE CORNER

(not to scale)

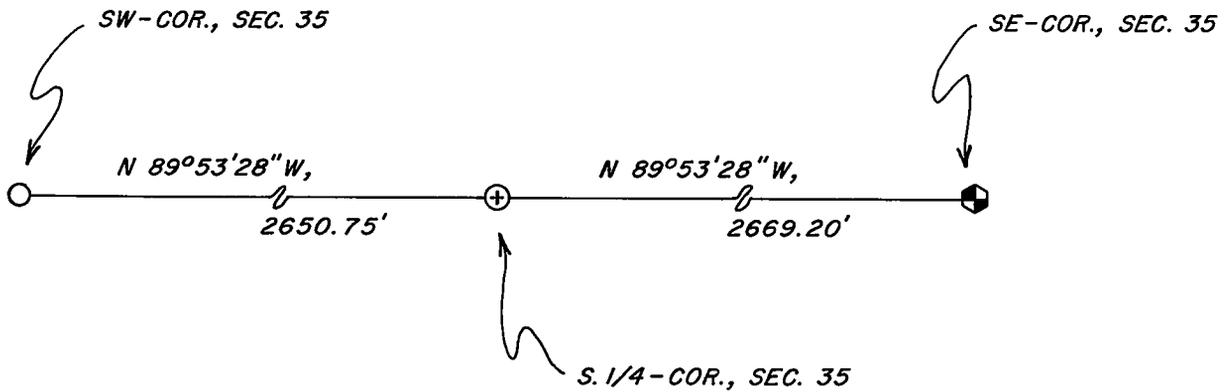

I, WILLIAM C. JUNG, COUNTY SURVEYOR
HEREBY CERTIFY THAT THE CORNER LOCATION SHOWN ON THIS RECORD WAS DETERMINED BY ME OR UNDER MY DIRECTION AND CONTROL AND THAT THIS U. S. PUBLIC LAND SURVEY MONUMENT RECORD IS CORRECT AND COMPLETE TO THE BEST OF MY KNOWLEDGE AND BELIEF.

William C. Jung
Signature

March 12, 1998
Date

