

CERTIFICATE

CERTIFIED LAND CORNER

SE-36-15-5

#157

No. 133

21505360000

History of corner establishment since Original Government Survey

No recorded history for this corner was found in the LaCrosse, Vernon or Monroe County records. F. Curtis Crook, Registered Land Surveyor from Readstown informed the Monroe County Surveyor's Office that he had completed some survey work in this area and had established a computed location for this corner. Description of corner evidence found:

I set this corner at Mr. Crook's computed location using his traverse points. I spoke with Mr. William Jung, LaCrosse County Surveyor and Mr. Gary Sime, Monroe County surveyor and both agreed with me that this was a good location for this corner.



Bryan H. Meyer  
H. A. Sime and Associates  
P. O. Box 50  
Tomah, Wisconsin 54660  
Phone: (608)-372-5392

I, Bryan H. Meyer, do hereby certify that on the 18th day of November 19 97, I found ~~evidence~~ (no evidence) of the Southwest corner of Section 31, T 15 N, R 4 W Fourth Principal Meridian, and I re-established said corner according to the Wisconsin Statutes as shown and described hereon.

Dated this 30th day of March 19 98.

Bryan H. Meyer  
Deputy County Surveyor  
Title



Description of corner and witness monuments, references and accessories used to perpetuate the original or re-established location of this corner:

Date: November 18, 1997 - 11:00 am NOTE: The bearings shown are magnetic  
Weather: Clear, calm, 30°±

Witnesses to corner location:

Bryan H. Meyer

Douglas J. Malliet

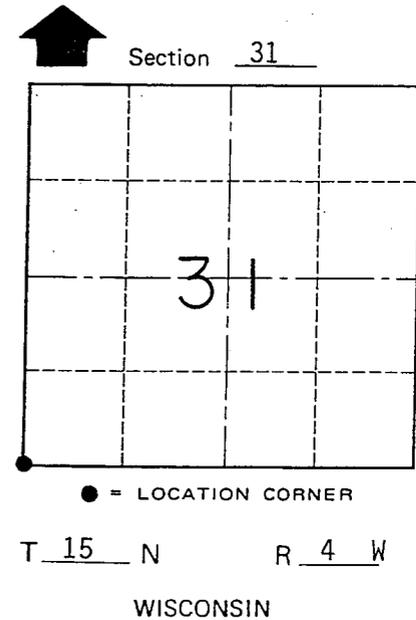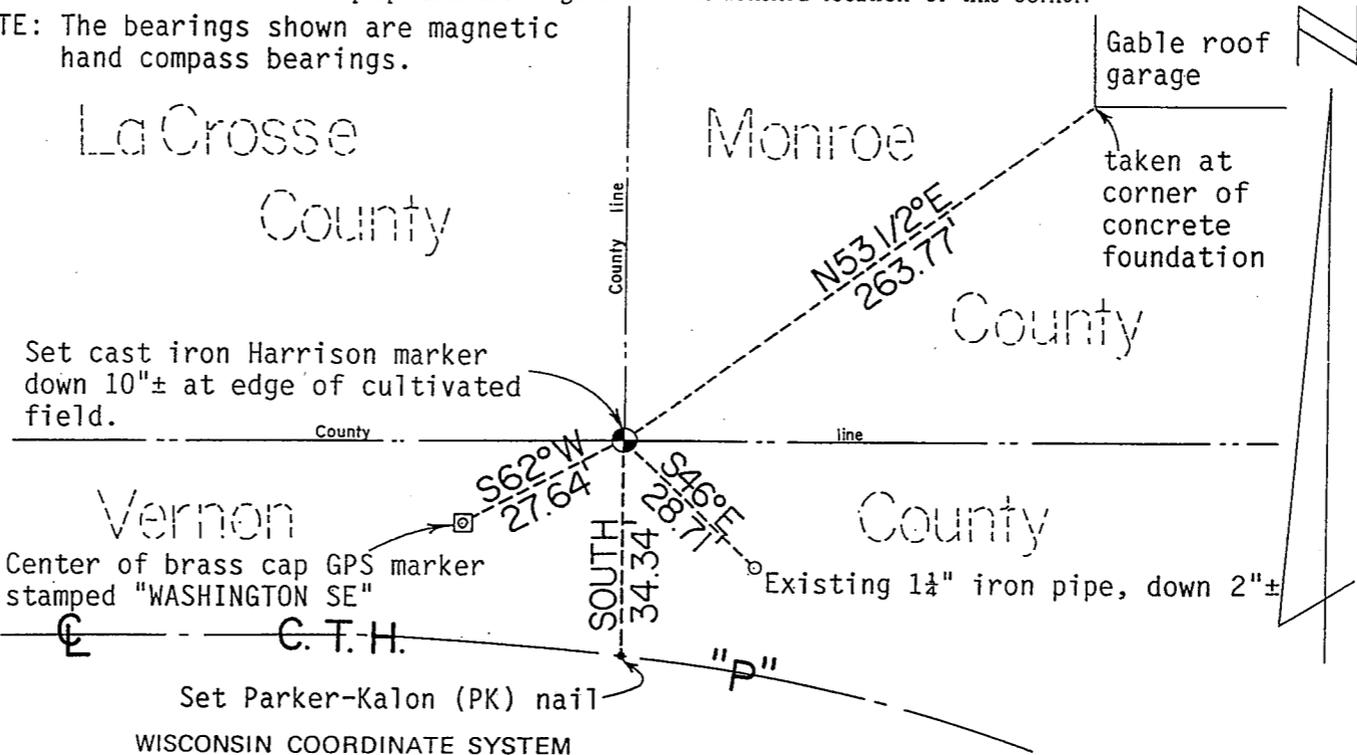

COUNTY SURVEYOR FORM NO. 1

No. 157

215051360000

SURVEY CONTROL ORDER

Horizontal	_____
Vertical	_____

Corner	East (X)	North (Y)	Elevation (Z)	Zone
Control Sta. Name				

City, Village or Town of Portland  
County of Monroe