


U. S. PUBLIC LAND SURVEY MONUMENT RECORD

SECTION 36 T 15 N, R 5 W, TOWN OF WASHINGTON
LA CROSSE COUNTY

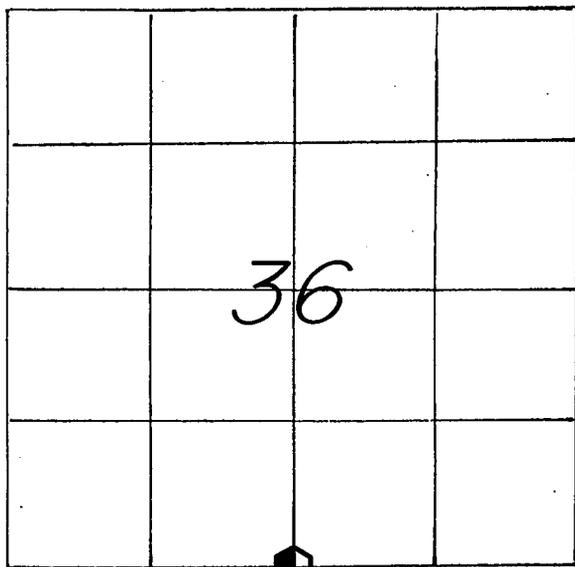

LOCATION OF LANDMARK

CREW: WILLIAM C. JUNG
PETER F. FOLLANSBEE
DATE: 12/08/1997

WISCONSIN COORDINATE SYSTEM
North
East
Theta Angle
Horiz. Order
Vert. Order
TYPE OF LANDMARK
BRASS CAP LUNDE MARKER.
BEARINGS ARE REFERENCED TO
ASSUMED NORTH.

Describe any record evidence, monument evidence, testimonial evidence or any other material evidence you considered and whether the monument was found or restored through acceptance of an obliterated evidence location.


I set the corner on line with the section corners and in the North-South line fence. After studying Knower's old notes, the original notes, and field evidence, I feel that this is the best solution. I set a brass capped Lunde marker at the corner. I accepted the line fence to the North as the best available evidence of the old line run.

Describe or show any material discrepancy between the location of the restored corner and that of the corner previously restored or reestablished.


None known.

RECORD OF DURABLE WITNESS MONUMENTS

NO	DESCRIPTION	BEARING	DISTANCE
1	SET 7/8" x 17" IRON BAR 7'± N. OF PAV'NT EDGE, DOWN 2"s.	S.' WESTERLY	31.83 FT.
2	SET 1" x 28" IRON PIPE 4'± EAST OF FENCE, DOWN 2"s.	NORTHERLY	33.10 FT.
3	SET 18" ROUNDHEAD BOLT 7'± N. OF PAV'NT EDGE, DOWN 2"s.	S.' EASTERLY	32.39 FT.
4	EXISTING IRON BAR IN THE ROAD CENTERLINE.	S 00°11'08"E	27.50 FT.

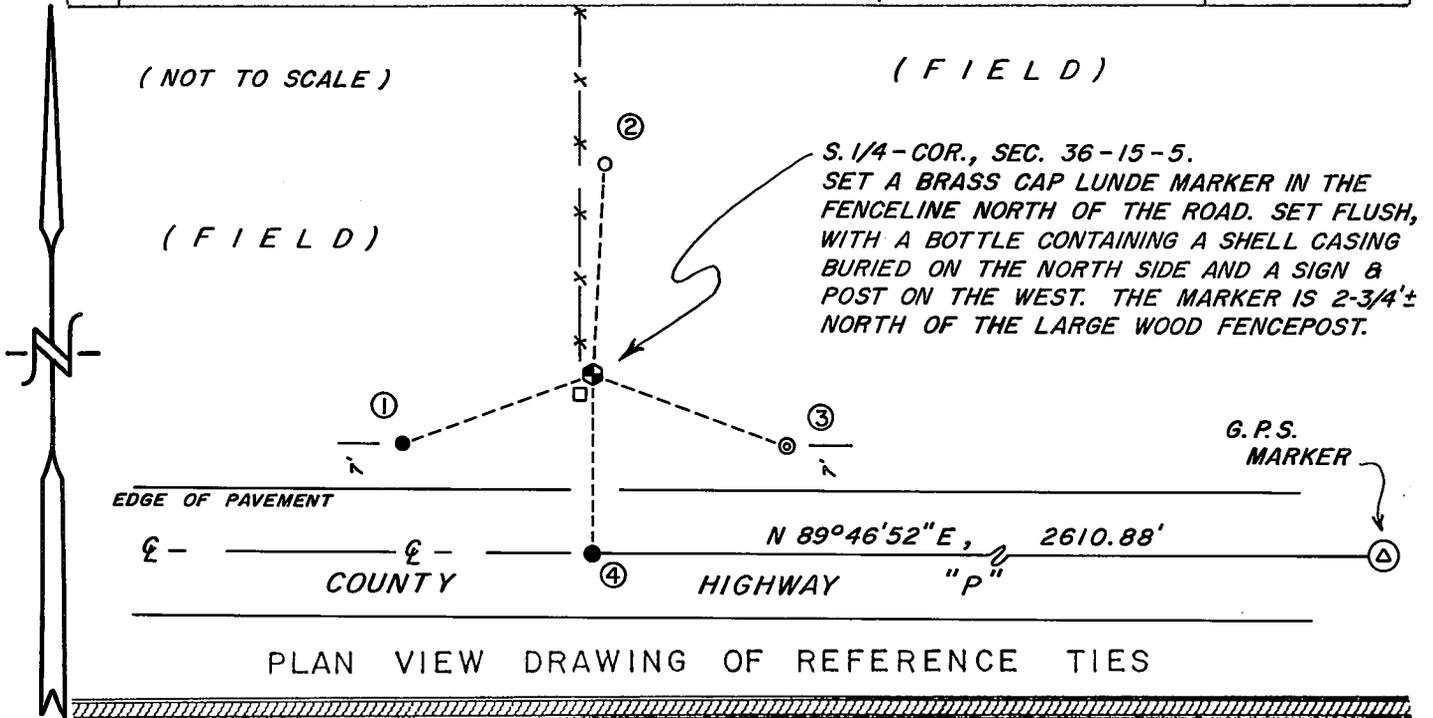


MAP SHOWING DISTANCE AND DIRECTION TO OTHER PUBLIC LAND SURVEY CORNERS USED FOR REESTABLISHING THE CORNER

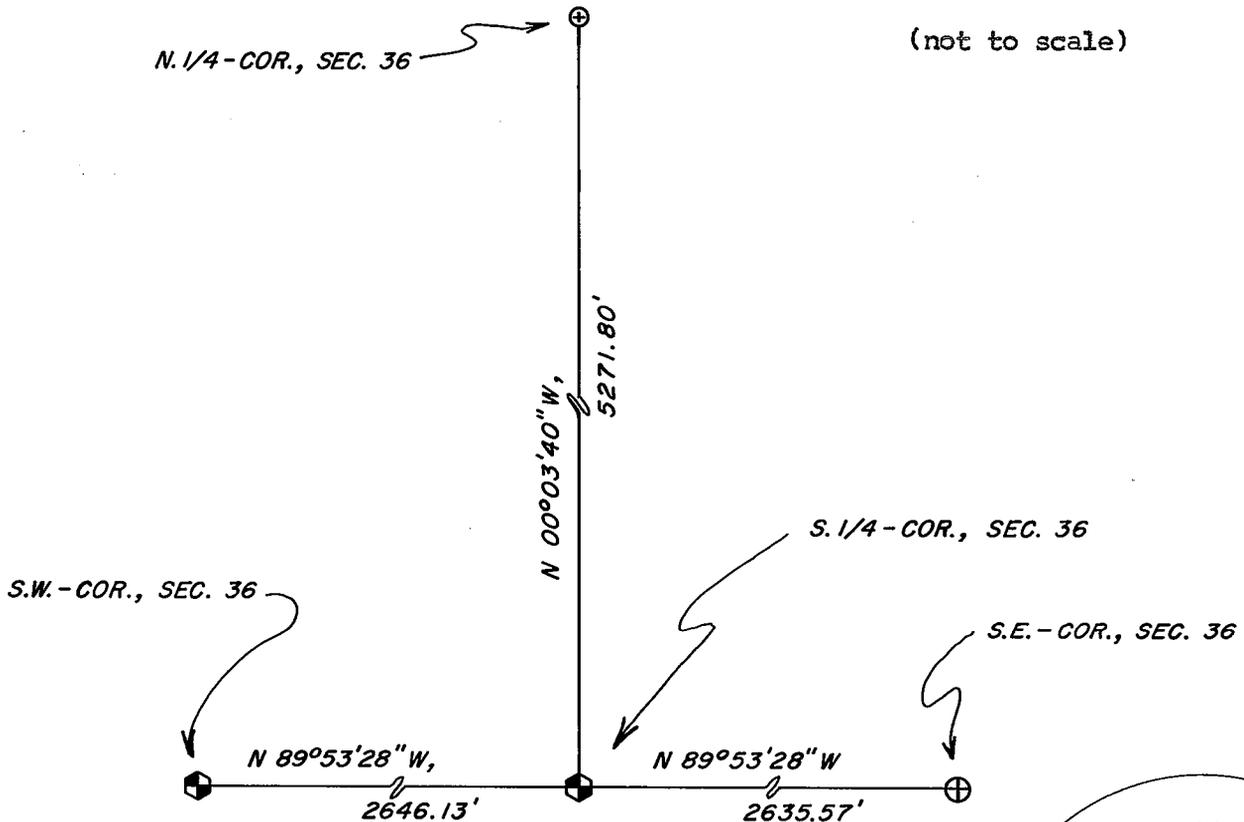

I, WILLIAM C. JUNG, COUNTY SURVEYOR
 HEREBY CERTIFY THAT THE CORNER LOCATION SHOWN ON THIS RECORD WAS DETERMINED BY ME OR UNDER MY DIRECTION AND CONTROL AND THAT THIS U. S. PUBLIC LAND SURVEY MONUMENT RECORD IS CORRECT AND COMPLETE TO THE BEST OF MY KNOWLEDGE AND BELIEF.

William C. Jung
 Signature

March 12, 1998
 Date

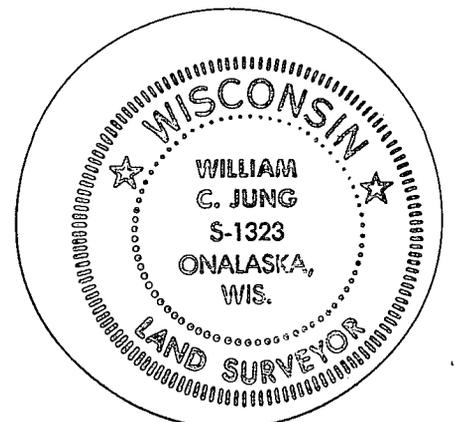

Seal