


LA CROSSE COUNTY, WISCONSIN U. S. PUBLIC LAND SURVEY MONUMENT RECORD

WEST ¼ CORNER, SECTION 6, T15N, R5W, TOWN OF WASHINGTON

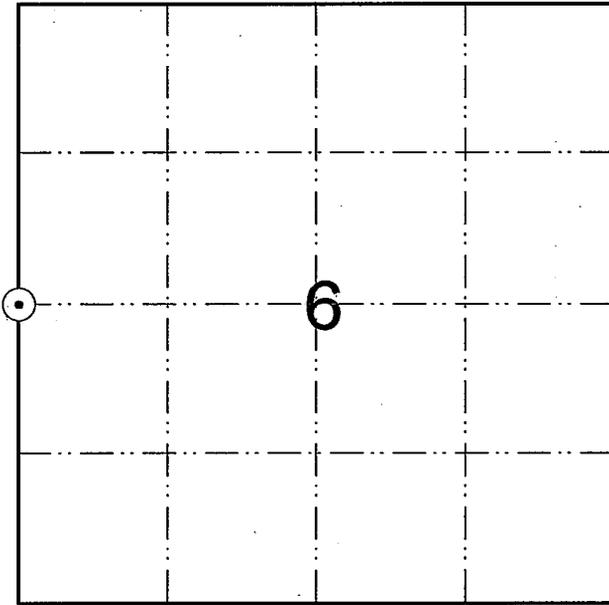

⊙ = LOCATION OF LANDMARK

TYPE OF MONUMENT:

Set 3/4" x 30" round iron bar with aluminum cap

WISCONSIN COORDINATE SYSTEM

NORTH = 659,417.9561

EAST = 1,696,296.6851


CREW: Bryan Meyer and Pete Follansbee

DATE: July 31, 2009

WEATHER: Mostly Sunny, 70°

PLAN VIEW OF REFERENCE TIES:

(NO SCALE)

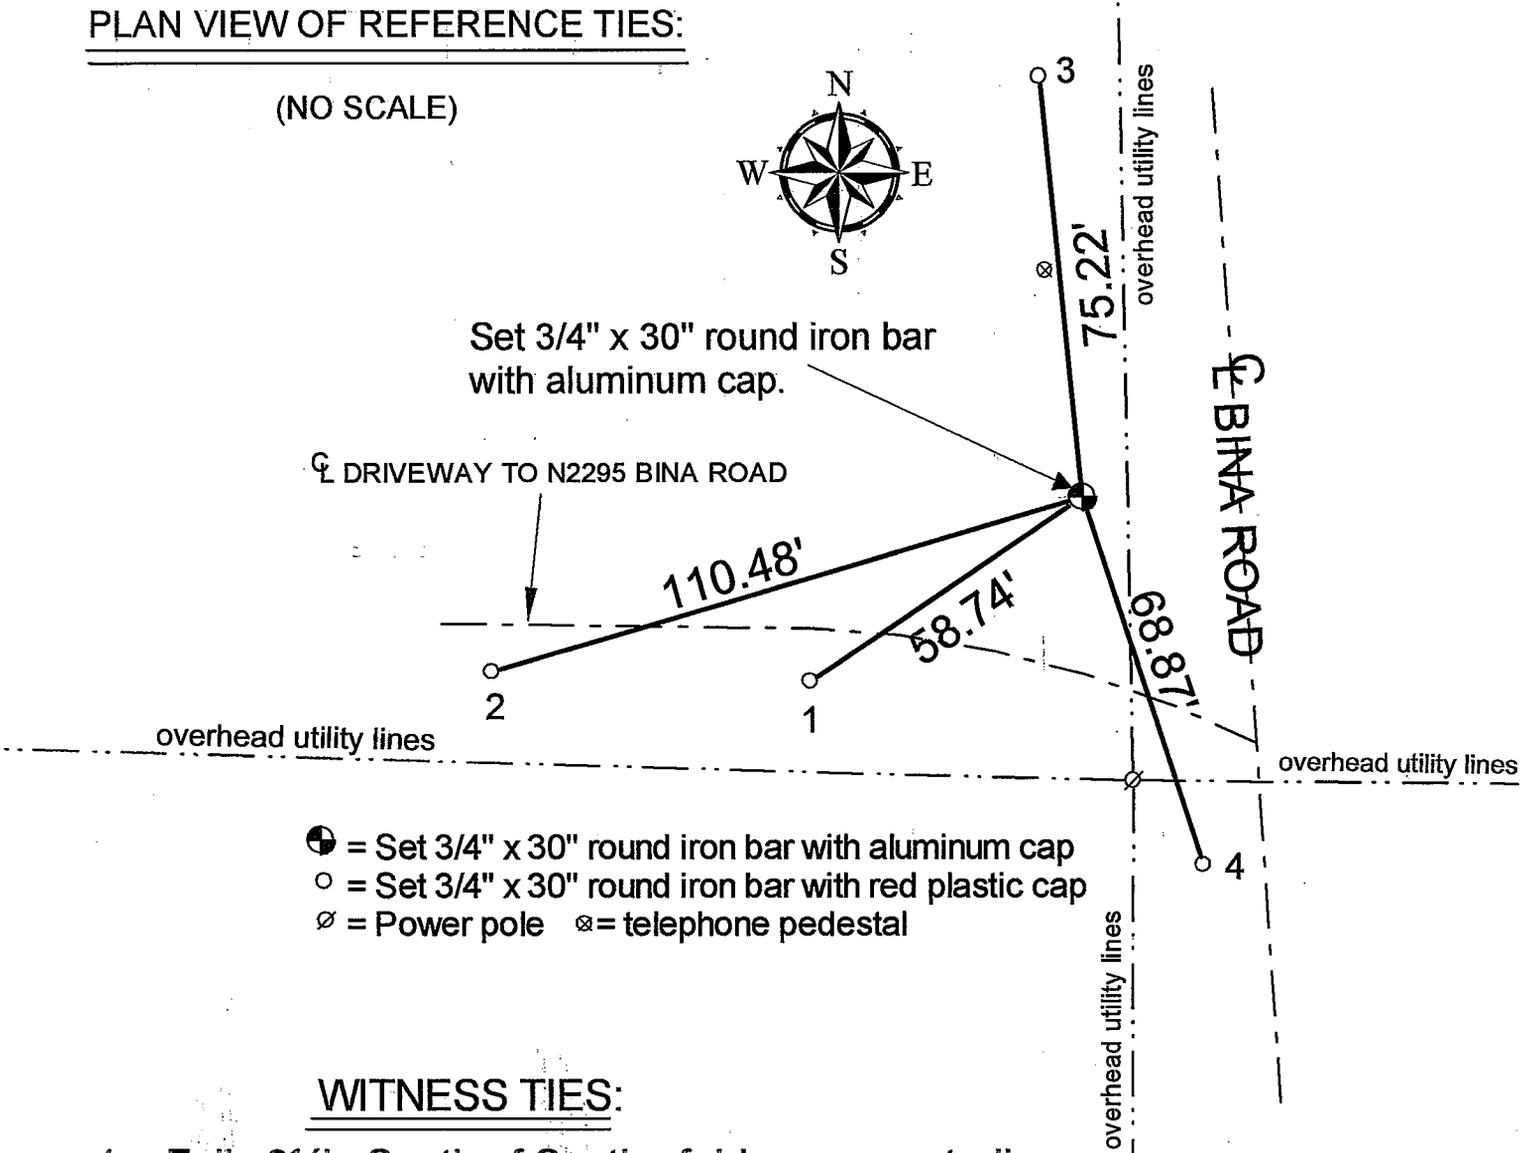


- ⊙ = Set 3/4" x 30" round iron bar with aluminum cap
- = Set 3/4" x 30" round iron bar with red plastic cap
- ∅ = Power pole ⊗ = telephone pedestal

WITNESS TIES:

- 1 = Falls 9½'± South of South of driveway centerline
- 2 = Falls 8½'± South of South of driveway centerline
- 3 = Falls 31'± West of Bina Road centerline
- 4 = Falls 11'± West of Bina Road centerline and 26'± South of driveway centerline

NO SCALE
GRID BEARINGS AND DISTANCES

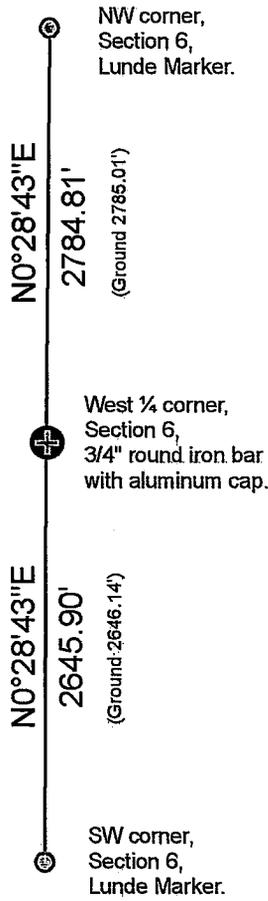

DESCRIBE ANY RECORD EVIDENCE, MONUMENT EVIDENCE, TESTIMONIAL EVIDENCE OR ANY OTHER MATERIAL EVIDENCE YOU CONSIDERED AND WHETHER THE MONUMENT WAS FOUND OR RESTORED THROUGH ACCEPTANCE OF AN OBLITERATED EVIDENCE LOCATION:

Set this corner on line and at proportionate distance between the Northwest and Southwest corners of Section 6.

DESCRIBE OR SHOW ANY MATERIAL DISCREPANCY BETWEEN THE LOCATION OF THE RESTORED CORNER AND THAT OF THE CORNER PREVIOUSLY RESTORED OR REESTABLISHED

None.

CERTIFICATE:

I, Bryan H. Meyer, County Surveyor, hereby certify that the corner location shown on this record was determined by me or under my direction and control and that this U. S. Public Land Survey Monument Record is correct and complete to the best of my knowledge and belief.

Bryan H. Meyer
Bryan H. Meyer, County Surveyor

2/19/2010
Date

