


## U. S. PUBLIC LAND SURVEY MONUMENT RECORD

SECTION 7 T 15 N, R 5 W, TOWN OF WASHINGTON

LA CROSSE COUNTY

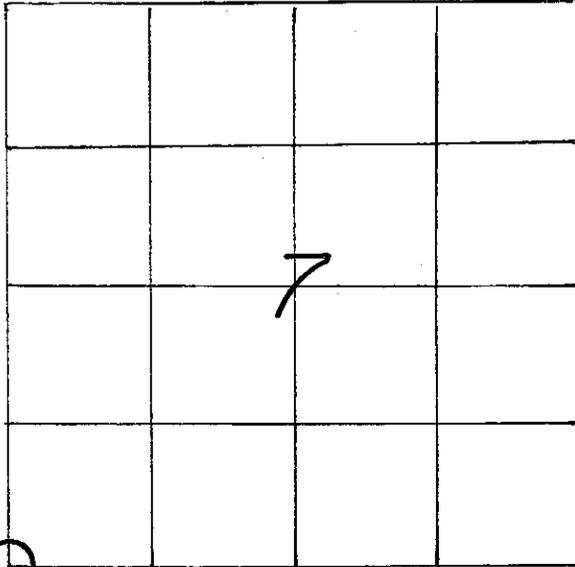

LOCATION OF LANDMARK

CREW: **BRYAN H. MEYER**  
**PETER F. FOLLANSBEE**  
 DATE: **8/27/2009**

## WISCONSIN COORDINATE SYSTEM

North **651,511.728**East **1,696,223.694**

Theta Angle

Horiz. Order

Vert. Order

**DATUM: NAD 1983 ('91)**

TYPE OF LANDMARK

**2" x 30" IRON PIPE.**

BEARINGS ARE REFERENCED TO

**GRID NORTH AS PER SECTION DATA.**


Describe any record evidence, monument evidence, testimonial evidence or any other material evidence you considered and whether the monument was found or restored through acceptance of an obliterated evidence location.

Describe or show any material discrepancy between the location of the restored corner and that of the corner previously restored or reestablished.

RECORD OF DURABLE WITNESS MONUMENTS


MAGNETIC

NO	DESCRIPTION	BEARING	DISTANCE
1	SET A NAIL IN N.-SIDE OF A 19" WHITE OAK	S 83° W	35.24 FT.
2	EX. NAIL, UP 3', IN N.E.-SIDE OF A 9" HICKORY	N 44° W	16.98 FT.
3	EX. 1-1/4" IRON PIPE, UP 1"	N 25° E	7.12 FT.
4	SET A NAIL IN N.W.-SIDE OF A TRIPLE HICKORY	N 74° E	21.44 FT.

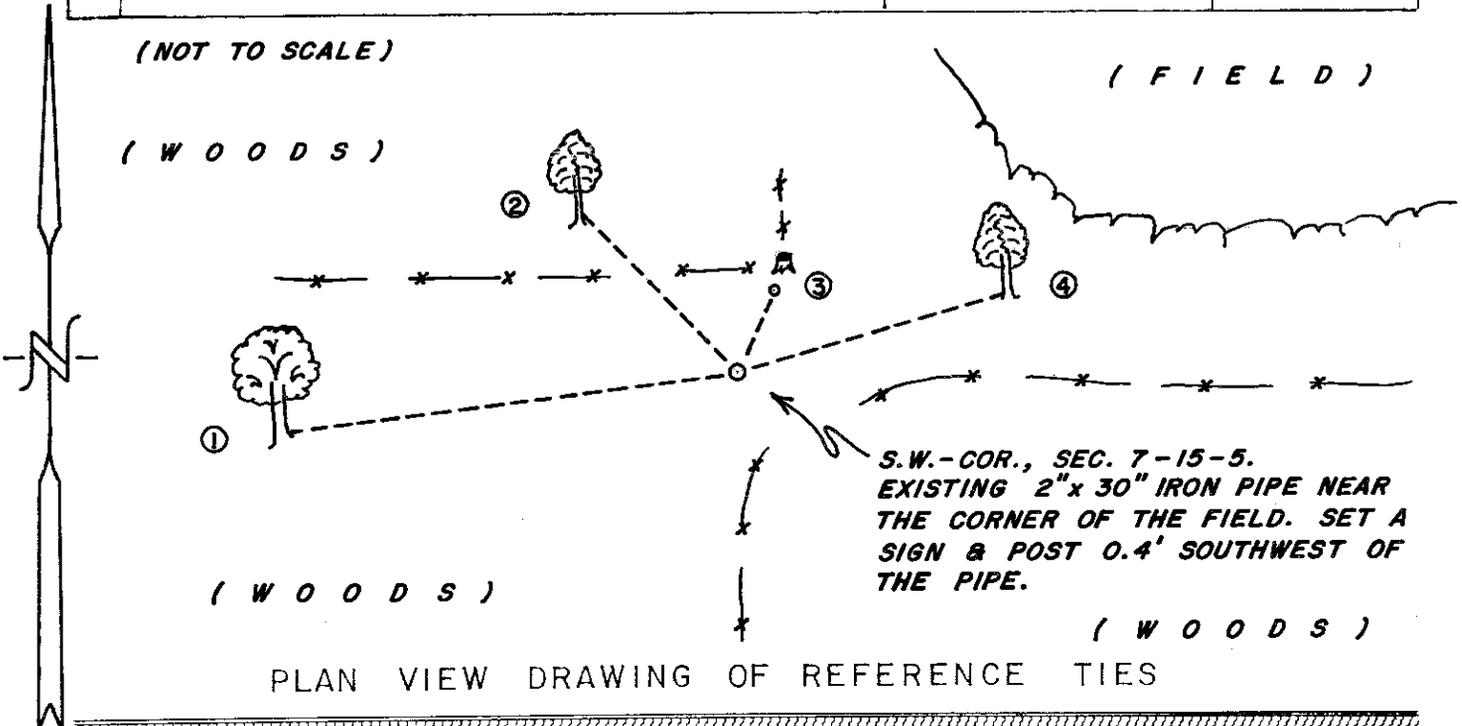

MAP SHOWING DISTANCE AND DIRECTION TO OTHER PUBLIC LAND SURVEY CORNERS USED FOR REESTABLISHING THE CORNER


(GRID BEARINGS AND DISTANCES)  
(GRID FACTOR: 0.9998964)  
(NOT TO SCALE)

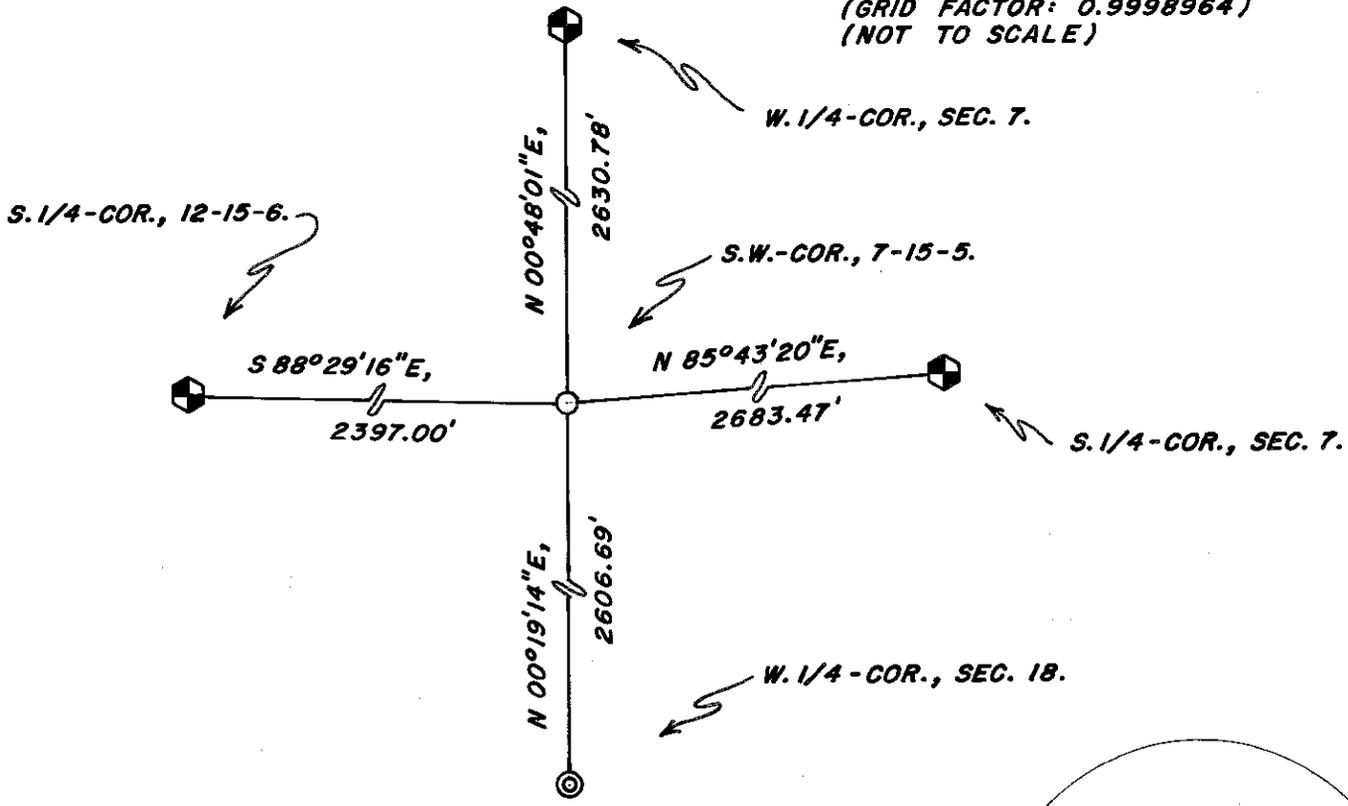

I, BRYAN H. MEYER, COUNTY SURVEYOR  
HEREBY CERTIFY THAT THE CORNER LOCATION SHOWN ON THIS RECORD WAS DETERMINED BY ME OR UNDER MY DIRECTION AND CONTROL AND THAT THIS U. S. PUBLIC LAND SURVEY MONUMENT RECORD IS CORRECT AND COMPLETE TO THE BEST OF MY KNOWLEDGE AND BELIEF.

*Bryan H. Meyer*  
Signature


July 14, 2010  
Date

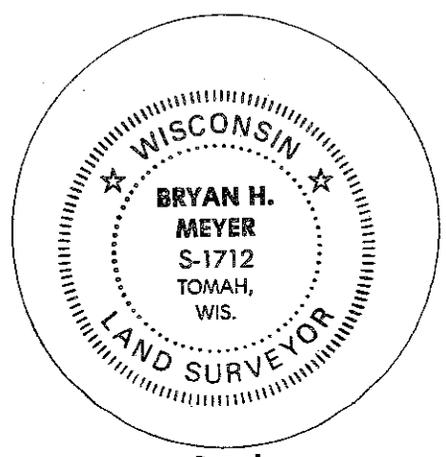

Seal

## U. S. PUBLIC LAND SURVEY MONUMENT RECORD

SECTION 7 T 15 N, R 5 W, TOWN OF Washington  
 LA CROSSE COUNTY

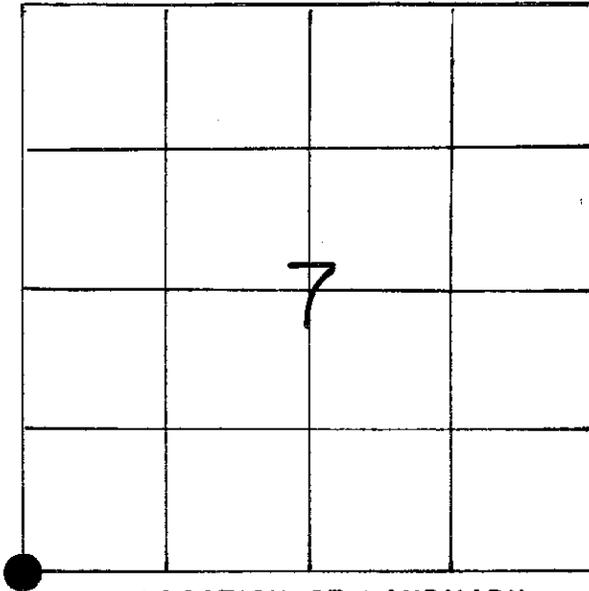

LOCATION OF LANDMARK

Crew: William C. Jung  
 Peter F. Follansbee

Date: 12/10/90 and 1/17/91

Describe any record evidence, monument evidence, testimonial evidence or any other material evidence you considered and whether the monument was found or restored through acceptance of an obliterated evidence location.

After analyzing the measurements in all four cardinal directions, I accepted the occupied corner as the best available evidence of the original government corner and monumented it with an iron pipe.

Describe or show any material discrepancy between the location of the restored corner and that of the corner previously restored or reestablished.

This point may be about 3' North of Berg's corner. There is a bearing tree to the Northwest (not an original). I don't know who used it.

WISCONSIN COORDINATE SYSTEM
-----------------------------

North
-------

East
------

Theta Angle
-------------

Horiz. Order
--------------

Vert. Order
-------------

TYPE OF LANDMARK
------------------


2"x30" iron pipe
------------------

BEARINGS ARE REFERENCED TO
----------------------------

True
------

RECORD OF DURABLE WITNESS MONUMENTS  
Magnetic


NO	DESCRIPTION	BEARING	DISTANCE
1	P.K. nail in double blazed 14" double white oak	S74°W	slope =35.75
2	Ex. nail, up 3', in double blazed 6" hickory	N44°W	17.03
3	P.K. nail in double blazed 7" hickory	N74°E	22.06
4	" 12" bearing tree	N80°E	35.08

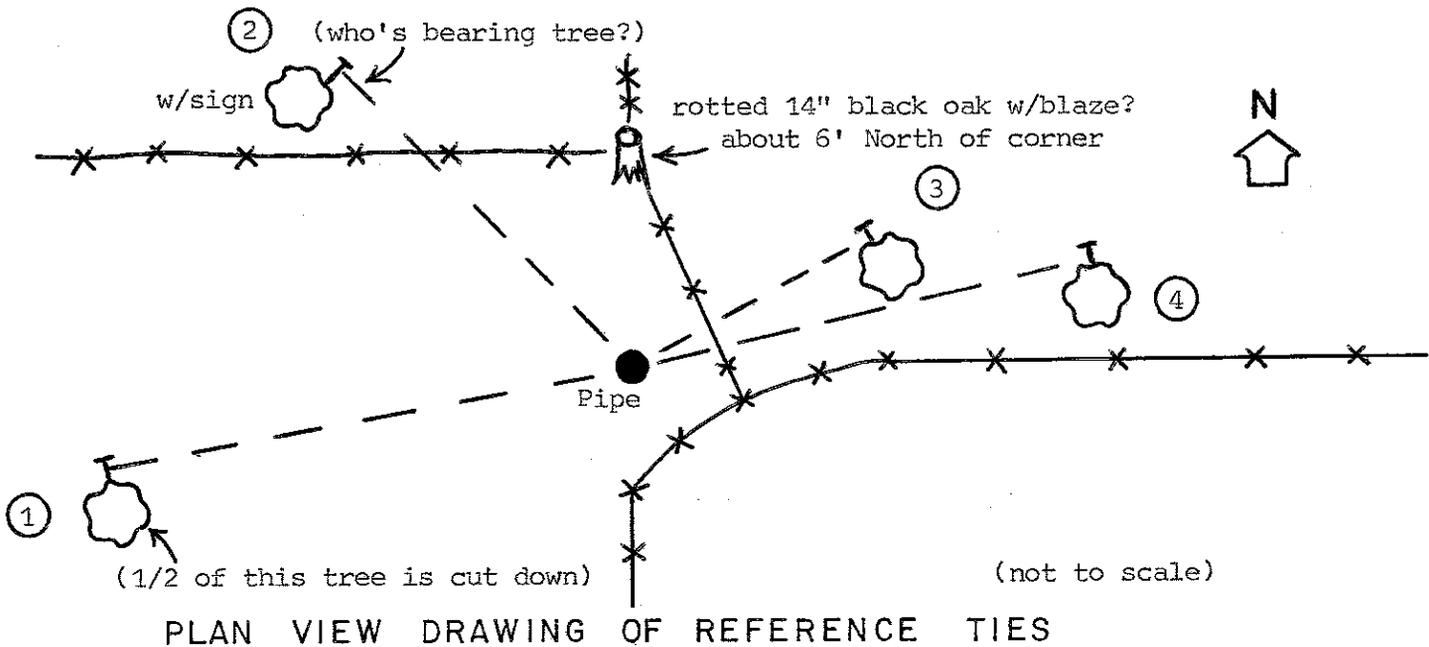

PLAN VIEW DRAWING OF REFERENCE TIES

MAP SHOWING DISTANCE AND DIRECTION TO OTHER PUBLIC LAND SURVEY CORNERS USED FOR REESTABLISHING THE CORNER

(not to scale)

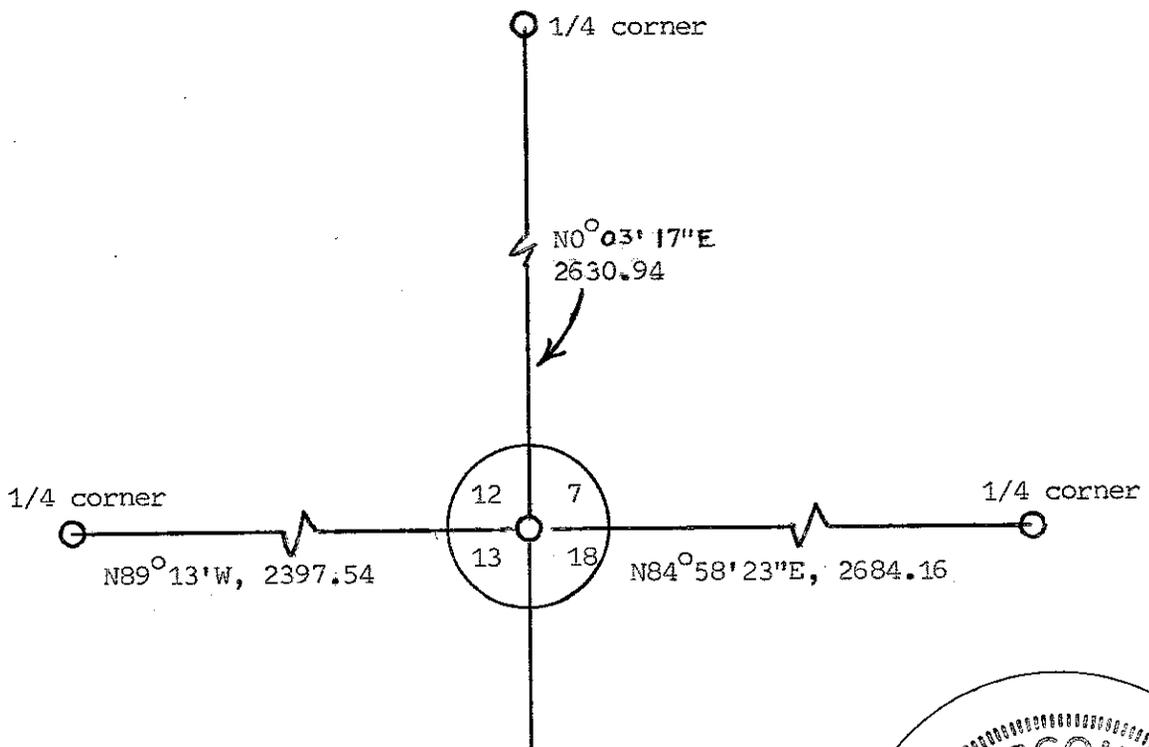

I, William C. Jung, Deputy County Surveyor,  
HEREBY CERTIFY THAT THE CORNER LOCATION SHOWN ON THIS RECORD  
WAS DETERMINED BY ME OR UNDER MY DIRECTION AND CONTROL AND  
THAT THIS U. S. PUBLIC LAND SURVEY MONUMENT RECORD IS CORRECT  
AND COMPLETE TO THE BEST OF MY KNOWLEDGE AND BELIEF.

William C. Jung  
Signature

January 22, 1991  
Date



Seal