


## U. S. PUBLIC LAND SURVEY MONUMENT RECORD

SECTION 31 T 15 N, R 5 W, TOWN OF WASHINGTON

LA CROSSE COUNTY

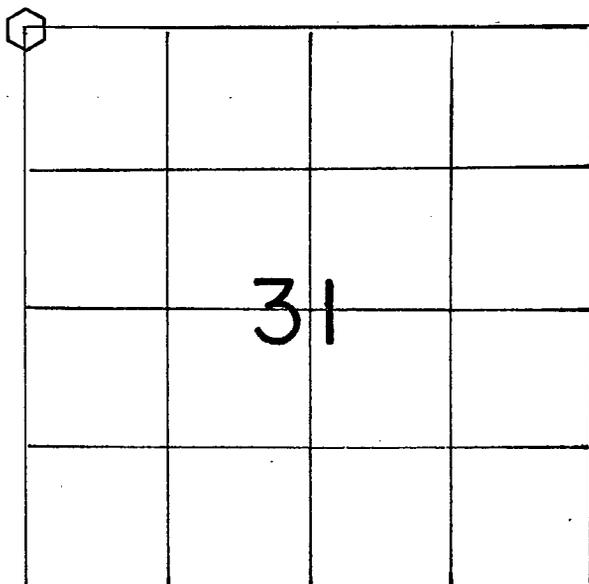

LOCATION OF LANDMARK

Crew: WILLIAM C. JUNG

PETER F. FOLLANSBEE

Date: 3/16/1995

## WISCONSIN COORDINATE SYSTEM

North

East

Theta Angle

Horiz. Order

Vert. Order

## TYPE OF LANDMARK

Set brass cap Lunde marker.

## BEARINGS ARE REFERENCED TO

Grid North.

Describe any record evidence, monument evidence, testimonial evidence or any other material evidence you considered and whether the monument was found or restored through acceptance of an obliterated evidence location.


I set the corner on line with an old line fence to the East and three rods West of an old line fence to the South. This location fits the old deeds. It also fits the evidence found in Section 31 and Middlebrook's 1876 survey. I set a Lunde marker at the corner. I also checked into the next North-South line fence to the West in Sections 25 and 36. This location also fits that line fence too.

Describe or show any material discrepancy between the location of the restored corner and that of the corner previously restored or reestablished.

If the existing pipe 16.24 feet to the East was intended to be the corner, I do not agree with it. I found this pipe well off plumb because of frost, etc. The pipe was plumbed back up.


RECORD OF DURABLE WITNESS MONUMENTS

NO	DESCRIPTION	MAGNETIC	
		BEARING	DISTANCE
1	Set P.K. Nail in SE-side 5" Hickory(unblazed)	S 66° W	7.87 Ft.
2	Set P.K. Nail in W.-side 6½" Oak(double blazed)	N 17° E	34.38 Ft.
3	Set P.K. Nail in NW-side 5" Hickory(unblazed)	N 53° E	23.00 Ft.
4	Set P.K. Nail in NE-side 5" Birch(double blazed)	S 46° E	19.23 Ft.

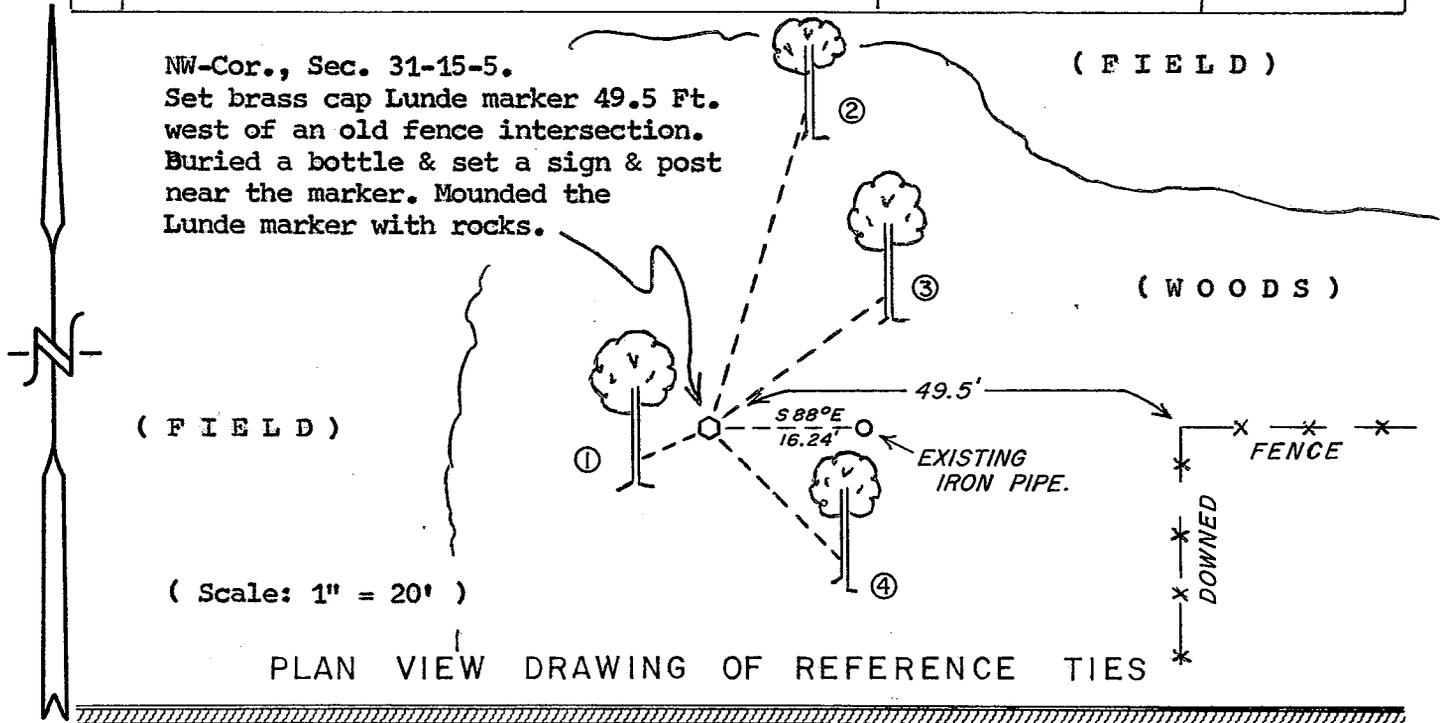

MAP SHOWING DISTANCE AND DIRECTION TO OTHER PUBLIC LAND SURVEY CORNERS USED FOR REESTABLISHING THE CORNER


(not to scale)

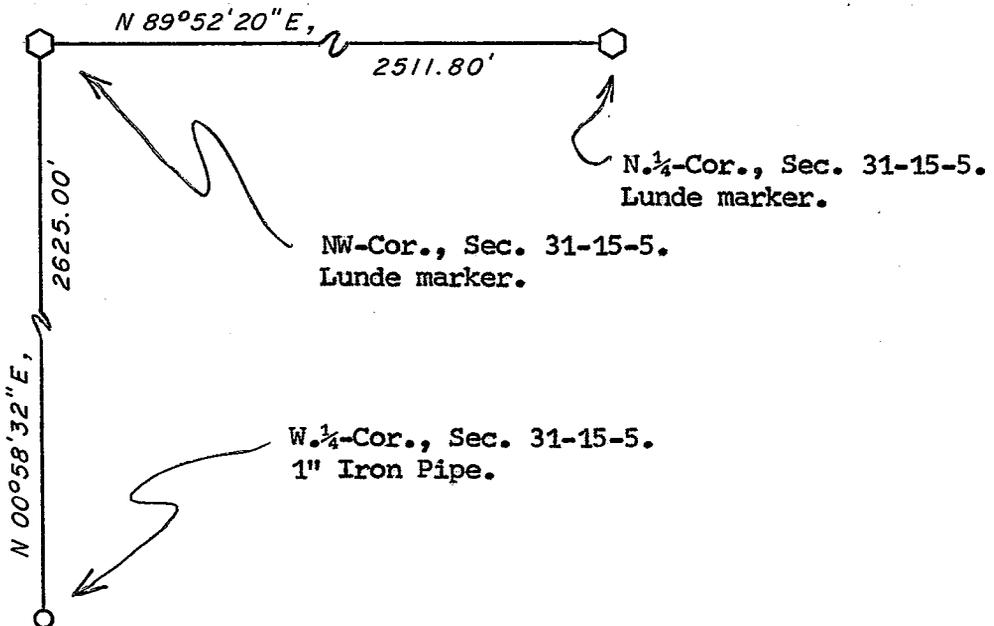

I, William C. Jung, County Surveyor  
HEREBY CERTIFY THAT THE CORNER LOCATION SHOWN ON THIS RECORD WAS DETERMINED BY ME OR UNDER MY DIRECTION AND CONTROL AND THAT THIS U. S. PUBLIC LAND SURVEY MONUMENT RECORD IS CORRECT AND COMPLETE TO THE BEST OF MY KNOWLEDGE AND BELIEF.

William C. Jung  
Signature

4/4/95  
Date

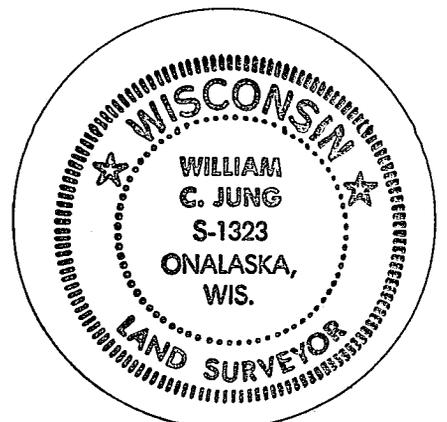

Seal