


U. S. PUBLIC LAND SURVEY MONUMENT RECORD

SECTION 30 T 15 N, R 5 W, TOWN OF WASHINGTON

LA CROSSE COUNTY

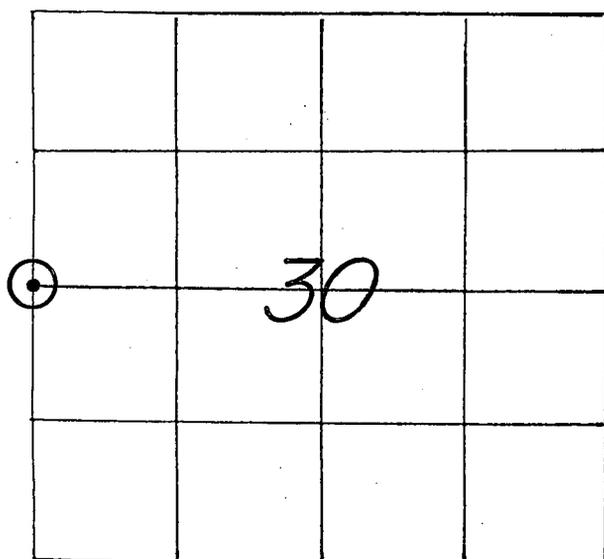

LOCATION OF LANDMARK

CREW: WILLIAM C. JUNG
 PETER F. FOLLANSBEE
 DATE: 12/13/2006

WISCONSIN COORDINATE SYSTEM

North 638,378.704

East 1,696,099.572

Theta Angle

Horiz. Order

Vert. Order

DATUM: 1983('91)

TYPE OF LANDMARK

3/4" x 30" IRON BAR WITH A RED PLASTIC CAP.

BEARINGS ARE REFERENCED TO
 GRID NORTH AS PER SECTION DATA.

Describe any record evidence, monument evidence, testimonial evidence or any other material evidence you considered and whether the monument was found or restored through acceptance of an obliterated evidence location.


I set this corner at the single proportionate position. An iron bar was set at the corner and buried in a field.

Describe or show any material discrepancy between the location of the restored corner and that of the corner previously restored or reestablished.


The location of this corner may not agree with Rob Lampman's computed position from 1977 and 1983.

RECORD OF DURABLE WITNESS MONUMENTS

NO	DESCRIPTION	GRID BEARINGS	GRID DISTANCES
		BEARING	DISTANCE
1	SET A 3/4"x 30" I. BAR w/RED CAP 13' S.W. OF C	N 55°19'58" E	1,151.42 FT.
2	EX. GPS CONTROL MARKER "WASHINGTON WEST".	N 85°50'07" E	1,454.77 FT.
3	SET A P.K. NAIL IN N.W.-SIDE 11-1/2" SHAGBARK HICKORY	S 23°17'16" E	101.44 FT.
4	SET A P.K. NAIL IN N.W.-SIDE 9" SMOOTHBARK HICKORY	S 10°42'25" W	99.52 FT.

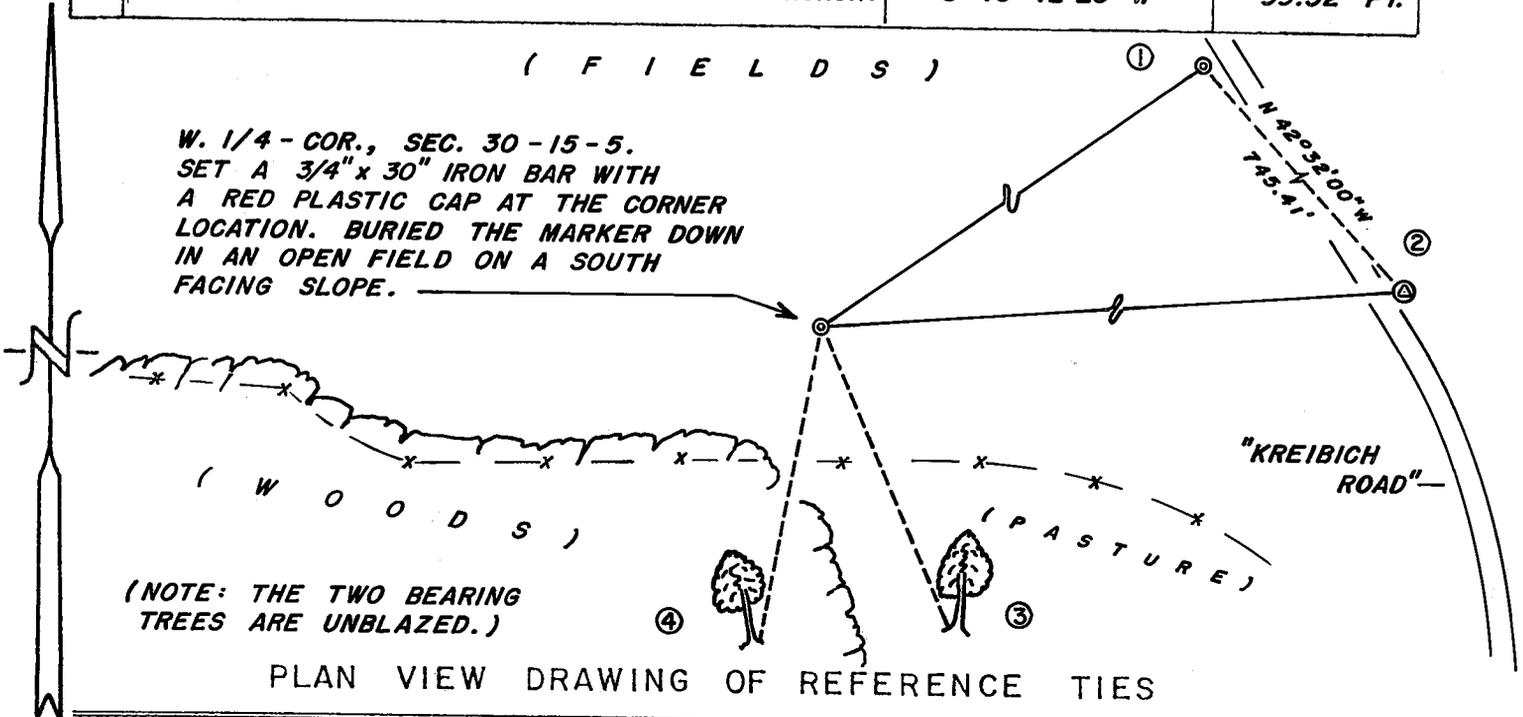

MAP SHOWING DISTANCE AND DIRECTION TO OTHER PUBLIC LAND SURVEY CORNERS USED FOR REESTABLISHING THE CORNER

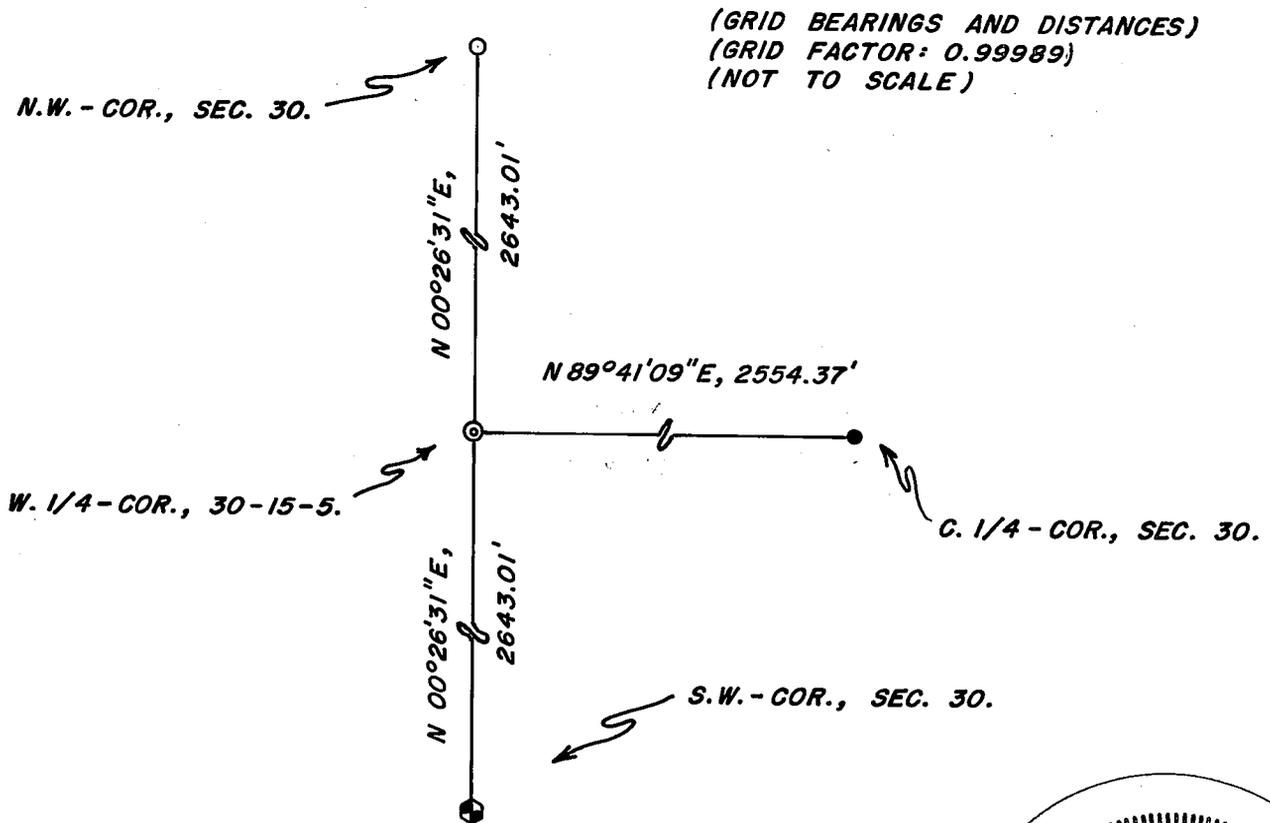

I, WILLIAM C. JUNG, COUNTY SURVEYOR
 HEREBY CERTIFY THAT THE CORNER LOCATION SHOWN ON THIS RECORD
 WAS DETERMINED BY ME OR UNDER MY DIRECTION AND CONTROL AND
 THAT THIS U. S. PUBLIC LAND SURVEY MONUMENT RECORD IS CORRECT
 AND COMPLETE TO THE BEST OF MY KNOWLEDGE AND BELIEF.

William C. Jung 2/28/07
 Signature Date

