


U. S. PUBLIC LAND SURVEY MONUMENT RECORD

SECTION 31 T 15 N, R 5 W, TOWN OF WASHINGTON

LA CROSSE COUNTY

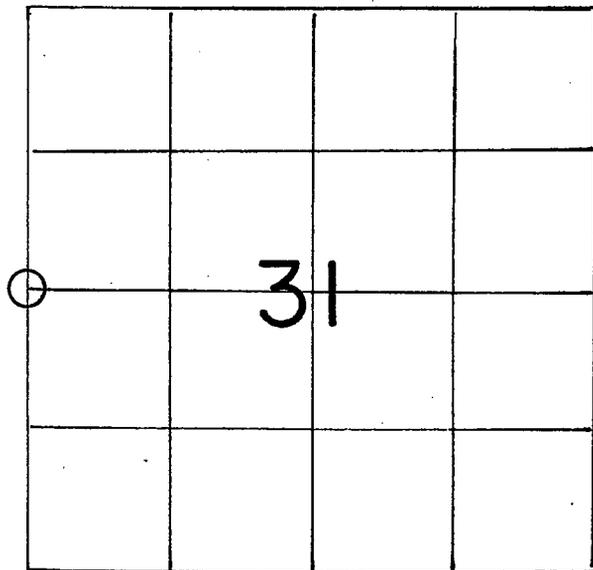

LOCATION OF LANDMARK

WISCONSIN COORDINATE SYSTEM
North
East
Theta Angle
Horiz. Order
Vert. Order

TYPE OF LANDMARK Berntsen marker  
~~Set 1" Iron Pipe in field entrance.~~

BEARINGS ARE REFERENCED TO  
Grid North.

Crew: WILLIAM C. JUNG  
PETER F. FOLLANSBEE  
Date: 3/24/1995

Crew: William C. Jung  
Peter F. Follansbee  
Date: 9/28/07

Describe any record evidence, monument evidence, testimonial evidence or any other material evidence you considered and whether the monument was found or restored through acceptance of an obliterated evidence location.

I set this corner by single proportionate measurement. I feel that this location fits the evidence found in Section 31 very well. An iron pipe was set at the corner.

\*\*\*\*\* 9/28/07


We removed our old iron pipe and replaced it with a 30" Berntsen marker.

Describe or show any material discrepancy between the location of the restored corner and that of the corner previously restored or reestablished.


None Known.

RECORD OF DURABLE WITNESS MONUMENTS

GRID			
NO	DESCRIPTION	BEARING	DISTANCE
1	D.O.T. Horizontal Control Marker "MOILIEN"	S 44° 49' 33" W	1901.77 Ft.
2	<del>Reset our</del> Existing 1" Iron Pipe survey point.	<del>N 22° 37' 23" W</del>	<del>36.81 Ft.</del> 36.54'
3	Set a new <del>Set</del> Railroad Spike in centerline of highway.	<del>N 00° 58' 32" E</del>	<del>46.86 Ft.</del> 46.85'
4	Ex. Set 1-3/4" x 16 1/2" Iron Pipe south of highway.	N 49° 28' 17" E	44.10 Ft.

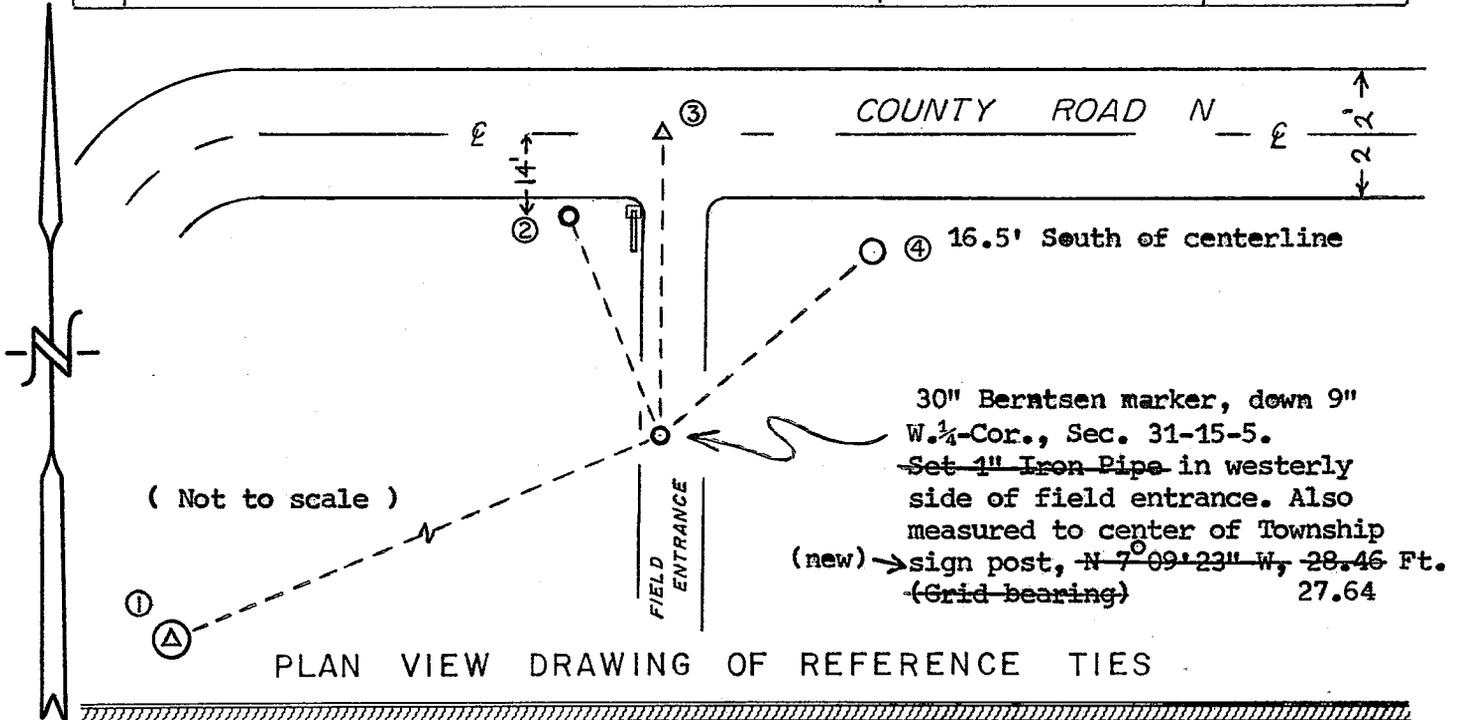

MAP SHOWING DISTANCE AND DIRECTION TO OTHER PUBLIC LAND SURVEY CORNERS USED FOR REESTABLISHING THE CORNER

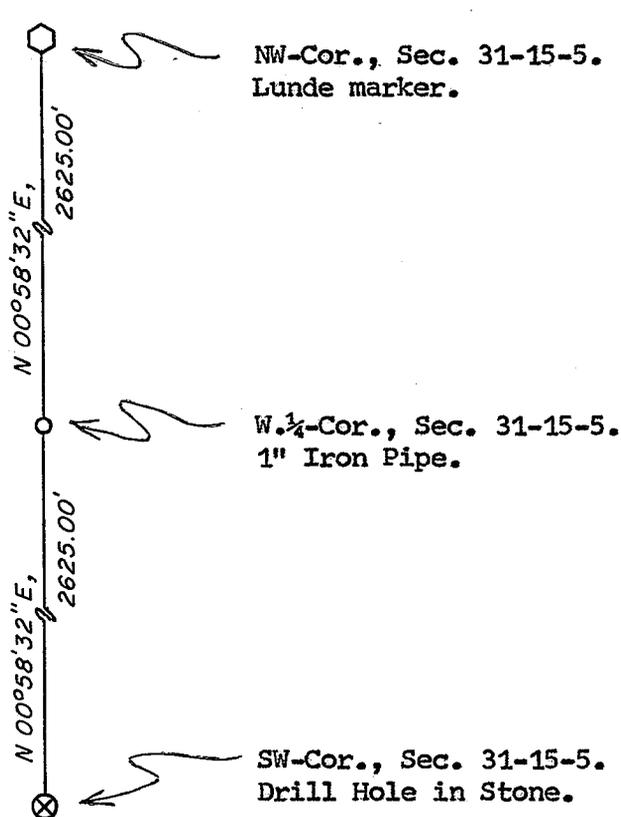

I, William C. Jung, County Surveyor  
 HEREBY CERTIFY THAT THE CORNER LOCATION SHOWN ON THIS RECORD WAS DETERMINED BY ME OR UNDER MY DIRECTION AND CONTROL AND THAT THIS U. S. PUBLIC LAND SURVEY MONUMENT RECORD IS CORRECT AND COMPLETE TO THE BEST OF MY KNOWLEDGE AND BELIEF.

William C. Jung  
 Signature

4/4/95  
 Date

Revised: wej  
 10/19/07

