


21605310020

## U. S. PUBLIC LAND SURVEY MONUMENT RECORD

SECTION 6 T 15 N, R 5 W, TOWN OF WASHINGTON

LA CROSSE COUNTY

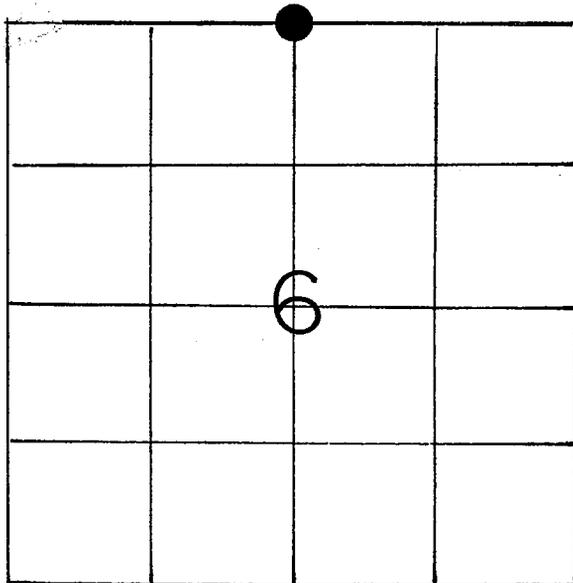

LOCATION OF LANDMARK

Crew: WILLIAM C. JUNG  
PETER F. FOLLANSBEE

Date: 11/09/1992

Describe any record evidence, monument evidence, testimonial evidence or any other material evidence you considered and whether the monument was found or restored through acceptance of an obliterated evidence location.

Pete found the top of the old stone. It apparently was knocked out by a bulldozer when the old fence was replaced. We dug and searched extensively for any sign of the rest of the stone but were unsuccessful. Curt Strittmatter remembered that the old stone was in the fence. The new fence appears to be where the old one was. I set the corner on line with the section corners and by the N-S fence. A Lunde was set. Describe or show any material discrepancy between the location of the restored corner and that of the corner previously restored or reestablished.

None Known

WISCONSIN COORDINATE SYSTEM

North

East

Theta Angle

Horiz. Order

Vert. Order

TYPE OF LANDMARK


Set brass cap Lunde marker.

BEARINGS ARE REFERENCED TO


True

RECORD OF DURABLE WITNESS MONUMENTS  
MAGNETIC

NO	DESCRIPTION	BEARING	DISTANCE
1	Set P.K. Nail in NE-side 5" Burr Oak	Northwesterly	37.32 Ft.
2	Set P.K. Nail in SE-side 20" Dbl. Burr	N 42° E	63.20 Ft.
3	Set P.K. Nail in NE-side 6" Birch	Southeasterly	20.92 Ft.
4	Set P.K. Nail in SE-side 5" Hickory	Southwesterly	33.80 Ft.

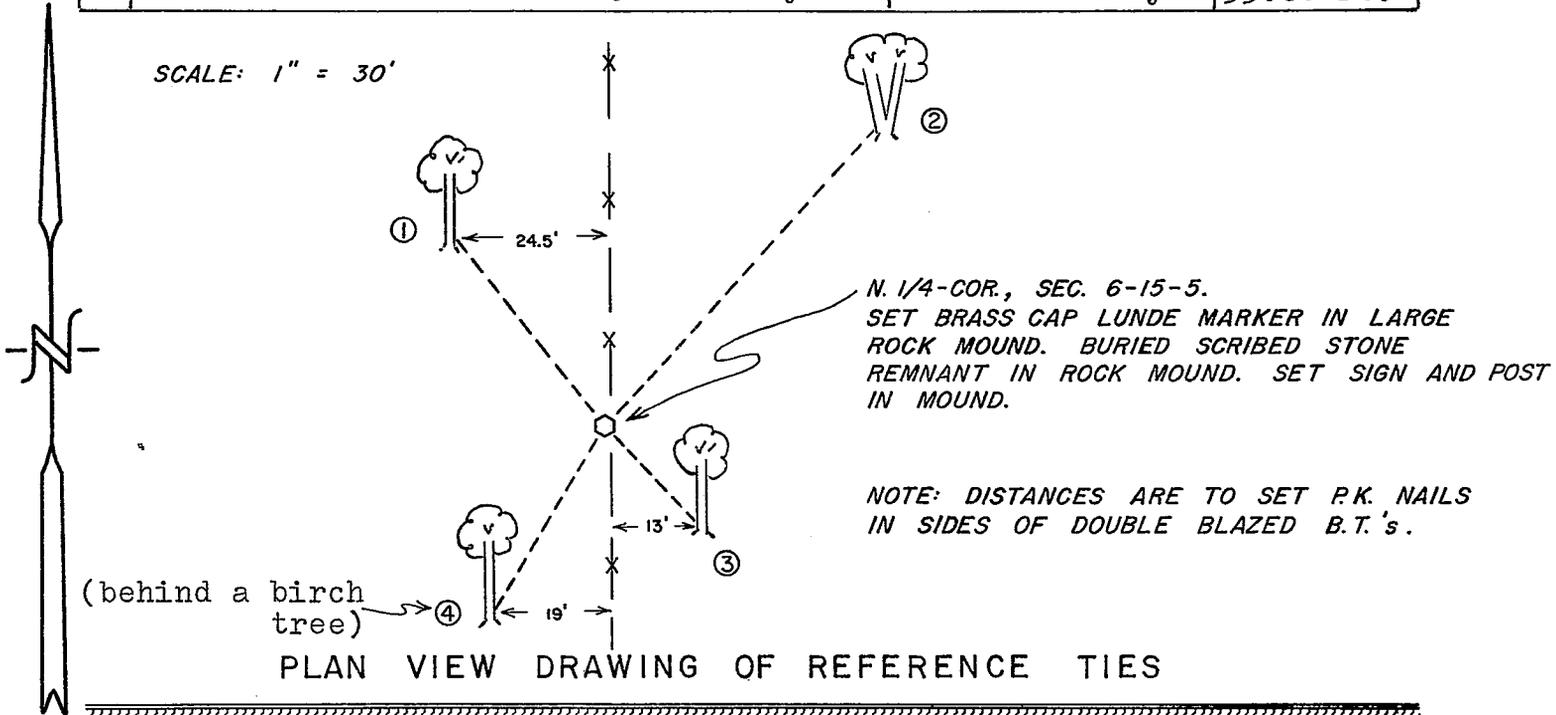


MAP SHOWING DISTANCE AND DIRECTION TO OTHER PUBLIC LAND SURVEY CORNERS USED FOR REESTABLISHING THE CORNER  
(not to scale)

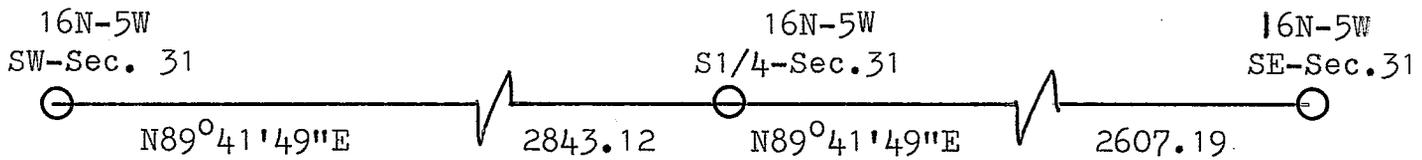

I, William C. Jung, Deputy County Surveyor  
HEREBY CERTIFY THAT THE CORNER LOCATION SHOWN ON THIS RECORD WAS DETERMINED BY ME OR UNDER MY DIRECTION AND CONTROL AND THAT THIS U. S. PUBLIC LAND SURVEY MONUMENT RECORD IS CORRECT AND COMPLETE TO THE BEST OF MY KNOWLEDGE AND BELIEF.

William C. Jung  
Signature

November 12, 1992  
Date

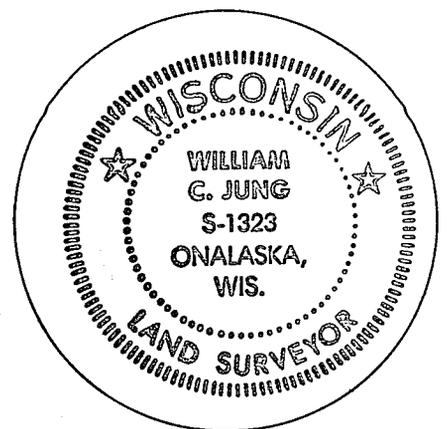

Seal