


21605330000

U. S. PUBLIC LAND SURVEY MONUMENT RECORD

SECTION 4 T 15 N, R 5 W, TOWN OF WASHINGTON & BANGOR
 LA CROSSE COUNTY Town Line

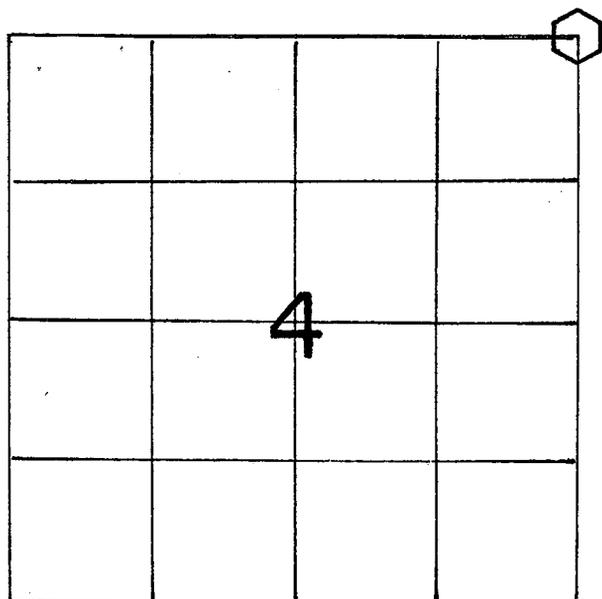

LOCATION OF LANDMARK

WISCONSIN COORDINATE SYSTEM	
North	662,087.402
East	1,712,285.281
Theta Angle	
Horiz. Order	
Vert. Order	
DATUM:	1983('91)
TYPE OF LANDMARK	
Set brass cap Lunde marker	
BEARINGS ARE REFERENCED TO	

Crew: WILLIAM C. JUNG

Crew: William C. Jung

Date: 6/20/1991

Date: 9/27/05

Describe any record evidence, monument evidence, testimonial evidence or any other material evidence you considered and whether the monument was found or restored through acceptance of an obliterated evidence location.

I replaced an existing stone with a brass capped Lunde marker after accepting the stone as the best available evidence of the original government corner position.

Describe or show any material discrepancy between the location of the restored corner and that of the corner previously restored or reestablished.


None known

RECORD OF DURABLE WITNESS MONUMENTS

NO	DESCRIPTION	MAGNETIC	
		BEARING	DISTANCE
1	Set P.K. Nail in SE-side 14" Oak	S 65°W	29.15 Ft.
2	Set P.K. Nail in SE-side 6½" Cherry	S 50°W	18.52 Ft.
3	Set P.K. Nail in S-side 7" W. Oak(w/sign)	S 70°W	7.88 Ft.
4	Set P.K. Nail in NW-side 10" W. Oak	N 53°E	15.81 Ft.

NOTE: DISTANCES ARE TO SET P.K. NAILS IN UNBLAZED TREES.

Scale: 1"=10'

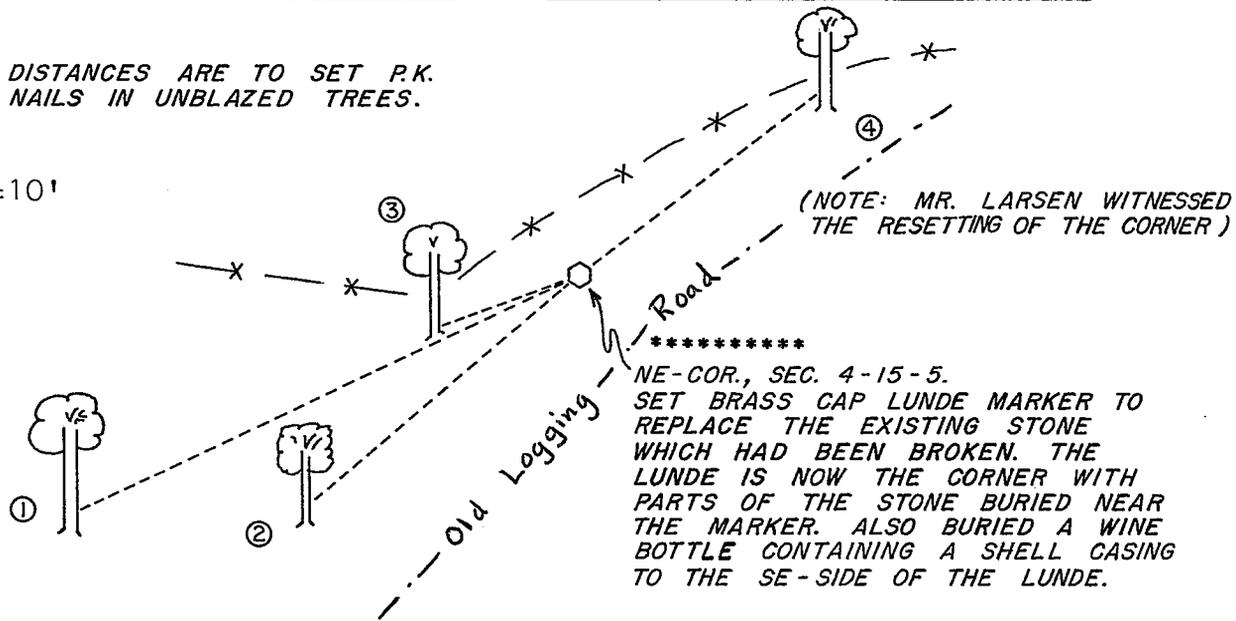

PLAN VIEW DRAWING OF REFERENCE TIES

MAP SHOWING DISTANCE AND DIRECTION TO OTHER PUBLIC LAND SURVEY CORNERS USED FOR REESTABLISHING THE CORNER

No section measurements made by me at this time. (1991)

***** 9/27/05

N40°W, 5 feet, is an unblazed 3½" ash. The distance is measured to the center of the tree at the base.

S85°E, 6.1 feet, is an unblazed 5' ash. The distance is measured to the center of the tree.

I, William C. Jung, Deputy County Surveyor
 HEREBY CERTIFY THAT THE CORNER LOCATION SHOWN ON THIS RECORD
 WAS DETERMINED BY ME OR UNDER MY DIRECTION AND CONTROL AND
 THAT THIS U. S. PUBLIC LAND SURVEY MONUMENT RECORD IS CORRECT
 AND COMPLETE TO THE BEST OF MY KNOWLEDGE AND BELIEF.

William C. Jung Signature 11/4/91 Date

Revised: 11/15/05 *wej*



Seal