


21605340000

U. S. PUBLIC LAND SURVEY MONUMENT RECORD

SECTION 2 T 15 N, R 5 W, TOWN OF Washington

LA CROSSE COUNTY

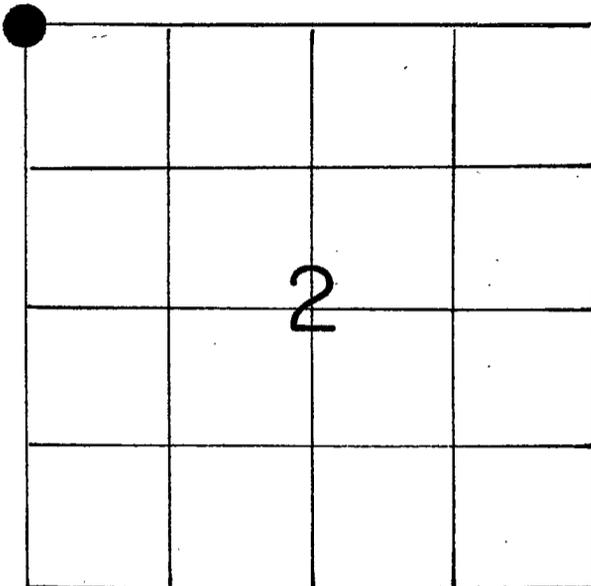

LOCATION OF LANDMARK

Crew: William C. Jung
Peter F. Follansbee

Date: 9/24/90

Crew: William C. Jung
Peter F. Follansbee

Date: 9/20/05

Describe any record evidence, monument evidence, testimonial evidence or any other material evidence you considered and whether the monument was found or restored through acceptance of an obliterated evidence location.

I found the old corner stone broken in (5) pieces by the old corner post. Half of the stone was in good condition. The scribed section numbers could still be read. I reset the good half piece, 3"x6"x34", in a mound of rocks and in the old post hole. I found enough of the stone buried to verify its position. I removed the rotted post. (3) pieces of the stone were buried with it. I also found a nail, apparently someone's survey point, in the rock rubble.

Describe or show any material discrepancy between the location of the restored corner and that of the corner previously restored or reestablished.

None known.

WISCONSIN COORDINATE SYSTEM

North 662,037.767 (or by plan)

East 717,561.816

Theta Angle

Horiz. Order

Vert. Order

DATUM: 1983('91)

TYPE OF LANDMARK


Stone

BEARINGS ARE REFERENCED TO

RECORD OF DURABLE WITNESS MONUMENTS

slope

NO	DESCRIPTION	BEARING	DISTANCE	
1	P.K. nail in double blazed 21" oak	N62°E	50.16	50.15
2	" " " " " 8" hickory	N46°W magnetic = N49°W	46.67	46.98
3	set " " " " 13" oak	N72°W " = N70°W	36.69	36.85
4	ex. " " " " 25" oak	S36°W	29.81	29.70

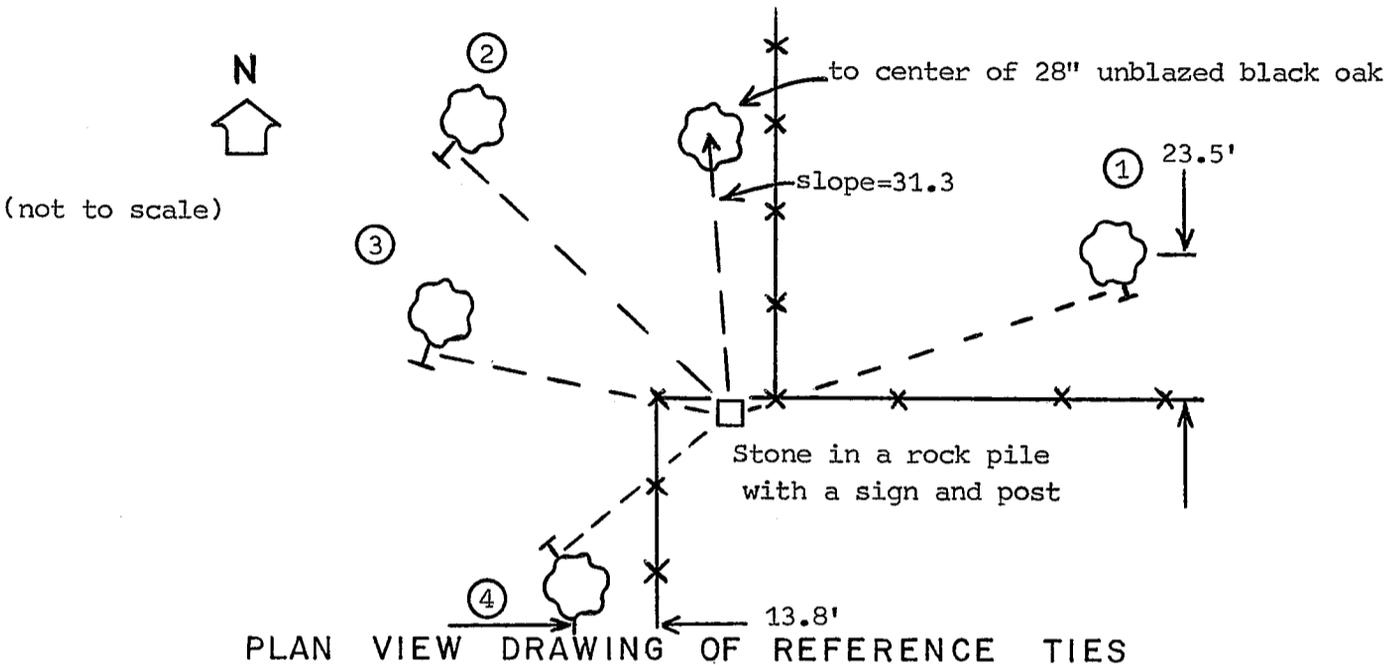

MAP SHOWING DISTANCE AND DIRECTION TO OTHER PUBLIC LAND SURVEY CORNERS USED FOR REESTABLISHING THE CORNER

(no section measurements made by me at this time) (1990)

I, William C. Jung, Deputy County Surveyor,
 HEREBY CERTIFY THAT THE CORNER LOCATION SHOWN ON THIS RECORD
 WAS DETERMINED BY ME OR UNDER MY DIRECTION AND CONTROL AND
 THAT THIS U. S. PUBLIC LAND SURVEY MONUMENT RECORD IS CORRECT
 AND COMPLETE TO THE BEST OF MY KNOWLEDGE AND BELIEF.

William C. Jung
 Signature

October 8, 1990

Date

Revised: 11/15/05 *wej*



Seal