


21605340020

U. S. PUBLIC LAND SURVEY MONUMENT RECORD

SECTION 3 T 15 N, R 5 W, TOWN OF WASHINGTON

LA CROSSE COUNTY

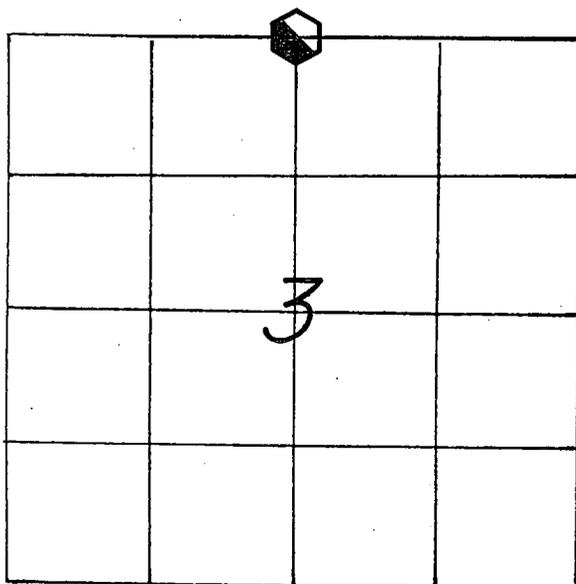

LOCATION OF LANDMARK

CREW: WILLIAM C. JUNG
 PETER F. FOLLANSBEE
 DATE: 10/10/2005

WISCONSIN COORDINATE SYSTEM	
North	662,081.016
East	1,714,923.711
Theta Angle	
Horiz. Order	
Vert. Order	
DATUM:	1983('91)
TYPE OF LANDMARK	
30" ALUMINUM BERNTSEN MARKER.	
BEARINGS ARE REFERENCED TO	
GRID NORTH AS PER SECTION DATA.	

Describe any record evidence, monument evidence, testimonial evidence or any other material evidence you considered and whether the monument was found or restored through acceptance of an obliterated evidence location.


I set the corner at equal distances from the section corners and on line with the old line fence to the East. There is a "kink" at this corner but the distance South to the Center 1/4 fits Middlebrook's 1876 distance very well. I searched at length for Bliss' stone but could not find it. I set a Berntsen marker in a rock pile.

Describe or show any material discrepancy between the location of the restored corner and that of the corner previously restored or reestablished.


NONE KNOWN.

RECORD OF DURABLE WITNESS MONUMENTS

NO	DESCRIPTION	BEARING	DISTANCE
1	SET A 3/4" x 30" IRON BAR WITH A RED PLASTIC CAP	N.'WESTERLY ±	33.57 FT.
2	SET A 3/4" x 30" IRON BAR WITH A RED PLASTIC CAP	EAST ±	11.36 FT.
3	SET A 3/4" x 30" IRON BAR WITH A RED PLASTIC CAP	S.'WESTERLY ±	46.95 FT.
4	SET A 3/4" x 30" IRON BAR WITH A RED PLASTIC CAP	WEST ±	14.49 FT.

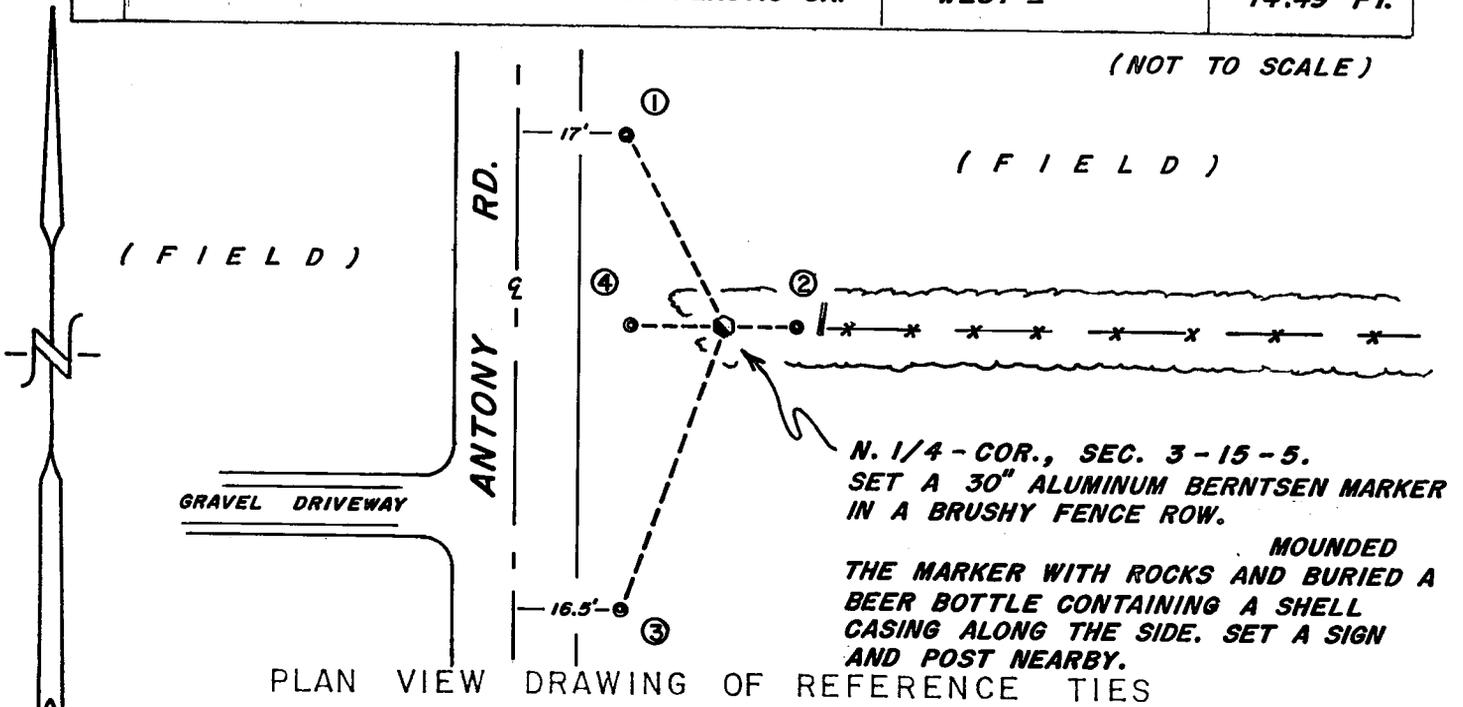

MAP SHOWING DISTANCE AND DIRECTION TO OTHER PUBLIC LAND SURVEY CORNERS USED FOR REESTABLISHING THE CORNER

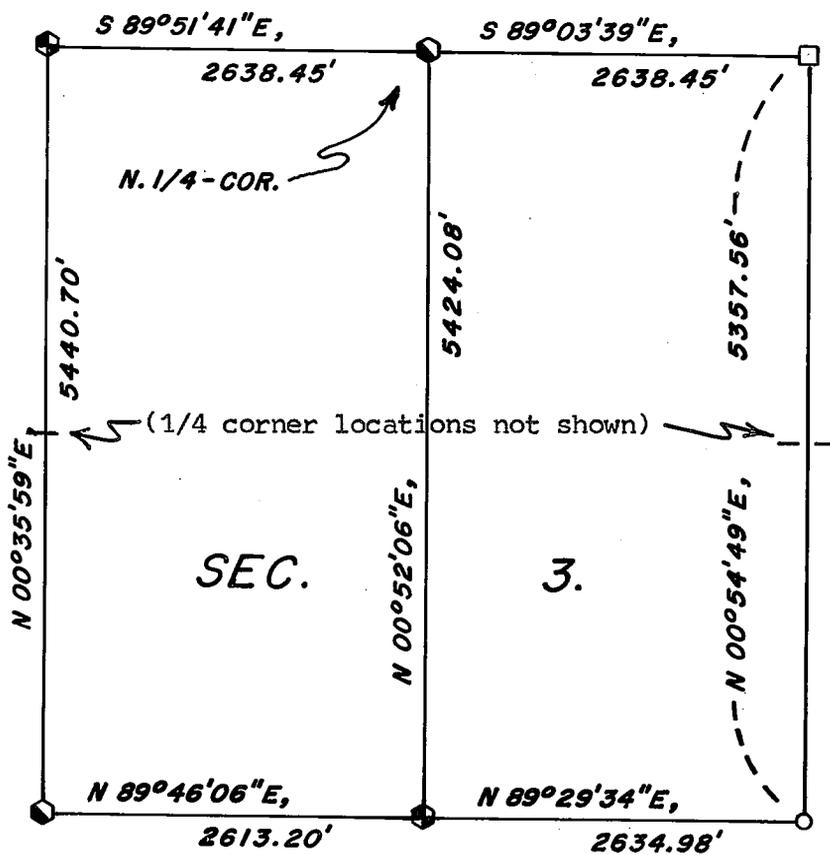

(GRID BEARINGS & DISTANCES)
(GRID FACTOR: 0.9998975)
(NOT TO SCALE)

I, WILLIAM C. JUNG, COUNTY SURVEYOR
HEREBY CERTIFY THAT THE CORNER LOCATION SHOWN ON THIS RECORD
WAS DETERMINED BY ME OR UNDER MY DIRECTION AND CONTROL AND
THAT THIS U. S. PUBLIC LAND SURVEY MONUMENT RECORD IS CORRECT
AND COMPLETE TO THE BEST OF MY KNOWLEDGE AND BELIEF.

William C. Jung
Signature

11/17/05
Date



Seal