


U. S. PUBLIC LAND SURVEY MONUMENT RECORD

SECTION 1 T 15 N, R 5 W, TOWN OF WASHINGTON

LA CROSSE COUNTY

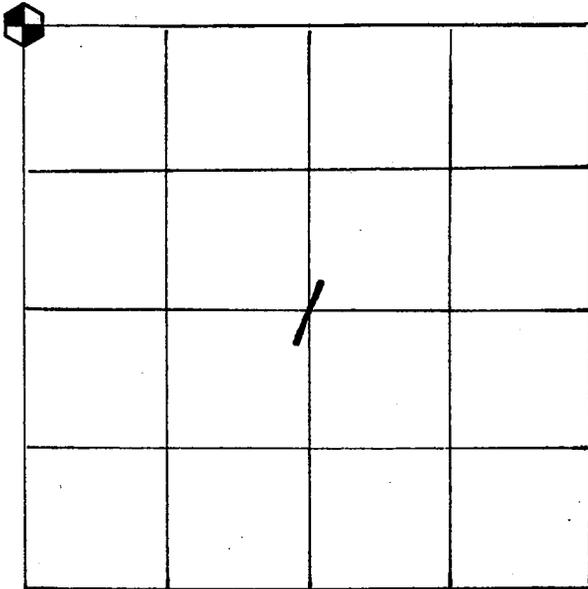

LOCATION OF LANDMARK

Crew: WILLIAM C. JUNG
 PETER F. FOLLANSBEE
 Date: 9/29/1995

WISCONSIN COORDINATE SYSTEM

North

East

Theta Angle

Horiz. Order

Vert. Order

TYPE OF LANDMARK

Berntsen Top in 1-5/8" x 30" Iron Pipe.

BEARINGS ARE REFERENCED TO

Describe any record evidence, monument evidence, testimonial evidence or any other material evidence you considered and whether the monument was found or restored through acceptance of an obliterated evidence location.


I found the old stone broken into many pieces. After a considerable amount of digging, I found the base of the old stone. The base was plumb and intact. I accepted this location as the best available evidence of the original government corner position. It is about 1' South and 2' West of the fence corner. I put a Berntsen top in an iron pipe and set it on top of the old stone base.

The monument was also mounded with rocks.
 Describe or show any material discrepancy between the location of the restored corner and that of the corner previously restored or reestablished.

I do not agree with Clayton Solberg's location of 1981. I found an iron pipe by a piece of the old stone, but this location was about 2 to 3 feet North of the actual corner. It would appear that whoever set the pipe did not dig for the stone.

RECORD OF DURABLE WITNESS MONUMENTS

NO	DESCRIPTION	BEARING	DISTANCE
1	Set P.K. Nail in SE-side 6 1/4" Box Elder	Northwesterly ₊	22.15 Ft.
2	Set P.K. Nail in SW-side 6 1/4" Nut Tree	Northwesterly ₊	8.42 Ft.
3	Set P.K. Nail in S.-side 6 1/4" Elm	Easterly ₊	Sl.=36.85'
4	Set 1-1/4" x 14" Iron Pipe under a rock	South ₊	12.54 Ft.

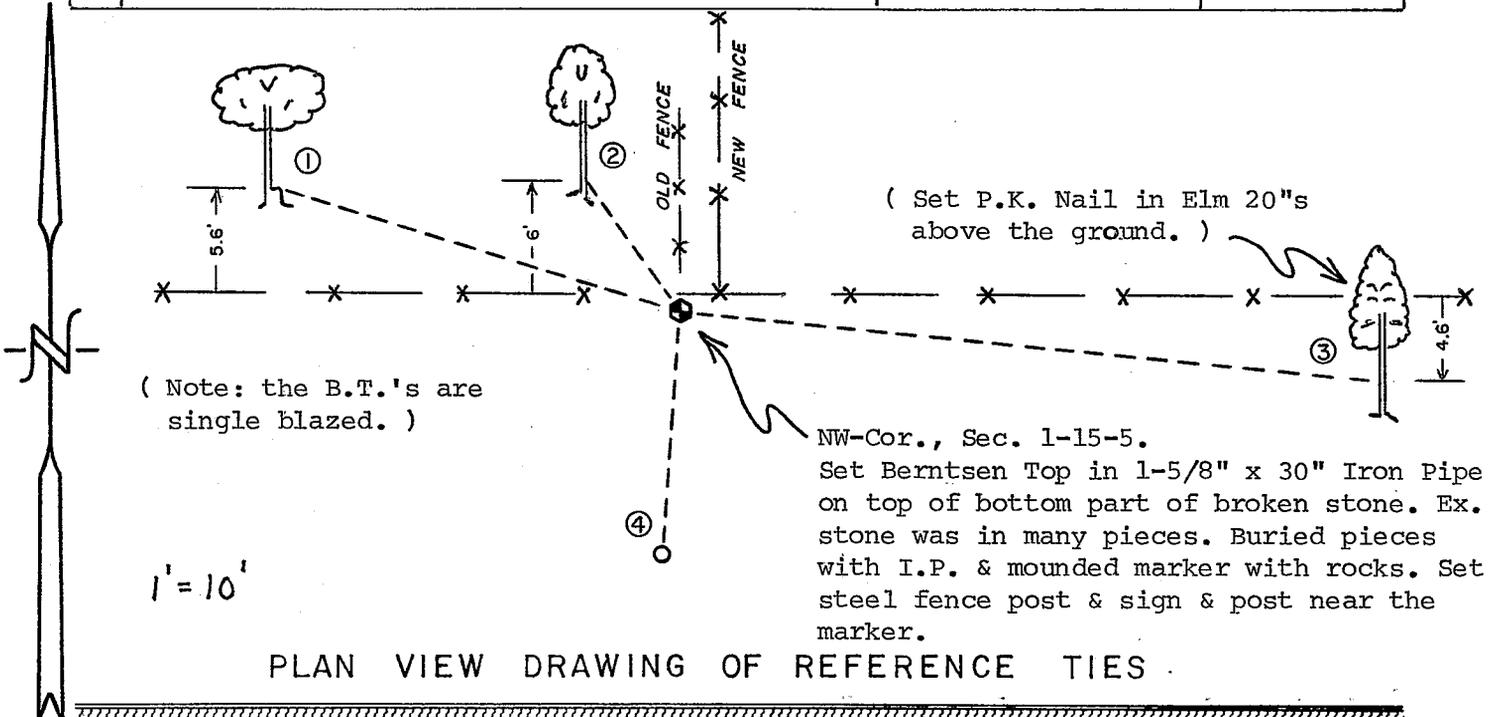

PLAN VIEW DRAWING OF REFERENCE TIES

MAP SHOWING DISTANCE AND DIRECTION TO OTHER PUBLIC LAND SURVEY CORNERS USED FOR REESTABLISHING THE CORNER

No section measurements were made by me at this time.

I, William C. Jung, County Surveyor,
 HEREBY CERTIFY THAT THE CORNER LOCATION SHOWN ON THIS RECORD
 WAS DETERMINED BY ME OR UNDER MY DIRECTION AND CONTROL AND
 THAT THIS U. S. PUBLIC LAND SURVEY MONUMENT RECORD IS CORRECT
 AND COMPLETE TO THE BEST OF MY KNOWLEDGE AND BELIEF.

William C. Jung 10/16/95
 Signature Date



Seal