


21605350020

U. S. PUBLIC LAND SURVEY MONUMENT RECORD

SECTION 2 T 15 N, R 5 W, TOWN OF WASHINGTON

LA CROSSE COUNTY

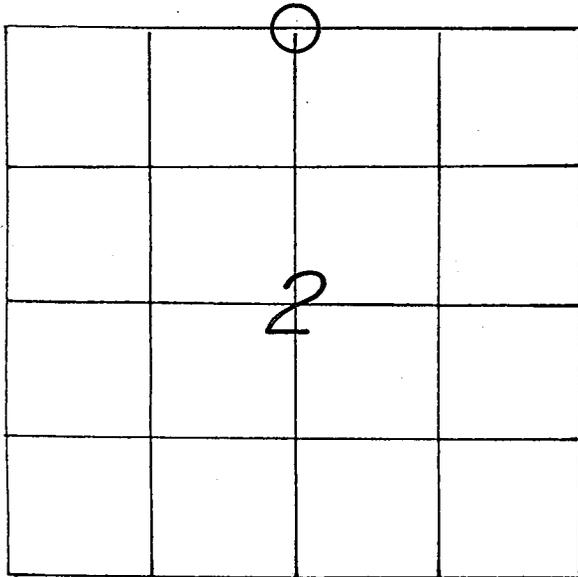

LOCATION OF LANDMARK

CREW: **WILLIAM C. JUNG**
PETER F. FOLLANSBEE
 DATE: **6/05/2007**

WISCONSIN COORDINATE SYSTEM

North

East

Theta Angle

Horiz. Order

Vert. Order

TYPE OF LANDMARK

1" (O.D.) IRON PIPE.

BEARINGS ARE REFERENCED TO

Describe any record evidence, monument evidence, testimonial evidence or any other material evidence you considered and whether the monument was found or restored through acceptance of an obliterated evidence location.


We found Watts' pipe from 1983 and took new ties. The old stone remnants were around the pipe. These remnants would be from Bliss' 1867 stone.

Describe or show any material discrepancy between the location of the restored corner and that of the corner previously restored or reestablished.

NONE KNOWN.

RECORD OF DURABLE WITNESS MONUMENTS

| NO | DESCRIPTION | MAGNETIC | |
|----|---|----------|---------------|
| | | BEARING | DISTANCE |
| 1 | SET A NAIL IN S.W.-SIDE OF A 4" HICKORY | N 70° W | 6.70 FT. |
| 2 | SET A NAIL IN W.-SIDE OF AN 11" HICKORY | N 05° E | 3.13 FT. |
| 3 | SET A NAIL IN E.-SIDE OF A 7" HICKORY | S 07° W | SLOPE= 21.88' |
| 4 | SET A NAIL IN S.E.-SIDE OF A 4" OAK | S 29° W | 23.24 FT. |

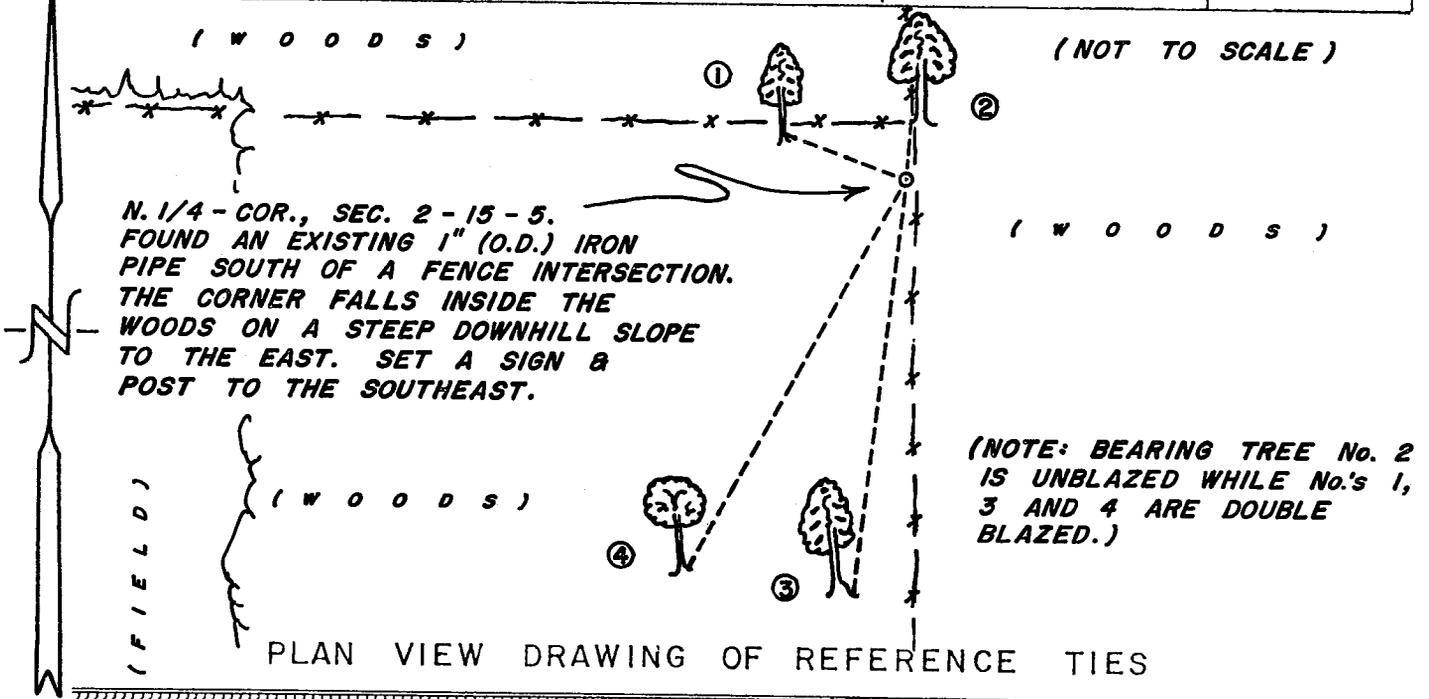

MAP SHOWING DISTANCE AND DIRECTION TO OTHER PUBLIC LAND SURVEY CORNERS USED FOR REESTABLISHING THE CORNER

I made no further section measurements at this time. Measurements of record confirm the location of this pipe.

I, WILLIAM C. JUNG, COUNTY SURVEYOR
 HEREBY CERTIFY THAT THE CORNER LOCATION SHOWN ON THIS RECORD WAS DETERMINED BY ME OR UNDER MY DIRECTION AND CONTROL AND THAT THIS U. S. PUBLIC LAND SURVEY MONUMENT RECORD IS CORRECT AND COMPLETE TO THE BEST OF MY KNOWLEDGE AND BELIEF.

William C. Jung
 Signature

7/11/07
 Date



Seal

RECORD OF LAND CORNER PERPETUATION

No.

STATE OF WISCONSIN

County of La Crosse } ss.

I, Gary A. Watts, hereby certify that the information shown hereon correctly describes the original corner, resurvey information, evidence found, type of monument found or placed, and witness monuments and accessories used to perpetuate the location of the original or established corner.

| | | |
|---------------------|-----------|---------------|
| COUNTY | | |
| <u>La Crosse</u> | | |
| TOWN | | |
| <u>Washington</u> | | |
| HIGHWAY | | |
| SECTION | TOWNSHIP | RANGE |
| <u>2</u> | <u>15</u> | <u>5 West</u> |
| TYPE OF LANDMARK | | |
| <u>1" iron pipe</u> | | |

Dated this 17th day of Oct., 1983


at La Crosse, Wisconsin.

Gary A. Watts
Registered Land Surveyor
 Title


Date of Survey MAY 1983

Drafted by GAW

Date Oct. 1983

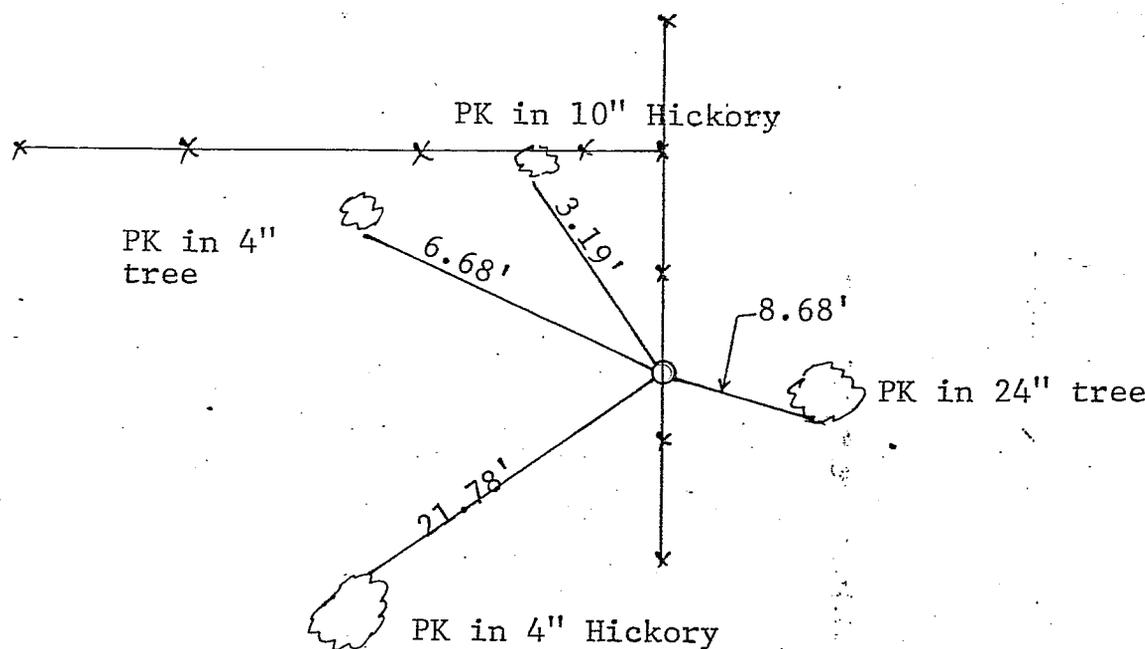

| WISCONSIN COORDINATE SYSTEM | |
|-----------------------------|-------------|
| North | Zone |
| East | |
| Elevation | Theta Angle |
| Vertical control order | |
| Horizontal control order | |

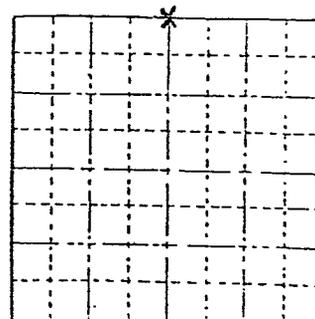

REMARKS: Stone found in pieces. Set 1" iron pipe

LOCATION SKETCH
 (Location of landmark indicated by "x")

