


21605360020

U. S. PUBLIC LAND SURVEY MONUMENT RECORD

SECTION 1 T 15 N, R 5 W, TOWN OF WASHINGTON

LA CROSSE COUNTY

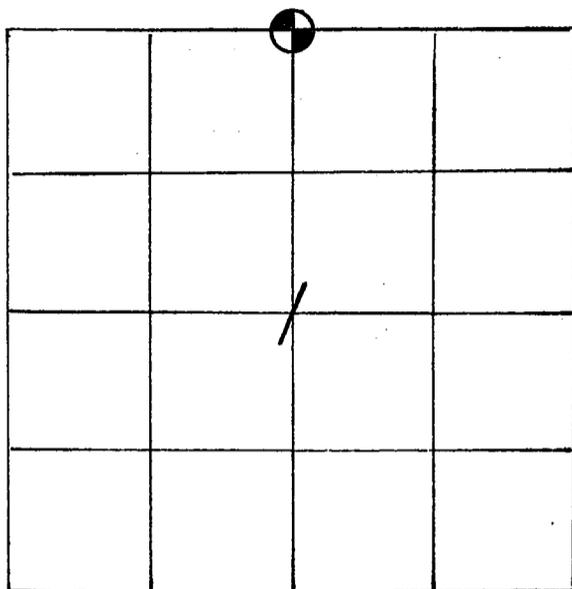

LOCATION OF LANDMARK

Crew: WILLIAM C. JUNG
 PETER F. FOLLANSBEE
 Date: 7/16/1997

Describe any record evidence, monument evidence, testimonial evidence or any other material evidence you considered and whether the monument was found or restored through acceptance of an obliterated evidence location.

After a great deal of searching we found the remnants of the old 1867 stone. I plumbed up the 3 broken remnant pieces and set a "shorty" Berntsen top in the middle of the pieces and mounded it all with rocks.

Describe or show any material discrepancy between the location of the restored corner and that of the corner previously restored or reestablished.

None Known.

WISCONSIN COORDINATE SYSTEM

North

East

Theta Angle

Horiz. Order

Vert. Order

TYPE OF LANDMARK

Berntsen Top in rockpile.

BEARINGS ARE REFERENCED TO

GRID NORTH


RECORD OF DURABLE WITNESS MONUMENTS
MAGNETIC

NO	DESCRIPTION	BEARING	DISTANCE
1	Set P.K. Nail in SE-side 6" nut tree	S 52°W	Sl.= 45.71'
2	Set P.K. Nail in N.-side 3" nut tree	N 77°E	Sl.= 51.41'
3	Set P.K. Nail in SW-side 24" Birch tree	S 73°E	Sl.=136.02'
4	Set P.K. Nail in E.-side 8¼" nut tree	S 10°W	Sl.= 34.25'

N.¼-Cor., Sec. 1-15-5.

Found the stone broken in 3 pieces with the top missing. Plumbed it up, set a Berntsen Top in the middle of the pieces as the new corner point, buried a wine bottle on the north side and mounded everything together with rocks. The corner falls on a steep rocky sidehill facing the N.-east.


(Not to scale)

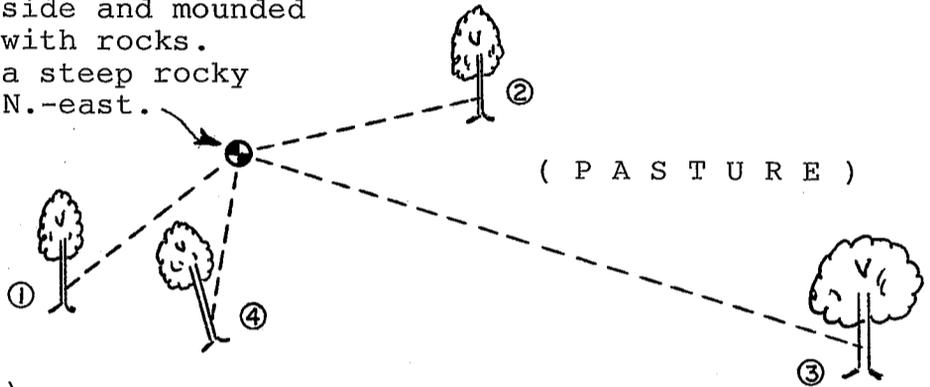

(Note: the Bearing Trees are unblazed.)

PLAN VIEW DRAWING OF REFERENCE TIES


MAP SHOWING DISTANCE AND DIRECTION TO OTHER PUBLIC LAND SURVEY CORNERS USED FOR REESTABLISHING THE CORNER

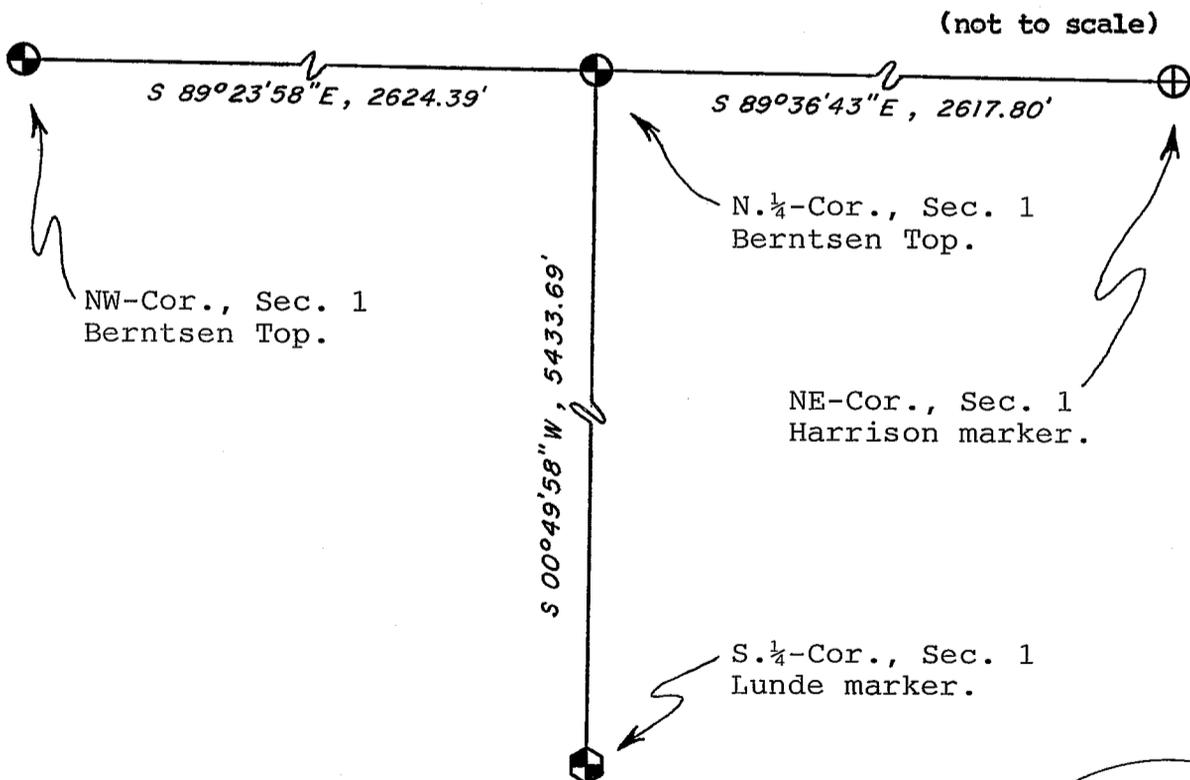

I, William C. Jung, County Surveyor
HEREBY CERTIFY THAT THE CORNER LOCATION SHOWN ON THIS RECORD WAS DETERMINED BY ME OR UNDER MY DIRECTION AND CONTROL AND THAT THIS U. S. PUBLIC LAND SURVEY MONUMENT RECORD IS CORRECT AND COMPLETE TO THE BEST OF MY KNOWLEDGE AND BELIEF.

William C. Jung
Signature

7/25/97
Date

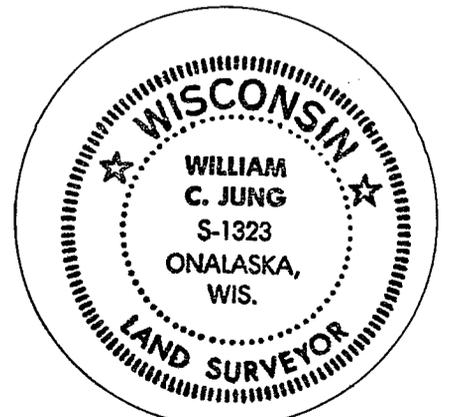

Seal