


21506010000

## U. S. PUBLIC LAND SURVEY MONUMENT RECORD

SECTION 12 T 15 N, R 6 W, TOWN OF Greenfield

LA CROSSE COUNTY

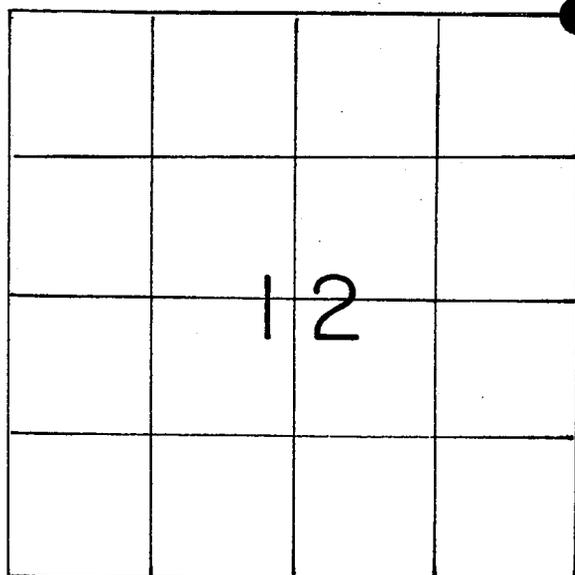

LOCATION OF LANDMARK

Crew: William C. Jung  
Peter F. Follansbee

Date: January 29, 1991

Describe any record evidence, monument evidence, testimonial evidence or any other material evidence you considered and whether the monument was found or restored through acceptance of an obliterated evidence location.

I found a white oak to the Southeast which I feel is an original bearing tree from the township survey of T15N-R5W. I set the corner off this tree. To the Northwest I found a blackened stump which may be remnants of another original bearing tree, or at least second growth. I set a brass capped Lunde marker, up 6", in a small mound of earth and rocks. I also buried a whiskey bottle with an empty shell casing on the Southeast side of the Lunde.

Describe or show any material discrepancy between the location of the restored corner and that of the corner previously restored or reestablished.

None known.

Note: "Local Lore and Legend"

This corner falls in what is shown on the maps as Moonshine Hollow. Lawrence Malzacher says that it was named after "Moonshine Miller" who had a still in his house in this coulee. The stone ruins of this house are South of the creek and Southwest of the section corner. Miller supposedly was also a chicken thief and had no visible means of support other than his moonshine. Malzacher related how his father told of Miller stealing chickens from him during the night. When Miller finally moved out of the coulee, Malzacher gladly helped him!

## WISCONSIN COORDINATE SYSTEM

North

East

Theta Angle

Horiz. Order

Vert. Order

## TYPE OF LANDMARK


Brass capped Lunde marker

## BEARINGS ARE REFERENCED TO

True

RECORD OF DURABLE WITNESS MONUMENTS


NO	DESCRIPTION	Magnetic	
		BEARING	DISTANCE
1	P.K. nail in single blazed 18" oak	N21°E	30.49
2	" 26" white oak	S66°E	11.29
3	" 30" " "	S 6°E	slope=55.46
4	" 32" " "	S 5°E	slope=97.03

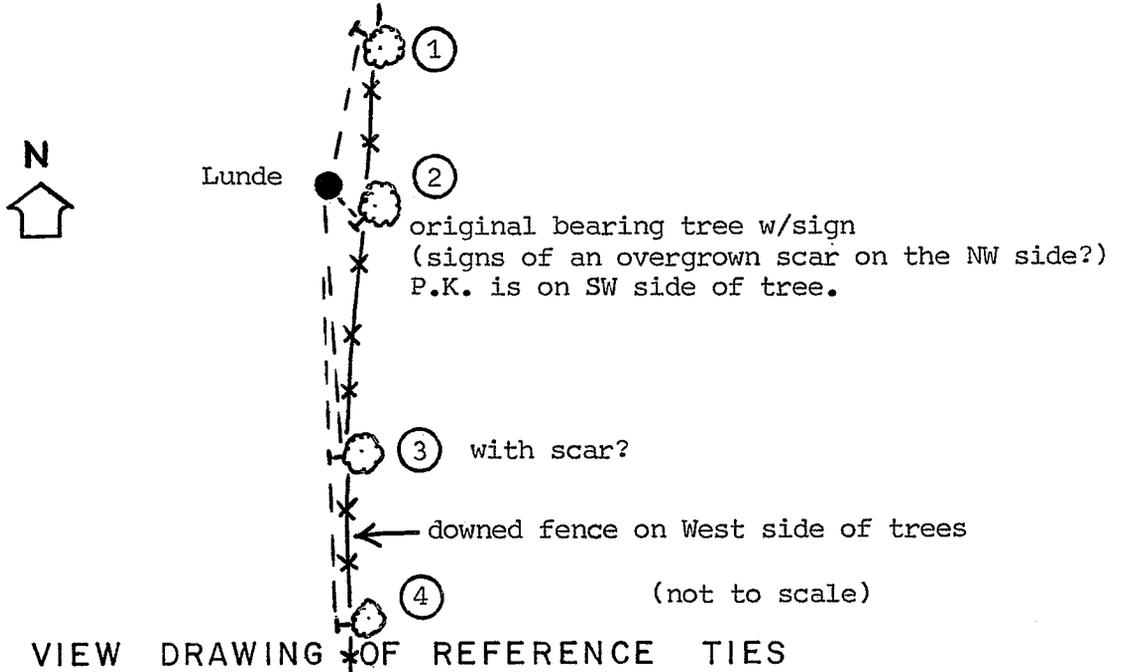

PLAN VIEW DRAWING OF REFERENCE TIES

MAP SHOWING DISTANCE AND DIRECTION TO OTHER PUBLIC LAND SURVEY CORNERS USED FOR REESTABLISHING THE CORNER

(not to scale)

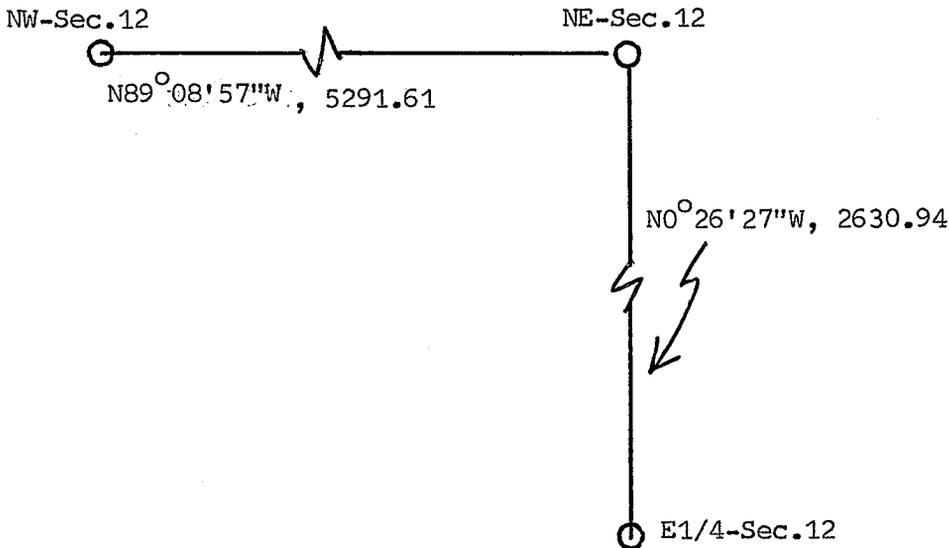

I, William C. Jung, Deputy County Surveyor,  
 HEREBY CERTIFY THAT THE CORNER LOCATION SHOWN ON THIS RECORD  
 WAS DETERMINED BY ME OR UNDER MY DIRECTION AND CONTROL AND  
 THAT THIS U. S. PUBLIC LAND SURVEY MONUMENT RECORD IS CORRECT  
 AND COMPLETE TO THE BEST OF MY KNOWLEDGE AND BELIEF.

William C. Jung January 31, 1991  
 Signature Date



Seal