


# LA CROSSE COUNTY, WISCONSIN

## U. S. PUBLIC LAND SURVEY MONUMENT RECORD

### SOUTH ¼ CORNER, SECTION 1, T15N, R6W, TOWN OF GREENFIELD

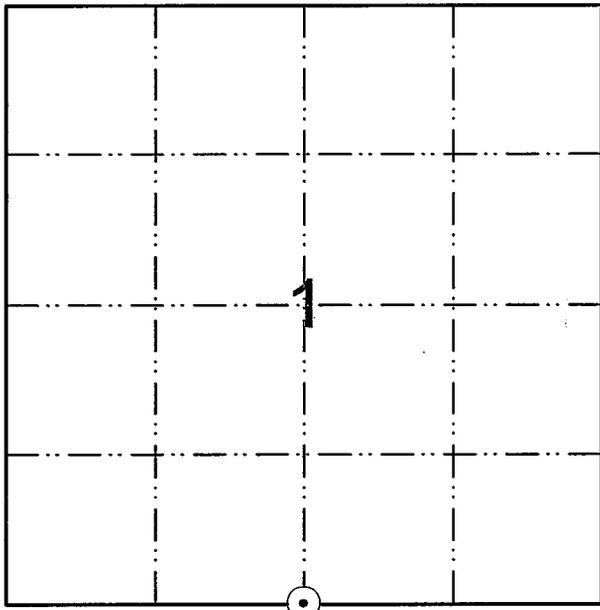

⊙ = LOCATION OF LANDMARK

**PLAN VIEW OF REFERENCE TIES:**  
NO SCALE


WISCONSIN COORDINATE SYSTEM

NORTH: 656,845.991  
EAST: 1,693,630.156

TYPE OF MONUMENT: Set 3/4" x 30" round iron bar with aluminum cap

BEARINGS REFERENCED TO: Grid North

CREW: Bryan Meyer and Pete Follansbee  
DATE: August 19, 2009  
WEATHER: Partly Cloudy, 75°

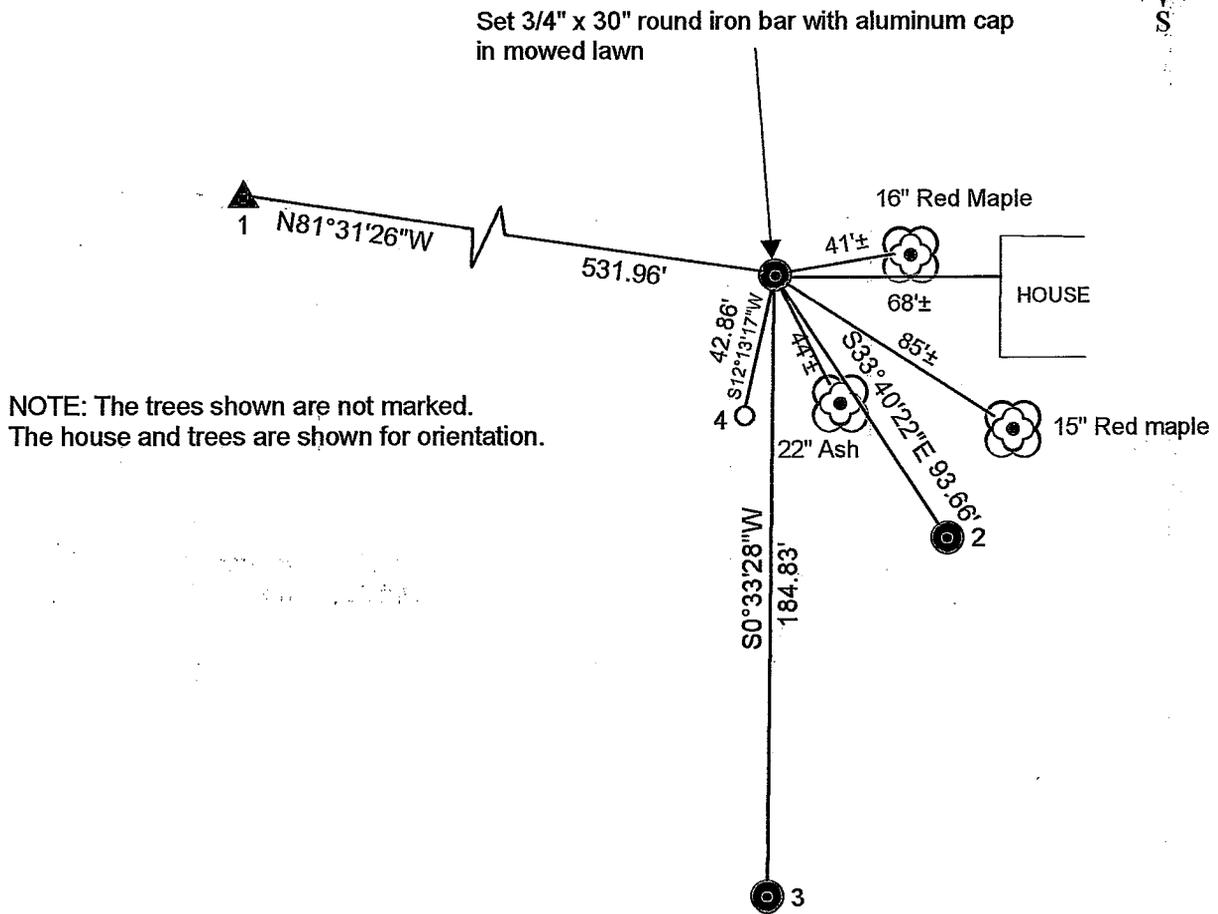


**WITNESS TIES:**

- 1 = Existing GPS Marker (Malzacher GPS) brass disc in concrete
- 2 = Existing 3/4" round iron bar
- 3 = Existing 3/4" round iron bar
- 4 = Existing 4" iron pipe, up 3'±

MAP SHOWING DISTANCE AND DIRECTION TO OTHER PUBLIC LAND SURVEY CORNERS AND USED FOR REESTABLISHING THE CORNER:

NO SCALE  
GRID BEARINGS AND DISTANCES

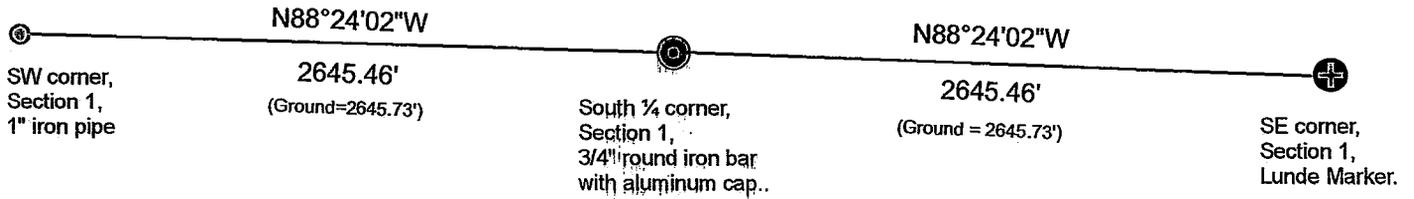

DESCRIBE ANY RECORD EVIDENCE, MONUMENT EVIDENCE, TESTIMONIAL EVIDENCE OR ANY OTHER MATERIAL EVIDENCE YOU CONSIDERED AND WHETHER THE MONUMENT WAS FOUND OR RESTORED THROUGH ACCEPTANCE OF AN OBLITERATED EVIDENCE LOCATION:


Set this corner on line and at equidistant distance between the Southeast and Southwest corners of Section 1.

DESCRIBE OR SHOW ANY MATERIAL DISCREPANCY BETWEEN THE LOCATION OF THE RESTORED CORNER AND THAT OF THE CORNER PREVIOUSLY RESTORED OR REESTABLISHED

None.

CERTIFICATE:

I, Bryan H. Meyer, County Surveyor, hereby certify that the corner location shown on this record was determined by me or under my direction and control and that this U. S. Public Land Survey Monument Record is correct and complete to the best of my knowledge and belief.

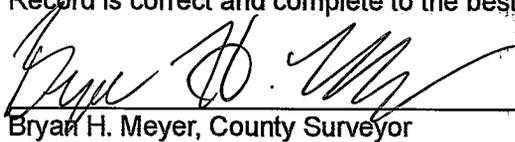  
Bryan H. Meyer, County Surveyor

2/22/2010  
Date

