


U. S. PUBLIC LAND SURVEY MONUMENT RECORD

SECTION 1 T 15 N, R 6 W, TOWN OF GREENFIELD  
 LA CROSSE COUNTY

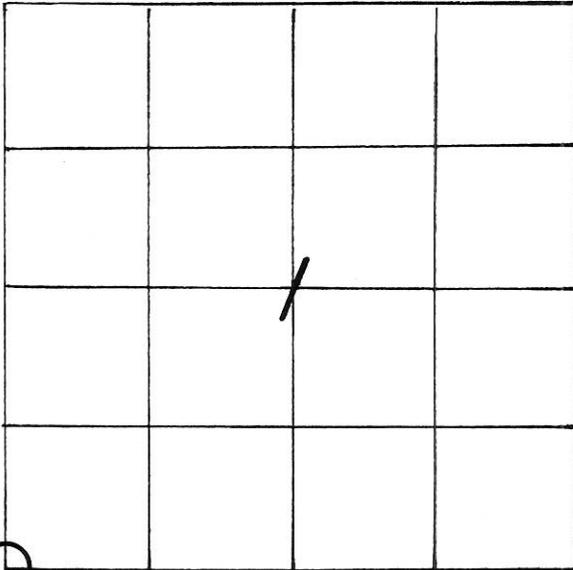

LOCATION OF LANDMARK

**CREW: BRYAN H. MEYER  
 PETER F. FOLLANSBEE  
 DATE: 8/13/2009**

WISCONSIN COORDINATE SYSTEM	
North	<b>656,919.833</b>
East	<b>1,690,985.725</b>
Theta Angle	
Horiz. Order	
Vert. Order	
<b>DATUM:</b>	<b>NAD 1983('91)</b>
TYPE OF LANDMARK	
<b>1" x 30" IRON PIPE.</b>	
BEARINGS ARE REFERENCED TO	
<b>GRID NORTH AS PER SECTION DATA.</b>	


Describe any record evidence, monument evidence, testimonial evidence or any other material evidence you considered and whether the monument was found or restored through acceptance of an obliterated evidence location.

Describe or show any material discrepancy between the location of the restored corner and that of the corner previously restored or reestablished.

RECORD OF DURABLE WITNESS MONUMENTS


MAGNETIC

NO	DESCRIPTION	BEARING	DISTANCE
1	SET A 3/4"x 30" IRON BAR WITH A RED PLASTIC CAP	N 74° W	11.79 FT.
2	SET A NEW NAIL IN S.-SIDE OF AN 18" HICKORY	S 62° E	SLOPE=39.57'
3	SET A NAIL IN S.-SIDE OF AN 18-1/2" RED OAK	S 53° E	SLOPE=63.00'
4	SET A NAIL IN N.-SIDE OF A 27" RED OAK	S 32° E	SLOPE=69.92'

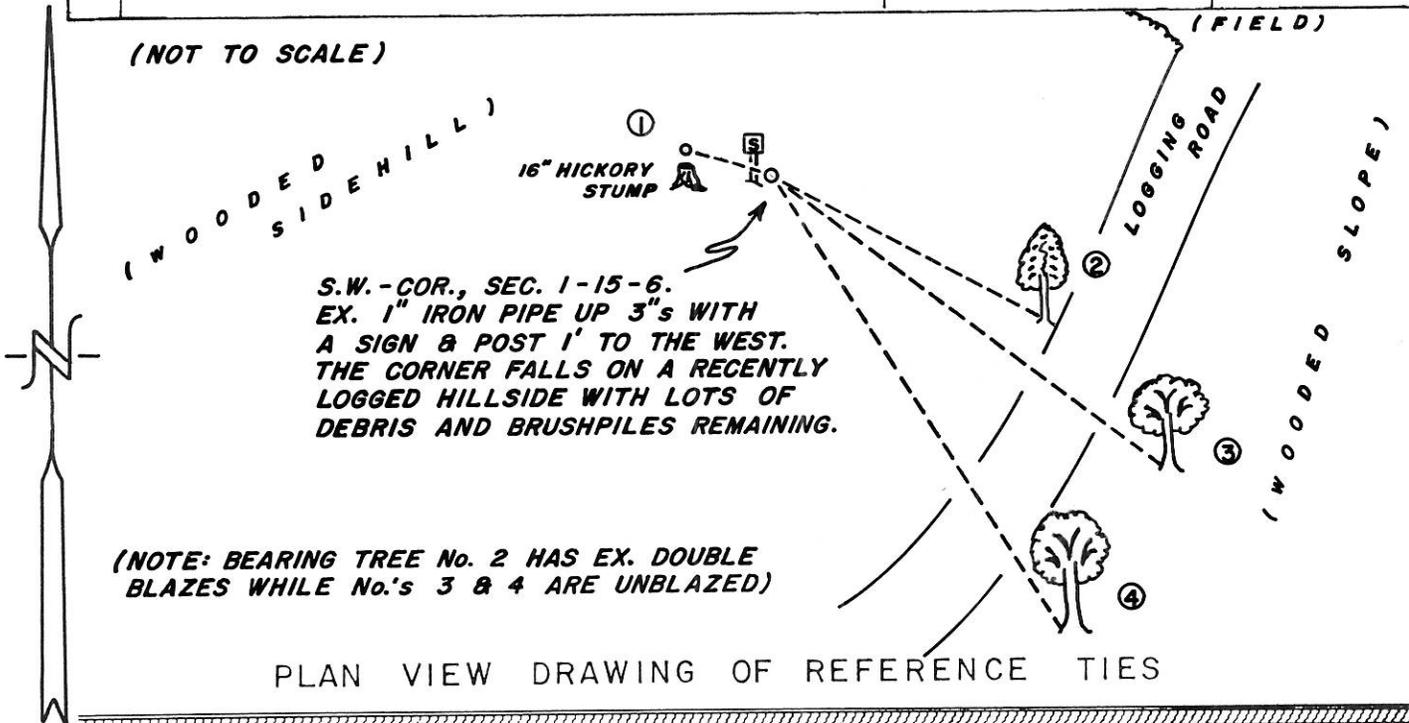

MAP SHOWING DISTANCE AND DIRECTION TO OTHER PUBLIC LAND SURVEY CORNERS USED FOR REESTABLISHING THE CORNER

(GRID BEARINGS AND DISTANCES)  
(GRID FACTOR: 0.9998964)  
(NOT TO SCALE)

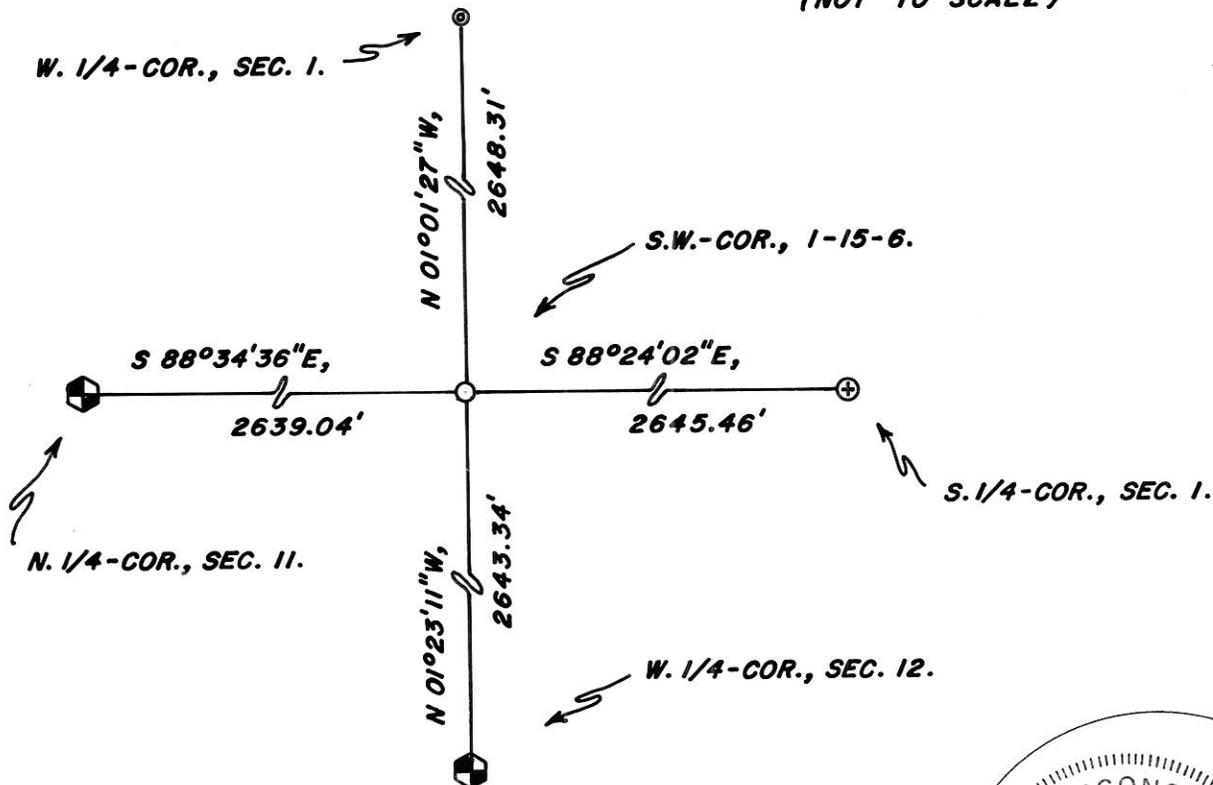

I, BRYAN H. MEYER, COUNTY SURVEYOR  
HEREBY CERTIFY THAT THE CORNER LOCATION SHOWN ON THIS RECORD  
WAS DETERMINED BY ME OR UNDER MY DIRECTION AND CONTROL AND  
THAT THIS U. S. PUBLIC LAND SURVEY MONUMENT RECORD IS CORRECT  
AND COMPLETE TO THE BEST OF MY KNOWLEDGE AND BELIEF.

Signature

Date




Seal

21506020000

## U. S. PUBLIC LAND SURVEY MONUMENT RECORD

SECTION 12 T 15 N, R 6 W, TOWN OF Greenfield

LA CROSSE COUNTY

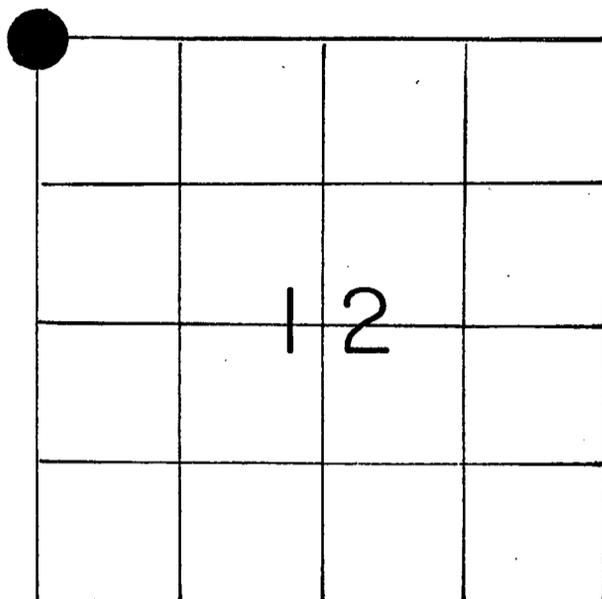

LOCATION OF LANDMARK

Crew: William C. Jung  
Peter F. Follansbee

Date: February 1, 1991

Describe any record evidence, monument evidence, testimonial evidence or any other material evidence you considered and whether the monument was found or restored through acceptance of an obliterated evidence location.

I set this corner by double proportionate measurement. The corner was lost with no evidence of the original government corner position. I set an iron pipe at the corner.


Describe or show any material discrepancy between the location of the restored corner and that of the corner previously restored or reestablished.

None known.

WISCONSIN COORDINATE SYSTEM
North
East
Theta Angle
Horiz. Order
Vert. Order
TYPE OF LANDMARK
1"x30" iron pipe
BEARINGS ARE REFERENCED TO
True

RECORD OF DURABLE WITNESS MONUMENTS  
Magnetic

NO	DESCRIPTION	BEARING	DISTANCE
1	P.K. nail in double blazed 9" hickory	N31°W	22.89
2	" 11" white oak	N44°W	14.50
3	" 10" hickory	N76°W	12.00
4	" 14"± hickory	S60°E	slope=39.60

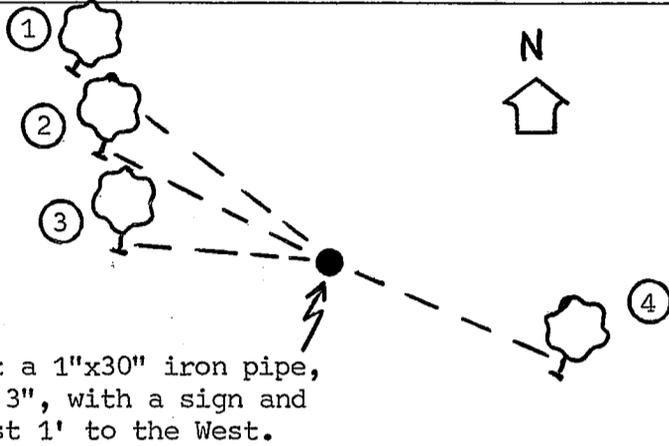


(not to scale)

PLAN VIEW DRAWING OF REFERENCE TIES



MAP SHOWING DISTANCE AND DIRECTION TO OTHER PUBLIC LAND SURVEY CORNERS USED FOR REESTABLISHING THE CORNER


(not to scale)

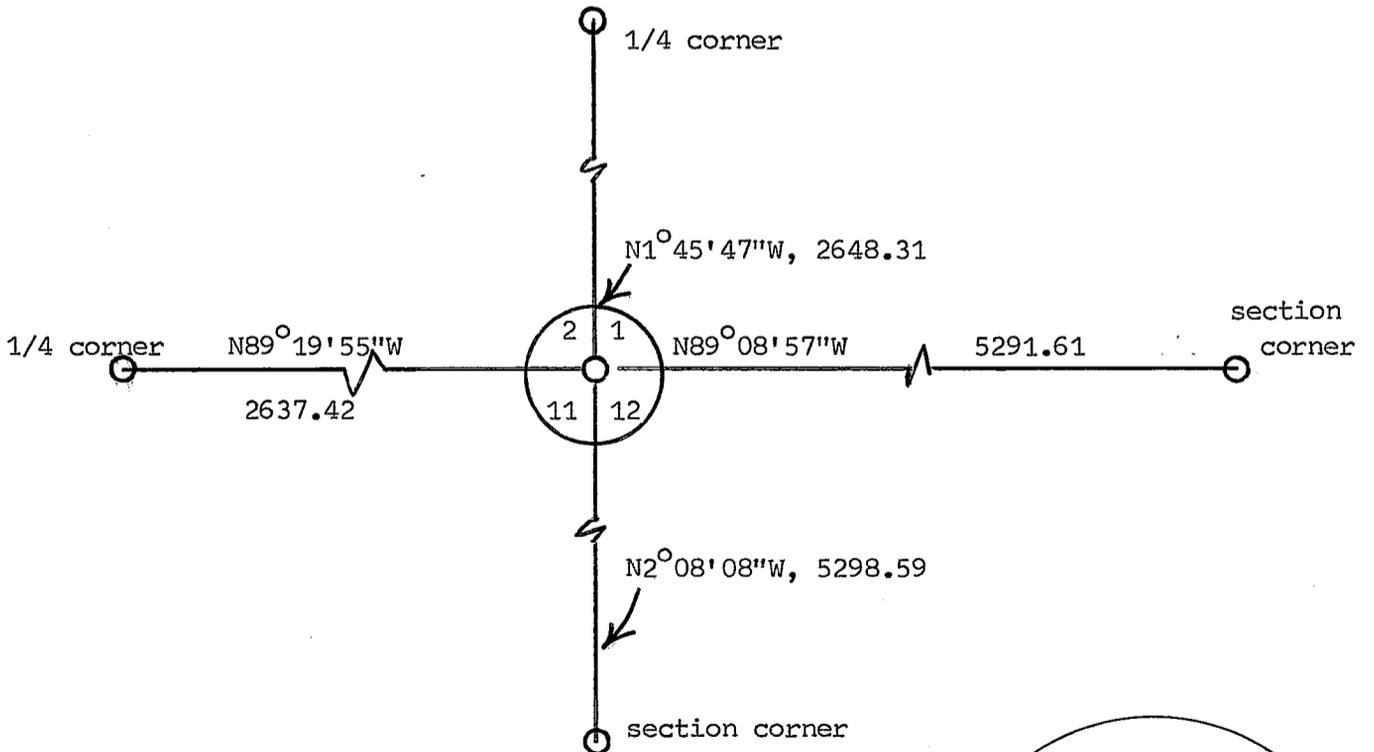

I, William C. Jung, Deputy County Surveyor,  
HEREBY CERTIFY THAT THE CORNER LOCATION SHOWN ON THIS RECORD  
WAS DETERMINED BY ME OR UNDER MY DIRECTION AND CONTROL AND  
THAT THIS U. S. PUBLIC LAND SURVEY MONUMENT RECORD IS CORRECT  
AND COMPLETE TO THE BEST OF MY KNOWLEDGE AND BELIEF.

William C. Jung  
Signature

February 5, 1991  
Date

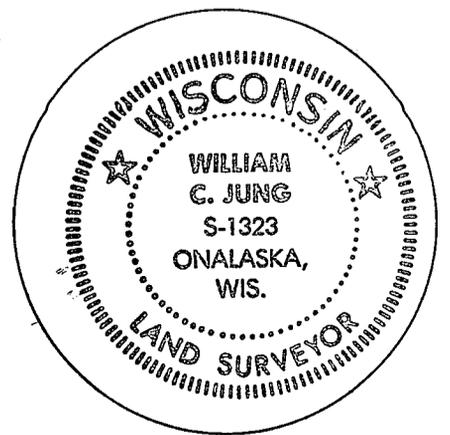

Seal