


U. S. PUBLIC LAND SURVEY MONUMENT RECORD

SECTION 2 T 15 N, R 6 W, TOWN OF Greenfield

LA CROSSE COUNTY

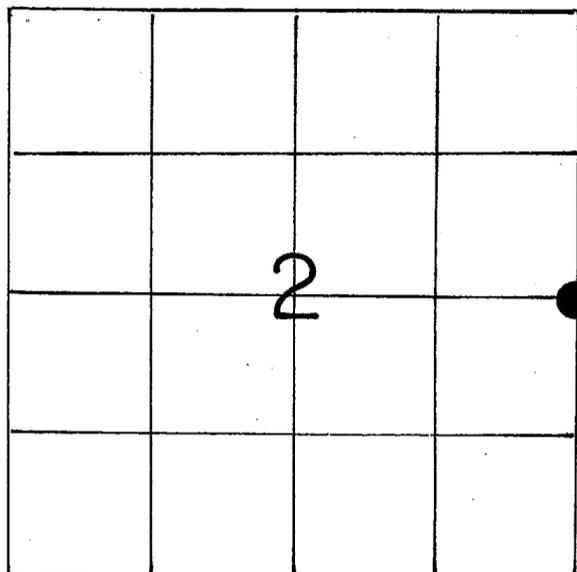

LOCATION OF LANDMARK

Crew: William C. Jung
Peter F. Follansbee

Date: February 1, 1991

Describe any record evidence, monument evidence, testimonial evidence or any other material evidence you considered and whether the monument was found or restored through acceptance of an obliterated evidence location.

I set the corner at a computed location, on line with the old occupied line to the North and proportionally between the section corners. A 1953 highway* shows that the old line to the North has not changed. This also fits the line fence and Marcou's work further North near the Town line. This puts a "kink" at this corner. There was not a "kink" in the original notes, however I have found during the course of remonumentation that a "kink" is quite common at the closing 1/4 corners on the North and West sides of the township.

*map


Describe or show any material discrepancy between the location of the restored corner and that of the corner previously restored or reestablished.

None known.

WISCONSIN COORDINATE SYSTEM
North
East
Theta Angle
Horiz. Order
Vert. Order
TYPE OF LANDMARK
P.K. nail
BEARINGS ARE REFERENCED TO
True


RECORD OF DURABLE WITNESS MONUMENTS
Magnetic

NO	DESCRIPTION	BEARING	DISTANCE
1	Set 1" iron pipe, flush	-----	19.58
2	Set 2" iron pipe	N11°E	42.75
3	P.K. nail in double blazed 7" aspen	N49°W	slope=105.17
4	" 9" white oak	N50°W	slope=141.22

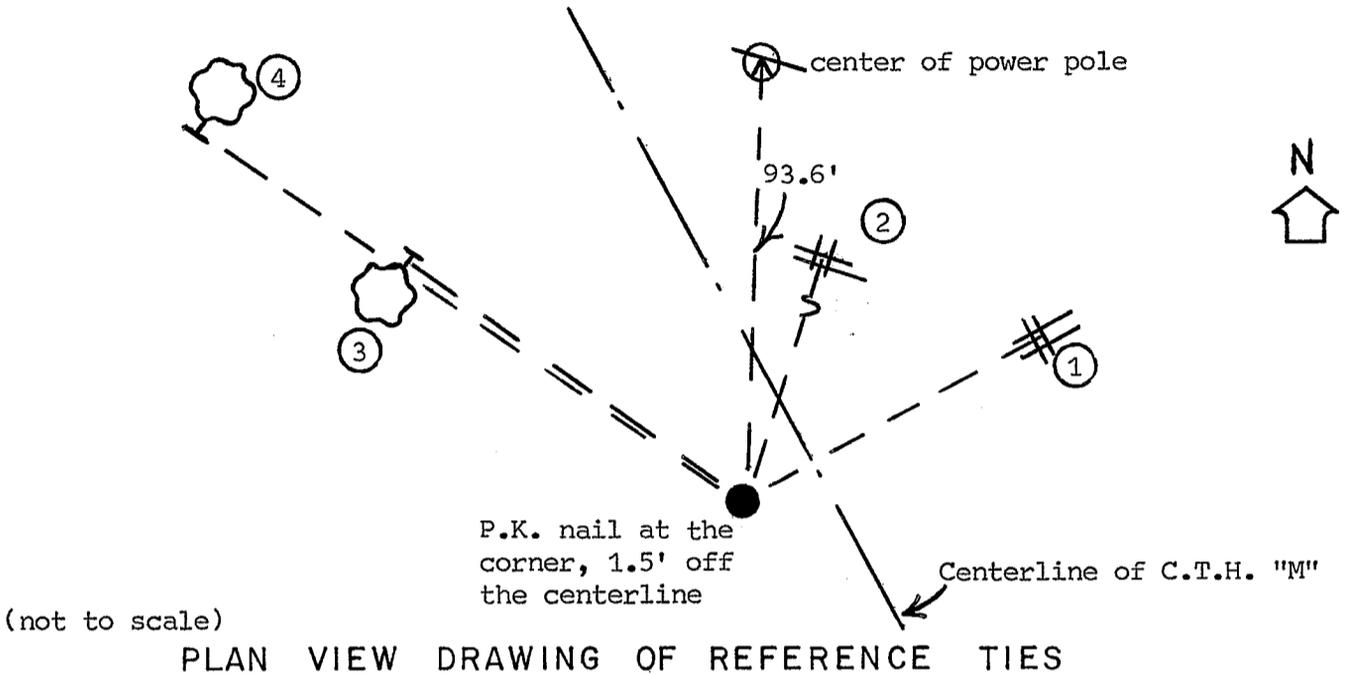

MAP SHOWING DISTANCE AND DIRECTION TO OTHER PUBLIC LAND SURVEY CORNERS USED FOR REESTABLISHING THE CORNER

(not to scale)

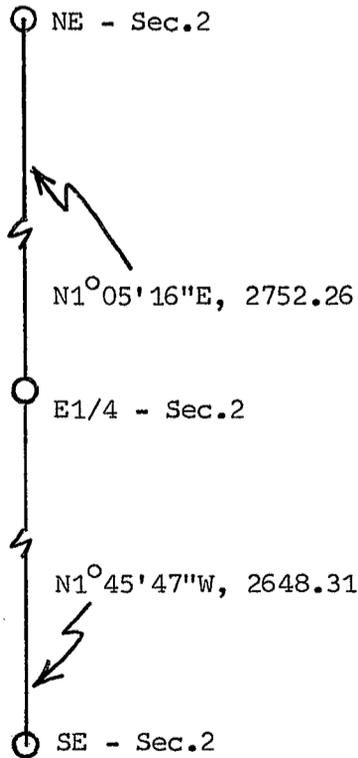

I, William C. Jung, Deputy County Surveyor,
HEREBY CERTIFY THAT THE CORNER LOCATION SHOWN ON THIS RECORD
WAS DETERMINED BY ME OR UNDER MY DIRECTION AND CONTROL AND
THAT THIS U. S. PUBLIC LAND SURVEY MONUMENT RECORD IS CORRECT
AND COMPLETE TO THE BEST OF MY KNOWLEDGE AND BELIEF.

William C. Jung
Signature

February 6, 1991
Date

