


## U. S. PUBLIC LAND SURVEY MONUMENT RECORD

SECTION 3 T 15 N, R 6 W, TOWN OF GREENFIELD

LA CROSSE COUNTY

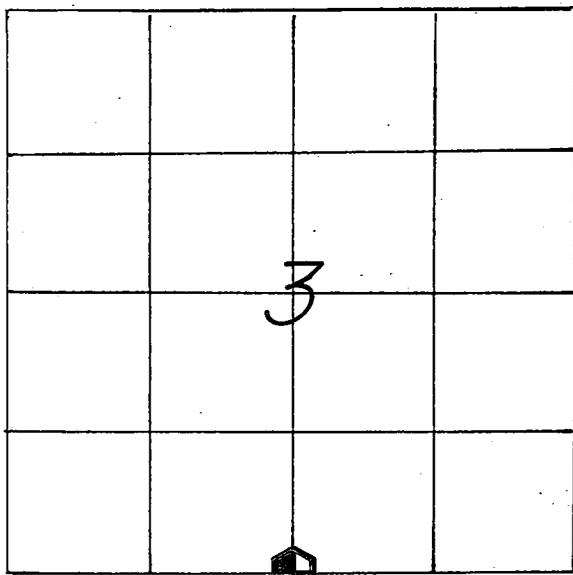

LOCATION OF LANDMARK

CREW: WILLIAM C. JUNG  
 PETER F. FOLLANSBEE  
 DATE: 7/3/2002

## WISCONSIN COORDINATE SYSTEM

North 656,965.858

East 1,683,096.809

Theta Angle

Horiz. Order

Vert. Order

DATUM: 1983('91)

TYPE OF LANDMARK

BRASS CAP LUNDE MARKER.

BEARINGS ARE REFERENCED TO

GRID NORTH AS PER SECTION DATA.

Describe any record evidence, monument evidence, testimonial evidence or any other material evidence you considered and whether the monument was found or restored through acceptance of an obliterated evidence location.

After surveying out Section 3, evaluating all the field evidence, and discussing this corner with Rodney Loging and Laverne Clements, both longtime residents, I accepted the old occupied corner as the best available evidence of the original government corner position. I monumented the corner with a brass capped Lunde marker.

Describe or show any material discrepancy between the location of the restored corner and that of the corner previously restored or reestablished.

This does not agree with Steve Solberg's 1991 corner position. If he set a monument, I could not find it.


RECORD OF DURABLE WITNESS MONUMENTS  
MAGNETIC

NO	DESCRIPTION	BEARING	DISTANCE
1	SET A NAIL IN S.E.-SIDE OF A 4" NUT TREE	N 04° E ±	23.27 FT.
2	SET A NAIL IN S.E.-SIDE OF AN 8-1/2" NUT TREE	N 25° E ±	25.65 FT.
3	SET A NAIL IN N.E.-SIDE OF A 10-1/2" OAK	S 54° E ±	20.54 FT.
4	SET A NAIL IN S.E.-SIDE OF A 16-1/2" BASSWOOD	S 18° W ±	9.95 FT.

S. 1/4 - COR., SEC. 3 - 15 - 6.  
SET A BRASS CAP LUNDE MARKER 6" S  
WEST OF THE FENCE CORNER POST.  
THE MARKER SET AT A SLIGHT ANGLE TO  
THE SOUTH BECAUSE OF ROCKS. BURIED  
A BRANDY BOTTLE CONTAINING A SHELL  
CASING WITH THE MARKER AND NAILED  
A SIGN TO THE FENCE POST.


(WOODS)

(NOTE: THE FOUR BEARING  
TREES ARE DOUBLE BLAZED)

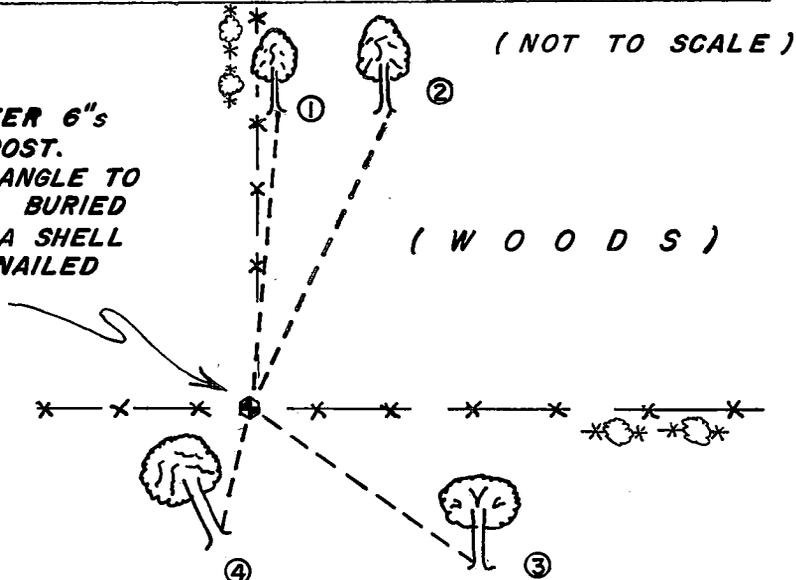

PLAN VIEW DRAWING OF REFERENCE TIES

MAP SHOWING DISTANCE AND DIRECTION TO OTHER PUBLIC LAND SURVEY CORNERS USED FOR REESTABLISHING THE CORNER

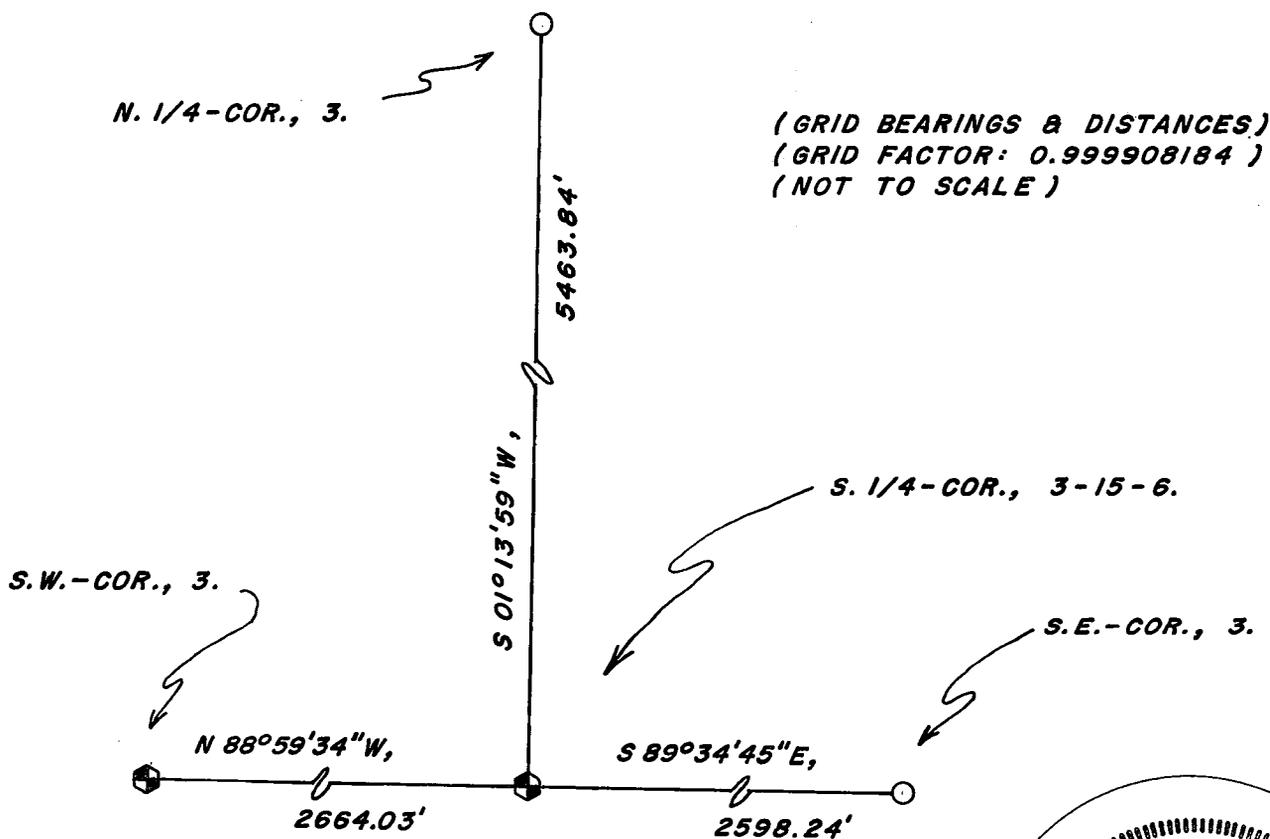

I, WILLIAM C. JUNG, COUNTY SURVEYOR  
HEREBY CERTIFY THAT THE CORNER LOCATION SHOWN ON THIS RECORD  
WAS DETERMINED BY ME OR UNDER MY DIRECTION AND CONTROL AND  
THAT THIS U. S. PUBLIC LAND SURVEY MONUMENT RECORD IS CORRECT  
AND COMPLETE TO THE BEST OF MY KNOWLEDGE AND BELIEF.

William C. Jung  
Signature

1/15/03  
Date



Seal