


21506032000

U. S. PUBLIC LAND SURVEY MONUMENT RECORD

SECTION 3 T 15 N, R 6 W, TOWN OF GREENFIELD

LA CROSSE COUNTY

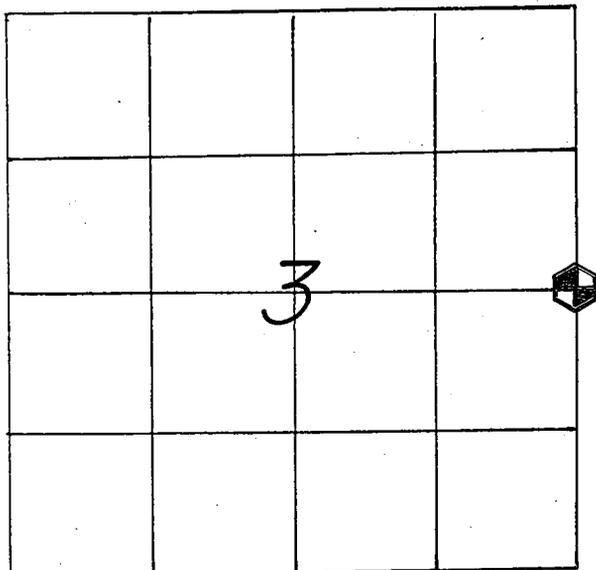

LOCATION OF LANDMARK

CREW: WILLIAM C. JUNG
 PETER F. FOLLANSBEE
 DATE: 7/02/2002

WISCONSIN COORDINATE SYSTEM	
North	659,595.935
East	1,685,767.606
Theta Angle	
Horiz. Order	
Vert. Order	
DATUM	1983('91)
TYPE OF LANDMARK	
BRASS CAP LUNDE MARKER.	
BEARINGS ARE REFERENCED TO	
GRID NORTH AS PER SECTION DATA.	

Describe any record evidence, monument evidence, testimonial evidence or any other material evidence you considered and whether the monument was found or restored through acceptance of an obliterated evidence location.


I set this corner "as per law" by single proportionate measurement and monumented the corner with a brass capped Lunde marker. All evidence of this corner was gone. This would fit Steve Solberg's 1991 calculated position.

Describe or show any material discrepancy between the location of the restored corner and that of the corner previously restored or reestablished.

NONE KNOWN.


RECORD OF DURABLE WITNESS MONUMENTS
MAGNETIC

NO	DESCRIPTION	BEARING	DISTANCE
1	SET A NAIL IN S.W.-SIDE OF A 14" ELM	N 67° W	35.70 FT.
2	SET A NAIL IN S.E.-SIDE OF A 6" ELM	N 50° E	4.83 FT.
3	SET A NAIL IN S.W.-SIDE OF A 13" WHITE OAK	S 11° E	53.81 FT.
4	SET A NAIL IN E.-SIDE OF A 6" HICKORY	S 15° W	23.40 FT.

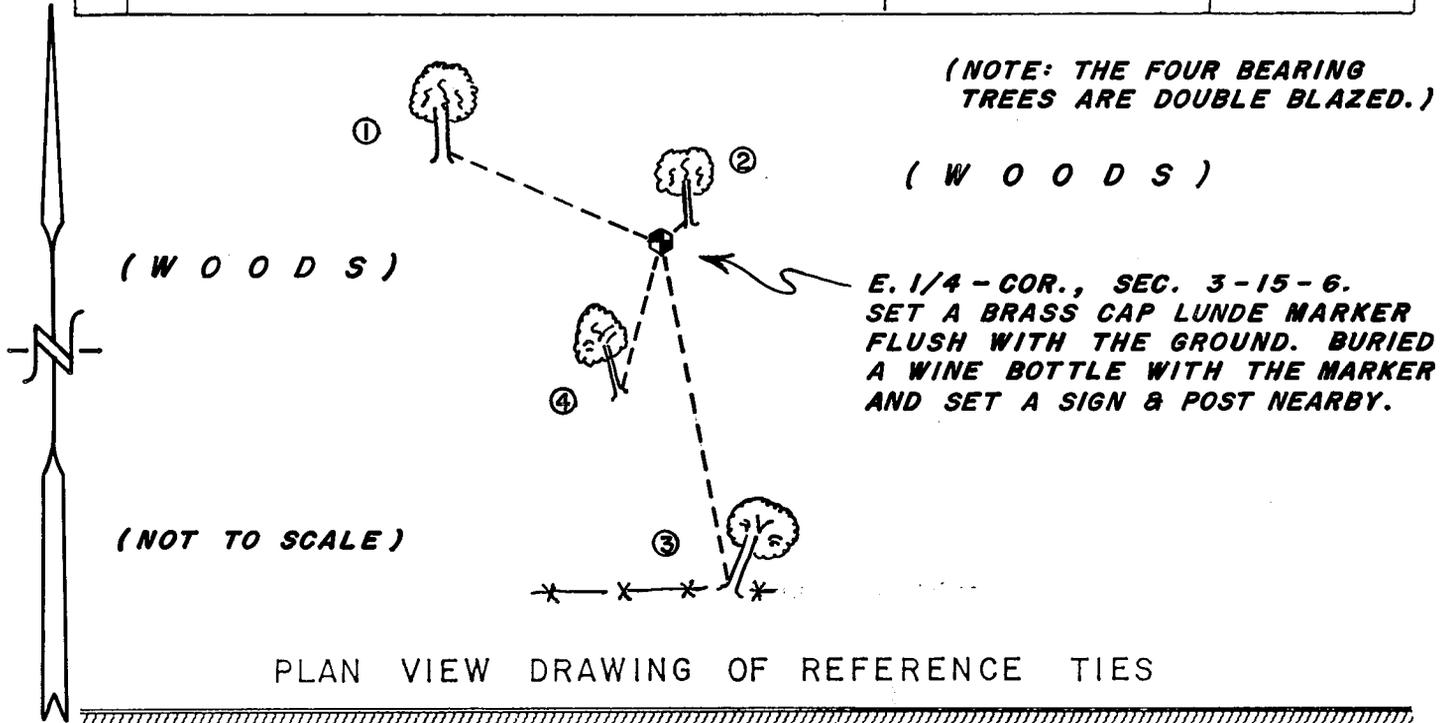

MAP SHOWING DISTANCE AND DIRECTION TO OTHER PUBLIC LAND SURVEY CORNERS USED FOR REESTABLISHING THE CORNER

(GRID BEARINGS & DISTANCES)
(GRID FACTOR: 0.999908184)
(NOT TO SCALE)

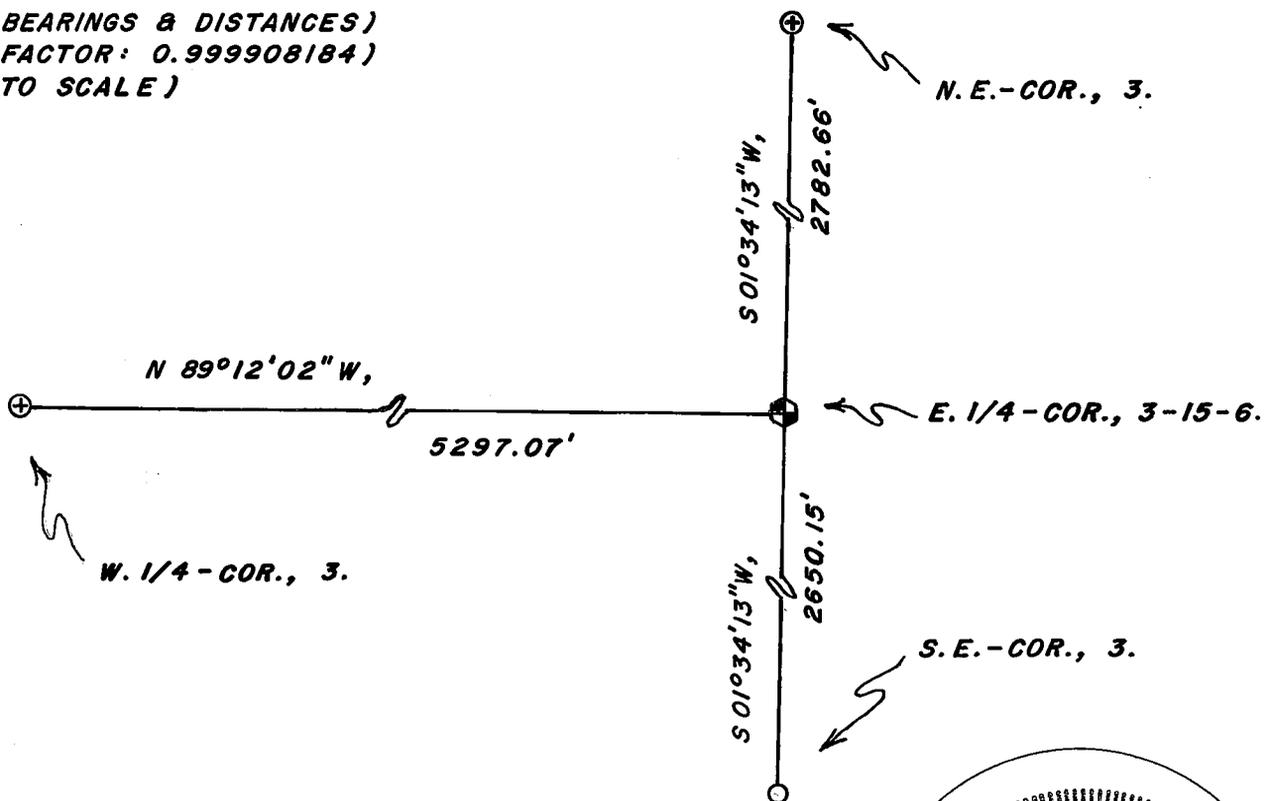

I, WILLIAM G. JUNG, COUNTY SURVEYOR
HEREBY CERTIFY THAT THE CORNER LOCATION SHOWN ON THIS RECORD
WAS DETERMINED BY ME OR UNDER MY DIRECTION AND CONTROL AND
THAT THIS U. S. PUBLIC LAND SURVEY MONUMENT RECORD IS CORRECT
AND COMPLETE TO THE BEST OF MY KNOWLEDGE AND BELIEF.

William G. Jung
Signature

1/15/03
Date

