


U. S. PUBLIC LAND SURVEY MONUMENT RECORD

SECTION 9 T 15 N, R 6 W, TOWN OF GREENFIELD

LA CROSSE COUNTY

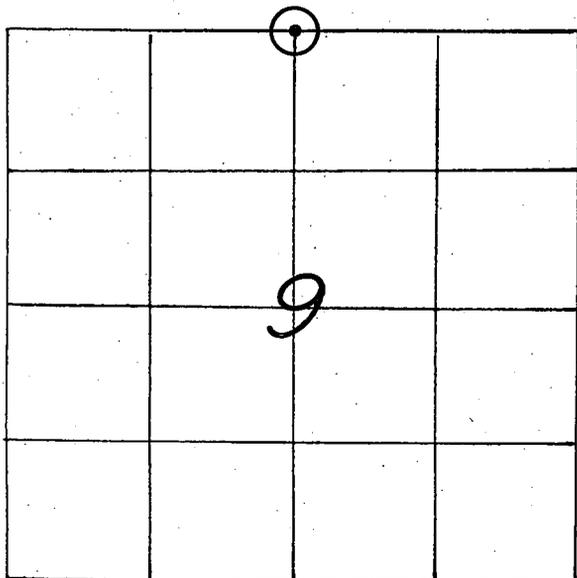

WISCONSIN COORDINATE SYSTEM
North
East
Theta Angle
Horiz. Order
Vert. Order
TYPE OF LANDMARK
<i>3/4" IRON BAR WITH A RED PLASTIC CAP.</i>
BEARINGS ARE REFERENCED TO

LOCATION OF LANDMARK

CREW: *WILLIAM C. JUNG*  
*PETER F. FOLLANSBEE*  
 DATE: *11/02/2004*

Describe any record evidence, monument evidence, testimonial evidence or any other material evidence you considered and whether the monument was found or restored through acceptance of an obliterated evidence location.

In 1991 Dick Walter worked on a resurvey of Section 9. He concluded that the N1/4 corner of Section 9 should be set at the single proportionate position. I agreed with that conclusion at that time. Last year K. Don Pederson set an iron bar at Walter's computed location. The corner was to be 2648.36feet from either section corner. We found this iron bar and tied it off.

Describe or show any material discrepancy between the location of the restored corner and that of the corner previously restored or reestablished.

**NONE KNOWN.**


RECORD OF DURABLE WITNESS MONUMENTS

MAGNETIC

NO	DESCRIPTION	BEARING	DISTANCE
1	SET A NAIL IN S.-SIDE OF A 12-1/2" OAK	WEST ±	11.60 FT.
2	SET A NAIL IN S.E.-SIDE OF AN 11" BURR OAK	N 22° E	14.23 FT.
3	SET A NAIL IN S.W.-SIDE OF A 17" BURR OAK	S 73° E	29.77 FT.
4	SET A NAIL IN N.E.-SIDE OF A 28" BURR OAK	S 45° E	22.82 FT.

(NOTE: THE FOUR BEARING TREES ARE DOUBLE BLAZED.)

(NOT TO SCALE)

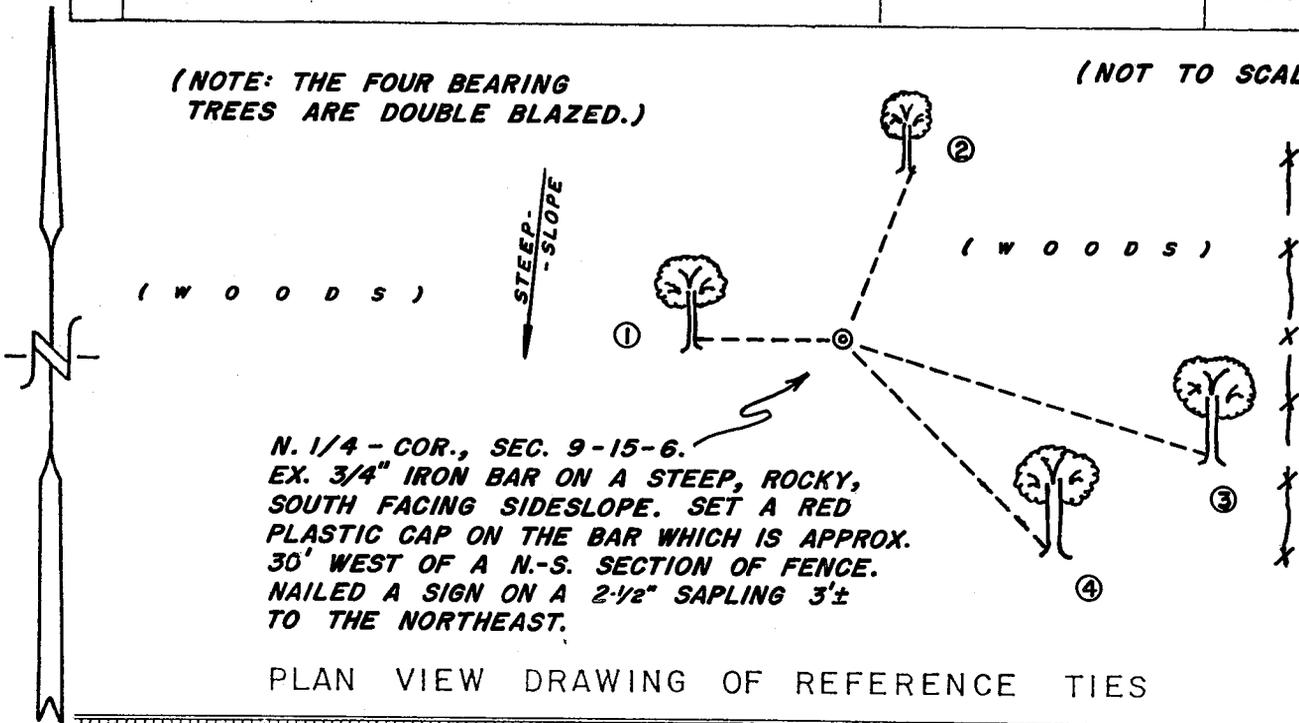

N. 1/4 - COR., SEC. 9-15-6.  
 EX. 3/4" IRON BAR ON A STEEP, ROCKY,  
 SOUTH FACING SIDESLOPE. SET A RED  
 PLASTIC CAP ON THE BAR WHICH IS APPROX.  
 30' WEST OF A N.-S. SECTION OF FENCE.  
 NAILED A SIGN ON A 2-1/2" SAPLING 3±  
 TO THE NORTHEAST.

PLAN VIEW DRAWING OF REFERENCE TIES

MAP SHOWING DISTANCE AND DIRECTION TO OTHER PUBLIC LAND SURVEY CORNERS USED FOR REESTABLISHING THE CORNER

I made no further section measurements at this time. The position and location of this corner was confirmed by Walter's and Pederson's field work.

I, WILLIAM C. JUNG, COUNTY SURVEYOR  
 HEREBY CERTIFY THAT THE CORNER LOCATION SHOWN ON THIS RECORD  
 WAS DETERMINED BY ME OR UNDER MY DIRECTION AND CONTROL AND  
 THAT THIS U. S. PUBLIC LAND SURVEY MONUMENT RECORD IS CORRECT  
 AND COMPLETE TO THE BEST OF MY KNOWLEDGE AND BELIEF.

William C. Jung 3/8/05  
 Signature Date



Seal