


21506042000

## U. S. PUBLIC LAND SURVEY MONUMENT RECORD

SECTION 3 T 15 N, R 6 W, TOWN OF GREENFIELD

LA CROSSE COUNTY

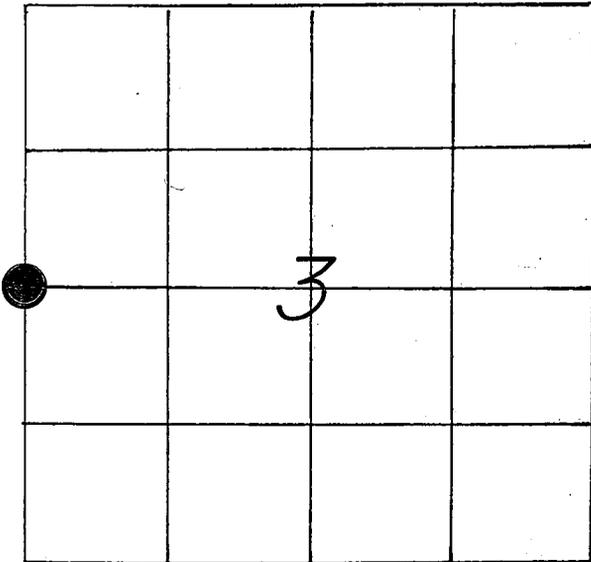

LOCATION OF LANDMARK

CREW: **WILLIAM C. JUNG**  
**PETER F. FOLLANSBEE**  
 DATE: **7/03/2002**

WISCONSIN COORDINATE SYSTEM	
North	659,660.586
East	1,680,470.935
Theta Angle	
Horiz. Order	
Vert. Order	
DATUM:	1983('91)
TYPE OF LANDMARK	
3/4" x 30" IRON BAR WITH ALUMINUM CAP.	
BEARINGS ARE REFERENCED TO	
GRID NORTH AS PER SECTION DATA.	

Describe any record evidence, monument evidence, testimonial evidence or any other material evidence you considered and whether the monument was found or restored through acceptance of an obliterated evidence location.

I found a nail at the occupied corner. It is of unknown origin. Two feet to the Northeast I found a rock lying on the ground. Could it be an unrecorded stone that had fallen over with time? Rodney Loging, a longtime resident, said that the occupation here had never changed. The occupation is obviously very old.

Therefore, after surveying out Section 3 and evaluating all the evidence, I accepted this location as the best available evidence of the original government corner position & Describe or show any material discrepancy between the location of the restored set a bar & corner and that of the corner previously restored or reestablished. cap.

**NONE KNOWN.**

(I do not know what Steve Solberg did at this corner in 1991. To my knowledge he did not set a monument.)

