


U. S. PUBLIC LAND SURVEY MONUMENT RECORD

SECTION 9 T 15 N, R 6 W, TOWN OF Greenfield

LA CROSSE COUNTY

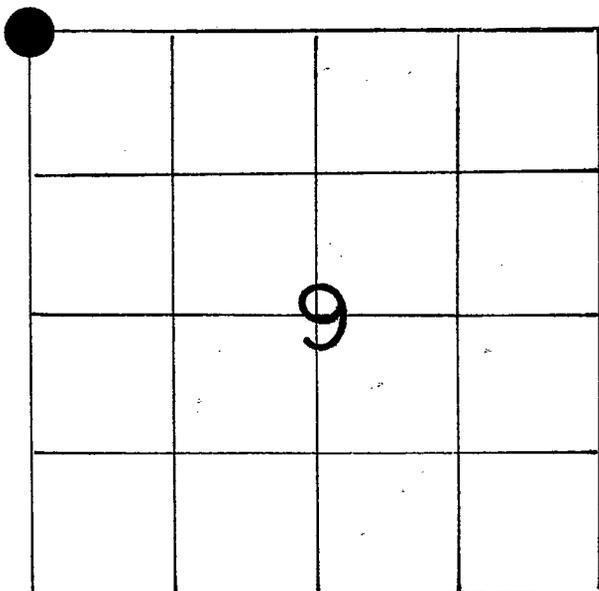

LOCATION OF LANDMARK

Crew: WILLIAM C. JUNG
 PETER F. FOLLANSBEE

Date: 11/19/1991

Describe any record evidence, monument evidence, testimonial evidence or any other material evidence you considered and whether the monument was found or restored through acceptance of an obliterated evidence location.

As Dick Walter did, I accepted a nail at the old occupied corner as the best available evidence of the original government corner position. I replaced the nail with a brass capped Lunde marker, up 8", in a mound of rocks. I set a sign and post to the North and buried a brandy bottle on the NW side of the marker.

Describe or show any material discrepancy between the location of the restored corner and that of the corner previously restored or reestablished.


None known

WISCONSIN COORDINATE SYSTEM
North
East
Theta Angle
Horiz. Order
Vert. Order
TYPE OF LANDMARK
Set brass cap Lunde marker
BEARINGS ARE REFERENCED TO
ASSUMED NORTH

RECORD OF DURABLE WITNESS MONUMENTS

NO	DESCRIPTION	MAGNETIC	
		BEARING	DISTANCE
1	Set P.K. Nail in S.-side 10" Oak	N 90° W	14.36 Ft.
2	Set P.K. Nail in W.-side 14" Oak	N 28° E	20.27 Ft.
3	Set P.K. Nail in S.-side 22" Oak	N 87° E	24.85 Ft.
4	Set P.K. Nail in N.E.-side 12" Oak	S 44° E	23.16 Ft.

NW-COR., SEC. 9-15-6.
 SET BRASS CAP LUNDE MARKER
 UP 8 INCHES TO REPLACE AN EXISTING
 NAIL AT A DOWNED FENCE INTERSECTION.
 MOUNDED UP WITH ROCKS; SET SIGN &
 POST TO NORTH AND BURIED A BRANDY BOTTLE
 ON THE NW-SIDE OF THE MARKER.

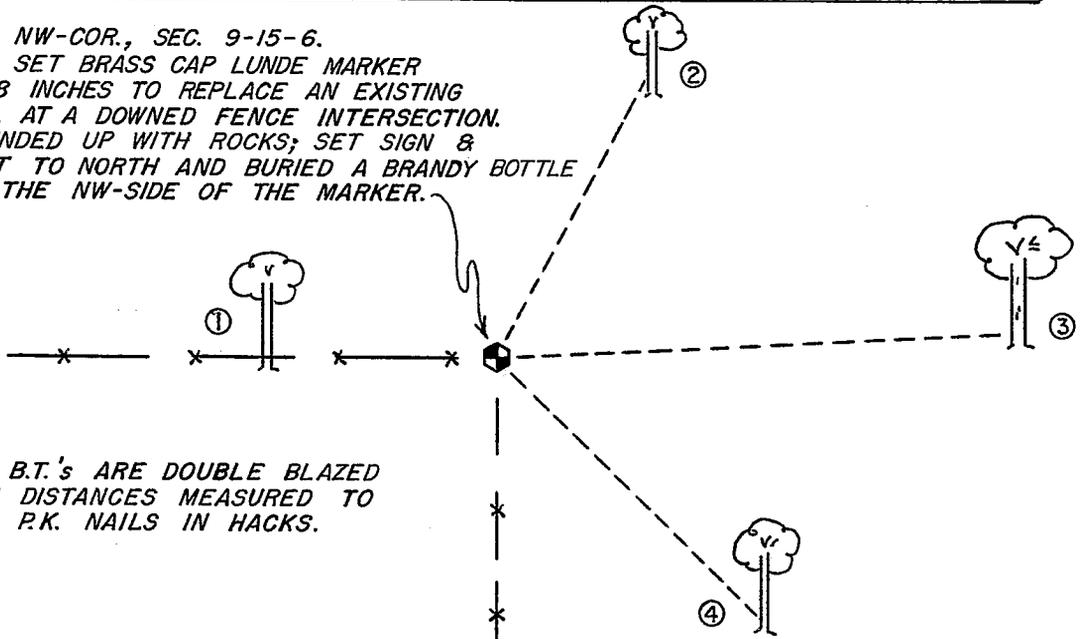


NOTE: ALL B.T.'s ARE DOUBLE BLAZED
 WITH DISTANCES MEASURED TO
 SET P.K. NAILS IN HACKS.

(not to scale)

PLAN VIEW DRAWING OF REFERENCE TIES

MAP SHOWING DISTANCE AND DIRECTION TO OTHER PUBLIC LAND SURVEY CORNERS USED FOR REESTABLISHING THE CORNER


(not to scale)

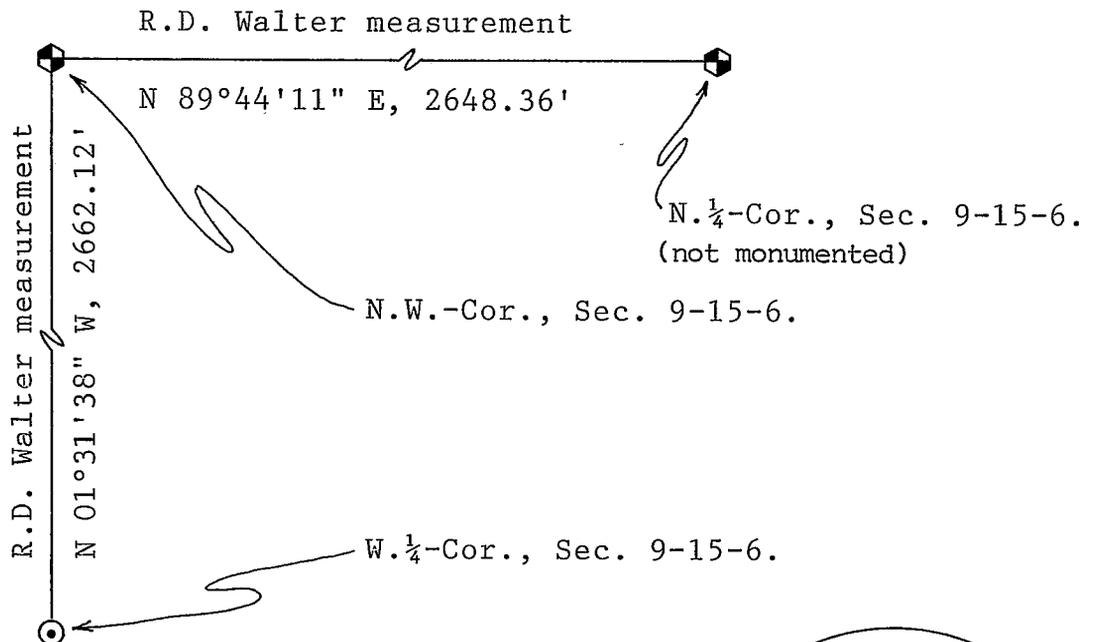

I, William C. Jung, Deputy County Surveyor
 HEREBY CERTIFY THAT THE CORNER LOCATION SHOWN ON THIS RECORD
 WAS DETERMINED BY ME OR UNDER MY DIRECTION AND CONTROL AND
 THAT THIS U. S. PUBLIC LAND SURVEY MONUMENT RECORD IS CORRECT
 AND COMPLETE TO THE BEST OF MY KNOWLEDGE AND BELIEF.

William C. Jung
 Signature

December 2, 1991
 Date

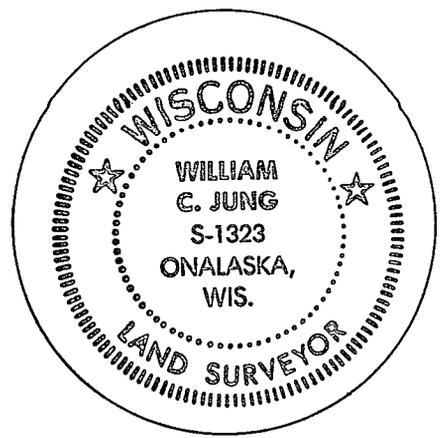

Seal

10