


U. S. PUBLIC LAND SURVEY MONUMENT RECORD

SECTION 5 T 15 N, R 6 W, TOWN OF GREENFIELD

LA CROSSE COUNTY

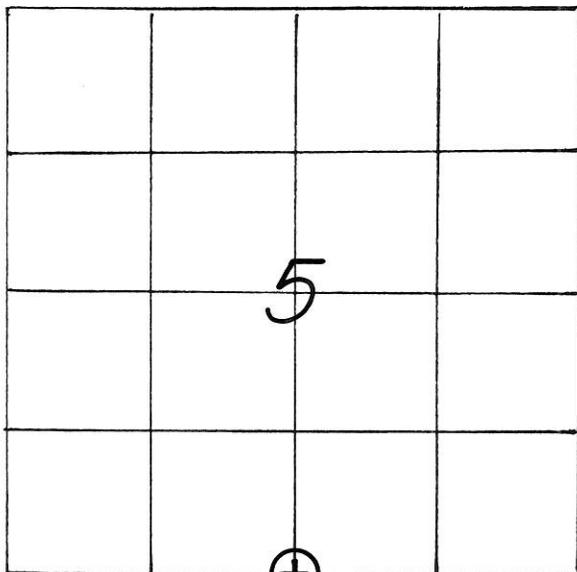

LOCATION OF LANDMARK

CREW: **BRYAN H. MEYER**
PETER F. FOLLANSBEE
 DATE: **10/07/2009**

WISCONSIN COORDINATE SYSTEM	
North	657,200.479
East	1,672,491.933
Theta Angle	
Horiz. Order	
Vert. Order	
DATUM:	NAD 1983('91)
TYPE OF LANDMARK	
3/4" IRON BAR WITH AN ALUMINUM CAP.	
BEARINGS ARE REFERENCED TO	
GRID NORTH AS PER SECTION DATA.	


Describe any record evidence, monument evidence, testimonial evidence or any other material evidence you considered and whether the monument was found or restored through acceptance of an obliterated evidence location.

Describe or show any material discrepancy between the location of the restored corner and that of the corner previously restored or reestablished.

RECORD OF DURABLE WITNESS MONUMENTS


MAGNETIC

NO	DESCRIPTION	BEARING	DISTANCE
1	SET A NAIL IN N.W.-SIDE OF A 13" WHITE OAK	S 61° W	40.83 FT.
2	EX. 5/8" IRON BAR AT A FENCE INTERSECTION	WEST ±	13.10 FT.
3	EX. 1-1/4" O.D. IRON PIPE UNDER A FENCE	N.'WESTERLY ±	26.93 FT.
4	SET A NEW NAIL IN A 13" DOUBLE BLAZED W. OAK	N 16° W	22.66 FT.

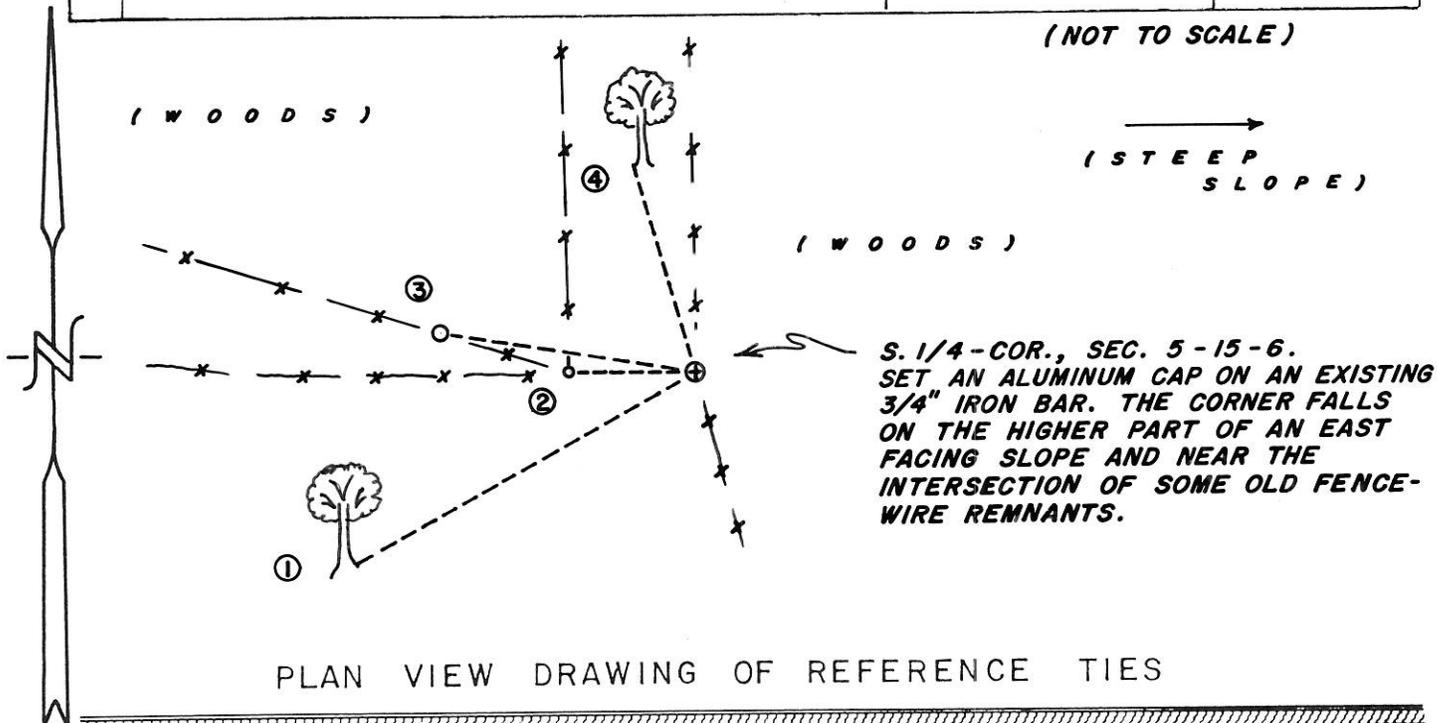

MAP SHOWING DISTANCE AND DIRECTION TO OTHER PUBLIC LAND SURVEY CORNERS USED FOR REESTABLISHING THE CORNER

(GRID BEARINGS AND DISTANCES)
(GRID FACTOR: 0.99994)
(NOT TO SCALE)

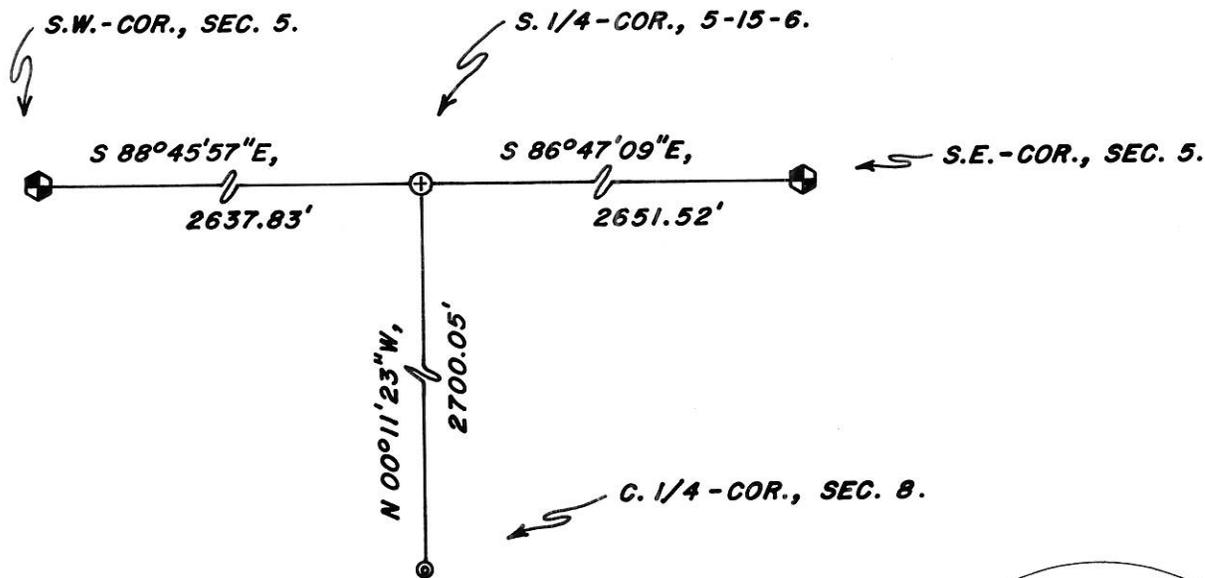

I, BRYAN H. MEYER, COUNTY SURVEYOR
HEREBY CERTIFY THAT THE CORNER LOCATION SHOWN ON THIS RECORD WAS DETERMINED BY ME OR UNDER MY DIRECTION AND CONTROL AND THAT THIS U. S. PUBLIC LAND SURVEY MONUMENT RECORD IS CORRECT AND COMPLETE TO THE BEST OF MY KNOWLEDGE AND BELIEF.

Bryan H. Meyer
Signature


10/16/2009
Date



Seal

U. S. PUBLIC LAND SURVEY MONUMENT RECORD

SECTION 5 T 15 N, R 6 W, TOWN OF GREENFIELD
LA CROSSE COUNTY

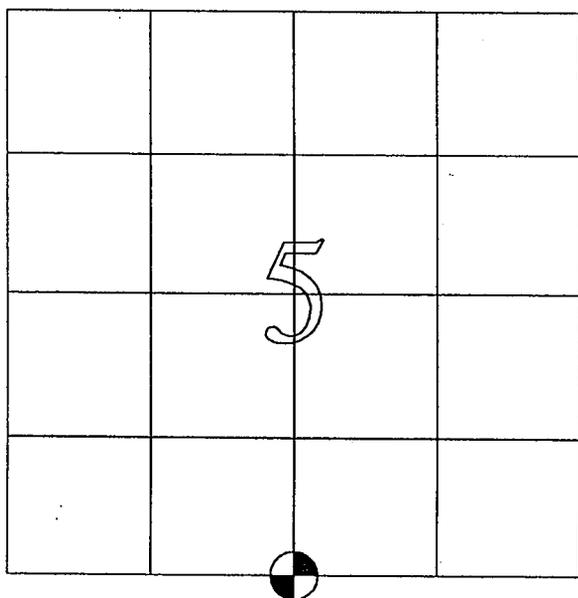

LOCATION OF LANDMARK

WISCONSIN COORDINATE SYSTEM

North

East

Theta Angle

Horiz. Order

Vert. Order

TYPE OF LANDMARK

SET 3/4" IB

BEARINGS ARE REFERENCED TO

The north line of Section 7,
 T15N-R6W. (R.A. N 89°05'53" E)

CREW: SD

JF

DATE: 2-8-99

Describe any record evidence, monument evidence, testimonial evidence, or any other material evidence you considered and whether the monument was found or restored through acceptance of an obliterated evidence location.

I found remnants of wire leading to the north and south of the east-west fence. I had a phone conversation with William Varnum who placed the fence in its current location simply because of convenience, not replacing any old fence. An even split would push this corner south approximately 40 feet. No evidence exists to warrant placing the corner here.

Describe or show any material discrepancy between the location of the restored corner and that of the corner previously restored or reestablished.

I found a 5/8" iron bar at the fence corner. This was a temporary corner set by the County Surveyor.

