


U. S. PUBLIC LAND SURVEY MONUMENT RECORD

SECTION 5 T 15 N, R 6 W, TOWN OF GREENFIELD
LA CROSSE COUNTY

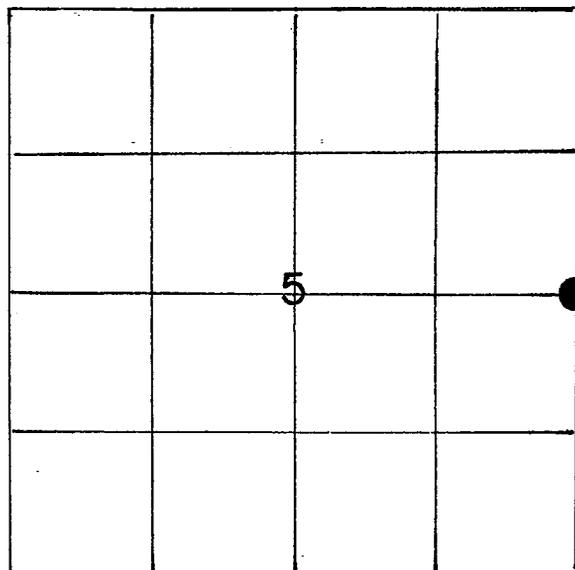

LOCATION OF LANDMARK

Crew: Bill Jung
Gary Watts
Perry Dahl

11/20/85

Crew: Bill Jung
Peter Follansbee
5/21/07

Describe any record evidence, monument evidence, testimonial evidence or any other material evidence you considered and whether the monument was found or restored through acceptance of an obliterated evidence location.

After surveying out part of Section 5, Gary Watts found that the old fence corner fit his computed corner very well. Therefore we accepted the old occupied corner as the best available evidence of the original government corner. We searched for other evidence but found none. It was cold and windy with snow on the ground.

5/21/07 - Found the Berntsen with all four trees standing. This monument has been used as the corner in a number of surveys over the years.


Describe or show any material discrepancy between the location of the restored corner and that of the corner previously restored or reestablished.

None known.

WISCONSIN COORDINATE SYSTEM	
North	659,699.353
East	1,675,192.097
Theta Angle	
Horiz. Order	
Vert. Order	
DATUM:	1983('91)
TYPE OF LANDMARK	
Berntsen Monument	
BEARINGS ARE REFERENCED TO	

RECORD OF DURABLE WITNESS MONUMENTS

NO	DESCRIPTION	BEARING	DISTANCE
1	9" white oak	N50°W N41°W	43.22
2	8" cherry	N20°W N15°W	8.21
3	6" hickory	N22°E N24°E	27.58
4	9" cherry	N60°E N50°E	28.79

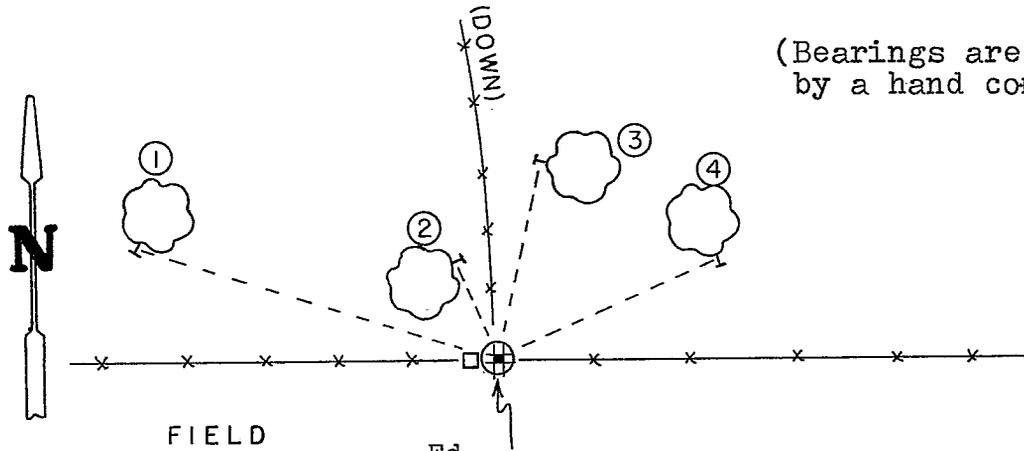

(Bearings are magnetic and are by a hand compass.)

Fd. ~~Set~~ a Berntsen monument on the East side of a large tie post.
Put a sign on the East side of the tie post.

(All trees are double blazed with each distance to a P.K. in a hack.)

PLAN VIEW DRAWING OF REFERENCE TIES

MAP SHOWING DISTANCE AND DIRECTION TO OTHER PUBLIC LAND SURVEY CORNERS USED FOR REESTABLISHING THE CORNER

~~None measured by me.~~


Surveys of record show section measurements to this corner. The SPC's that we assigned to this corner and the NE of Section 5 after running GPS missions confirmed Watts' distance between these two corners.

I, William C. Jung, Deputy County Surveyor,
HEREBY CERTIFY THAT THE CORNER LOCATION SHOWN ON THIS RECORD
WAS DETERMINED BY ME OR UNDER MY DIRECTION AND CONTROL AND
THAT THIS U. S. PUBLIC LAND SURVEY MONUMENT RECORD IS CORRECT
AND COMPLETE TO THE BEST OF MY KNOWLEDGE AND BELIEF.

William C. Jung
Signature

December 6, 1985
Date

Revised: July 12, 2007 *wcj*

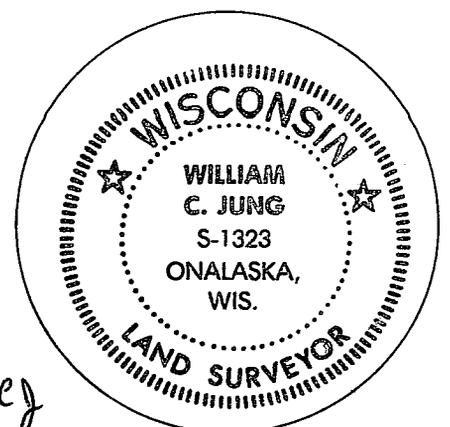

Seal