


U. S. PUBLIC LAND SURVEY MONUMENT RECORD

SECTION 6 T 15 N, R 6 W, TOWN OF SHELBY

LA CROSSE COUNTY

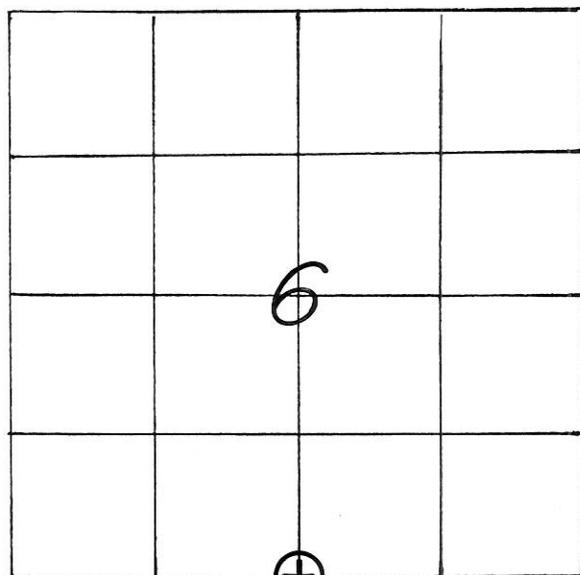

LOCATION OF LANDMARK

CREW: **BRYAN H. MEYER**
PETER F. FOLLANSBEE
 DATE: **10/05/2009**

WISCONSIN COORDINATE SYSTEM

North **657,254.811**East **1,667,250.633**

Theta Angle

Horiz. Order

Vert. Order

DATUM: NAD 1983('91)

TYPE OF LANDMARK

3/4" x 30" IRON BAR WITH AN ALUMINUM CAP.

BEARINGS ARE REFERENCED TO

GRID NORTH AS PER SECTION DATA.

Describe any record evidence, monument evidence, testimonial evidence or any other material evidence you considered and whether the monument was found or restored through acceptance of an obliterated evidence location.

Describe or show any material discrepancy between the location of the restored corner and that of the corner previously restored or reestablished.


RECORD OF DURABLE WITNESS MONUMENTS

MAGNETIC

NO	DESCRIPTION	BEARING	DISTANCE
1	SET A NEW NAIL IN S.W.-SIDE OF A 28" OAK	N 52° W	SLOPE = 61.82'
2	SET A NEW NAIL IN S.W.-SIDE OF A 17" BURR OAK	N 32° W	SLOPE = 54.66'
3	SET A NEW NAIL IN S.W.-SIDE OF A 24" ASH	N 14° W	SLOPE = 54.42'
4	SET A NEW NAIL IN S.E.-SIDE OF A 23" OAK	N 10° E	SLOPE = 69.42'

(NOT TO SCALE)


(NOTE: THE BEARING TREES ARE UNBLAZED WITH THE NAIL SET IN A HACK NEAR THE BASE.)

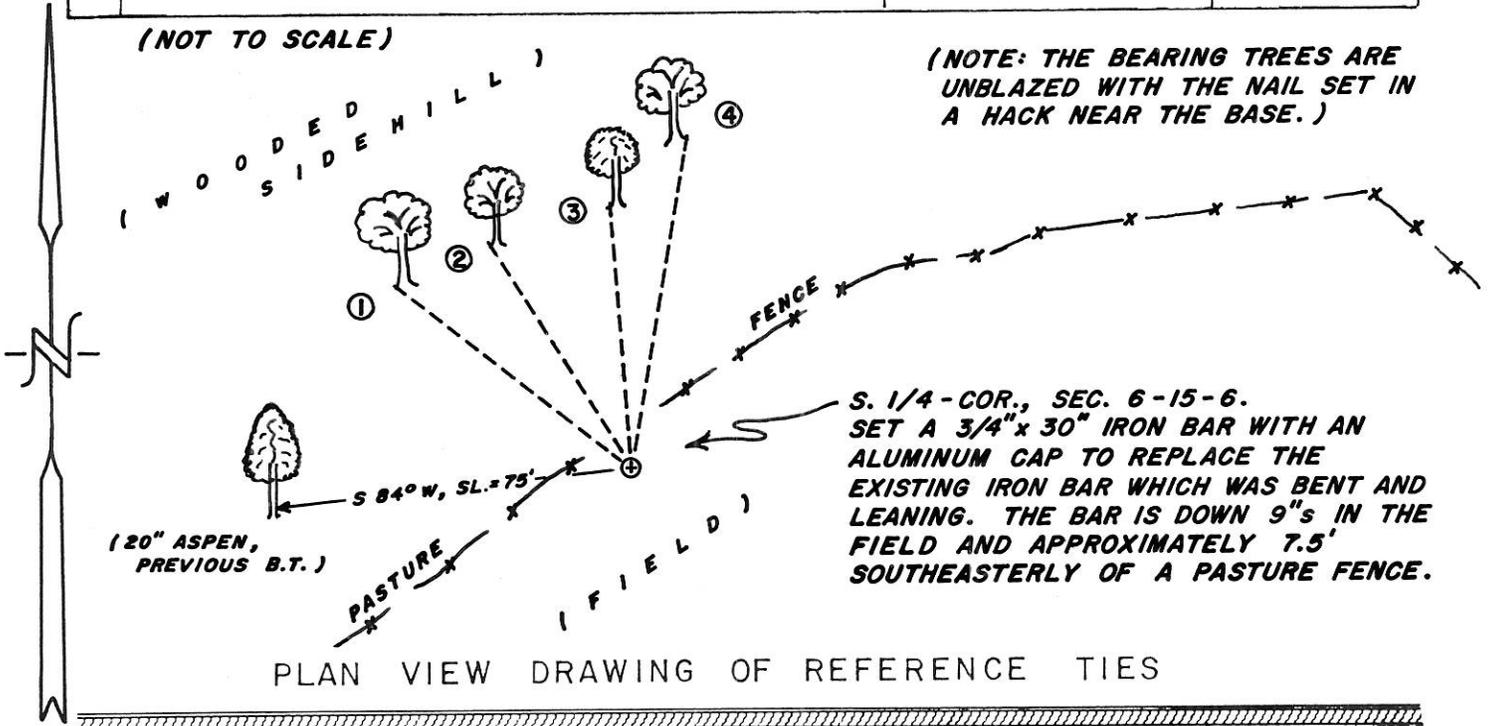

PLAN VIEW DRAWING OF REFERENCE TIES

MAP SHOWING DISTANCE AND DIRECTION TO OTHER PUBLIC LAND SURVEY CORNERS USED FOR REESTABLISHING THE CORNER

(GRID BEARINGS AND DISTANCES)
(GRID FACTOR: 0.99994)
(NOT TO SCALE)

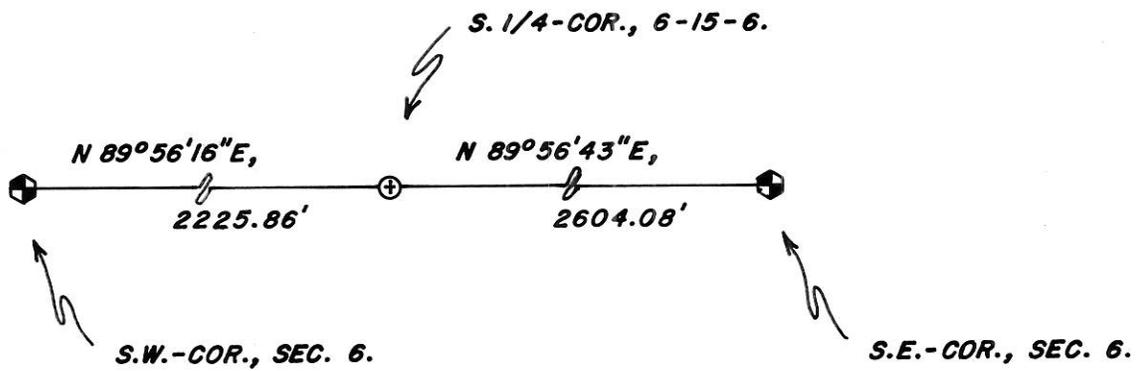

I, BRYAN H. MEYER, COUNTY SURVEYOR
HEREBY CERTIFY THAT THE CORNER LOCATION SHOWN ON THIS RECORD WAS DETERMINED BY ME OR UNDER MY DIRECTION AND CONTROL AND THAT THIS U. S. PUBLIC LAND SURVEY MONUMENT RECORD IS CORRECT AND COMPLETE TO THE BEST OF MY KNOWLEDGE AND BELIEF.

Bryan H. Meyer Signature 10/15/2009 Date




Seal

21506060020

U. S. PUBLIC LAND SURVEY MONUMENT RECORD

SECTION 6 T 15 N, R 6 W, TOWN OF SHELBY
 LA CROSSE COUNTY

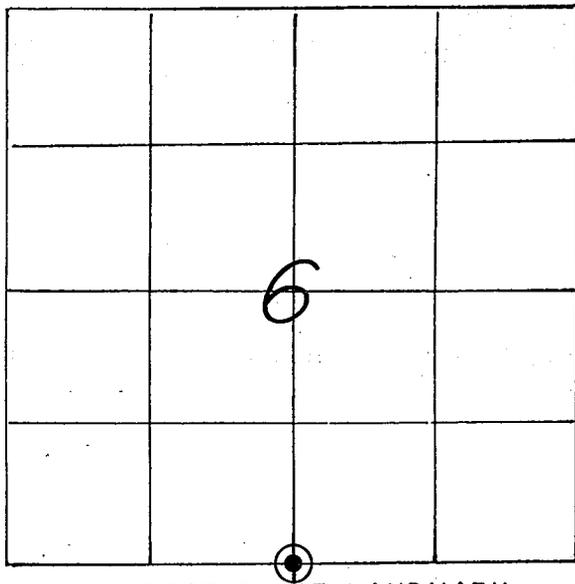

LOCATION OF LANDMARK

CREW: *WILLIAM C. JUNG*
PETER F. FOLLANSBEE
 DATE: *12/03/1998*

WISCONSIN COORDINATE SYSTEM

North

East

Theta Angle

Horiz. Order

Vert. Order

TYPE OF LANDMARK

IRON BAR WITH AN ALUMINUM CAP.

BEARINGS ARE REFERENCED TO

Describe any record evidence, monument evidence, testimonial evidence or any other material evidence you considered and whether the monument was found or restored through acceptance of an obliterated evidence location.

Paul Fairchild set an iron bar at this corner. We agreed on his computed location. I capped his bar with a Berntsen cap.


Describe or show any material discrepancy between the location of the restored corner and that of the corner previously restored or reestablished.

None known.

RECORD OF DURABLE WITNESS MONUMENTS

MAGNETIC

NO	DESCRIPTION	BEARING	DISTANCE
1	SET A NAIL IN THE N.E.-SIDE 25" OAK	N 50° W	SL. = 61.27'
2	SET A NAIL IN THE N.E.-SIDE 15" BURR OAK	N 35° W	SL. = 54.62'
3	SET A NAIL IN THE W.-SIDE 19" ASH	N 14° W	SL. = 54.41'
4	SET A NAIL IN THE S.E.-SIDE 20" OAK	N 11° E	SL. = 69.61'

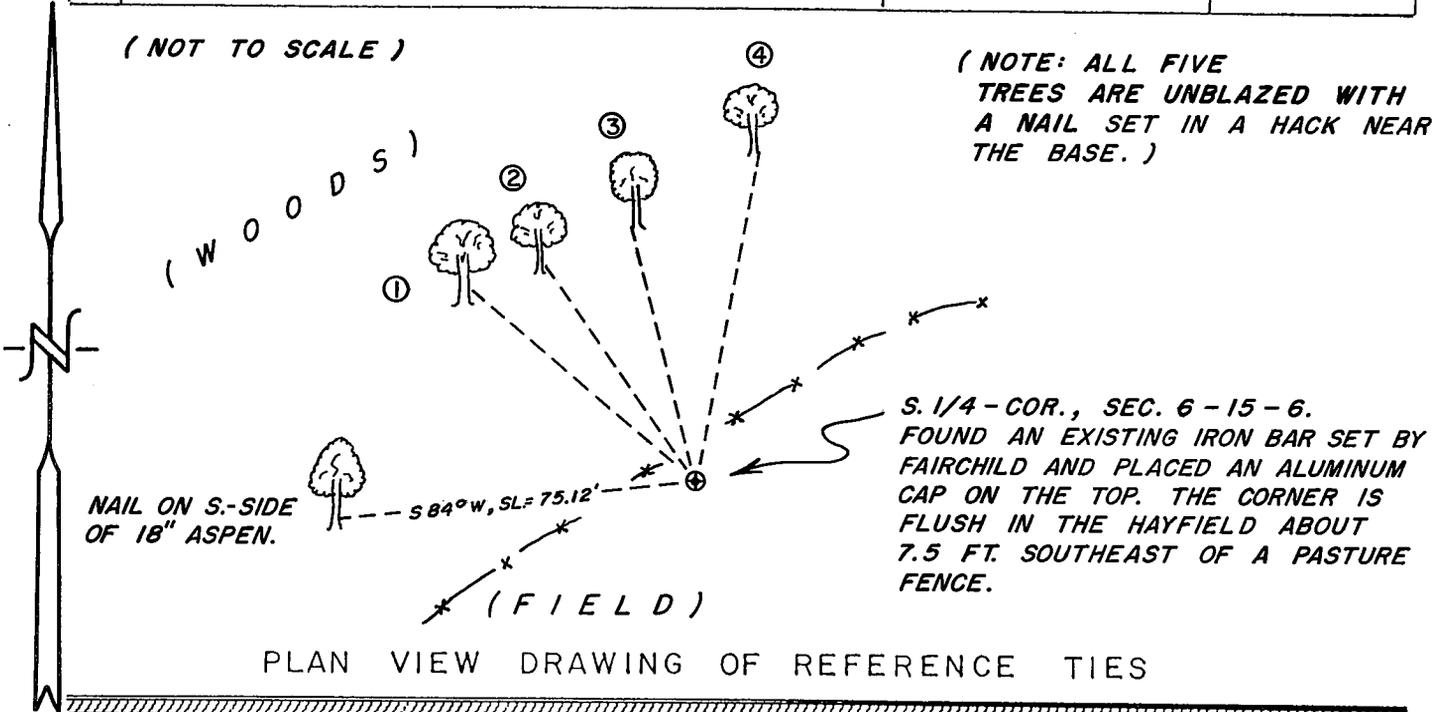


MAP SHOWING DISTANCE AND DIRECTION TO OTHER PUBLIC LAND SURVEY CORNERS USED FOR REESTABLISHING THE CORNER

No section measurements were made by me at this time. The location of this corner was confirmed by Paul Fairchild.

I, WILLIAM C. JUNG, COUNTY SURVEYOR
 HEREBY CERTIFY THAT THE CORNER LOCATION SHOWN ON THIS RECORD WAS DETERMINED BY ME OR UNDER MY DIRECTION AND CONTROL AND THAT THIS U. S. PUBLIC LAND SURVEY MONUMENT RECORD IS CORRECT AND COMPLETE TO THE BEST OF MY KNOWLEDGE AND BELIEF.

William C. Jung 1/12/99
 Signature Date

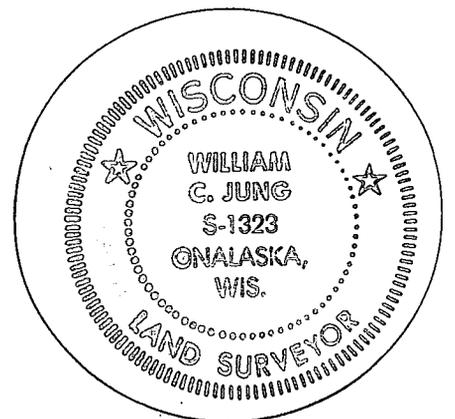

Seal