


21506062000

## U. S. PUBLIC LAND SURVEY MONUMENT RECORD

SECTION 5 T 15 N, R 6 W, TOWN OF GREENFIELD

LA CROSSE COUNTY

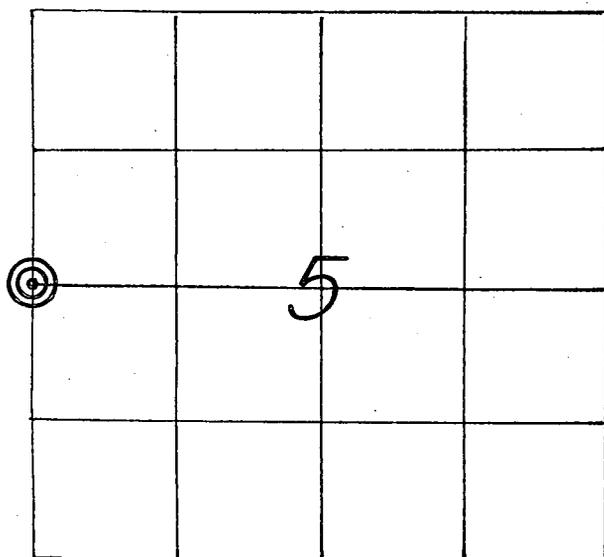

LOCATION OF LANDMARK

CREW: **WILLIAM C. JUNG**  
**PETER F. FOLLANSBEE**  
 DATE: **5/29/2007**

## WISCONSIN COORDINATE SYSTEM

North **659,901.982**East **1,669,960.681**

Theta Angle

Horiz. Order

Vert. Order

**DATUM: 1983('91)**

## TYPE OF LANDMARK

**3/4" x 30" IRON BAR WITH A RED PLASTIC CAP.**

BEARINGS ARE REFERENCED TO

**GRID NORTH AS PER SECTION DATA.**

Describe any record evidence, monument evidence, testimonial evidence or any other material evidence you considered and whether the monument was found or restored through acceptance of an obliterated evidence location.

We found the pipe of record, set an iron bar with cap inside it, and took new ties. The pipe had been used as the corner in numerous surveys. I accepted it by "common report" as the best available evidence of the original government corner.

Describe or show any material discrepancy between the location of the restored corner and that of the corner previously restored or reestablished.


**NONE KNOWN.**

RECORD OF DURABLE WITNESS MONUMENTS

MAGNETIC

NO	DESCRIPTION	BEARING	DISTANCE
1	SET A NAIL IN S.W.-SIDE OF A 13" HICKORY	N 59° W	5.30 FT.
2	SET A NAIL IN N.-SIDE OF AN 11" HICKORY	S 76° E	12.85 FT.
3	SET A NAIL IN N.E.-SIDE OF A 7" HICKORY	S 34° E	14.83 FT.
4	SET A NAIL IN N.W.-SIDE OF A 15" OAK	S 49° W	35.74 FT.


(NOT TO SCALE)

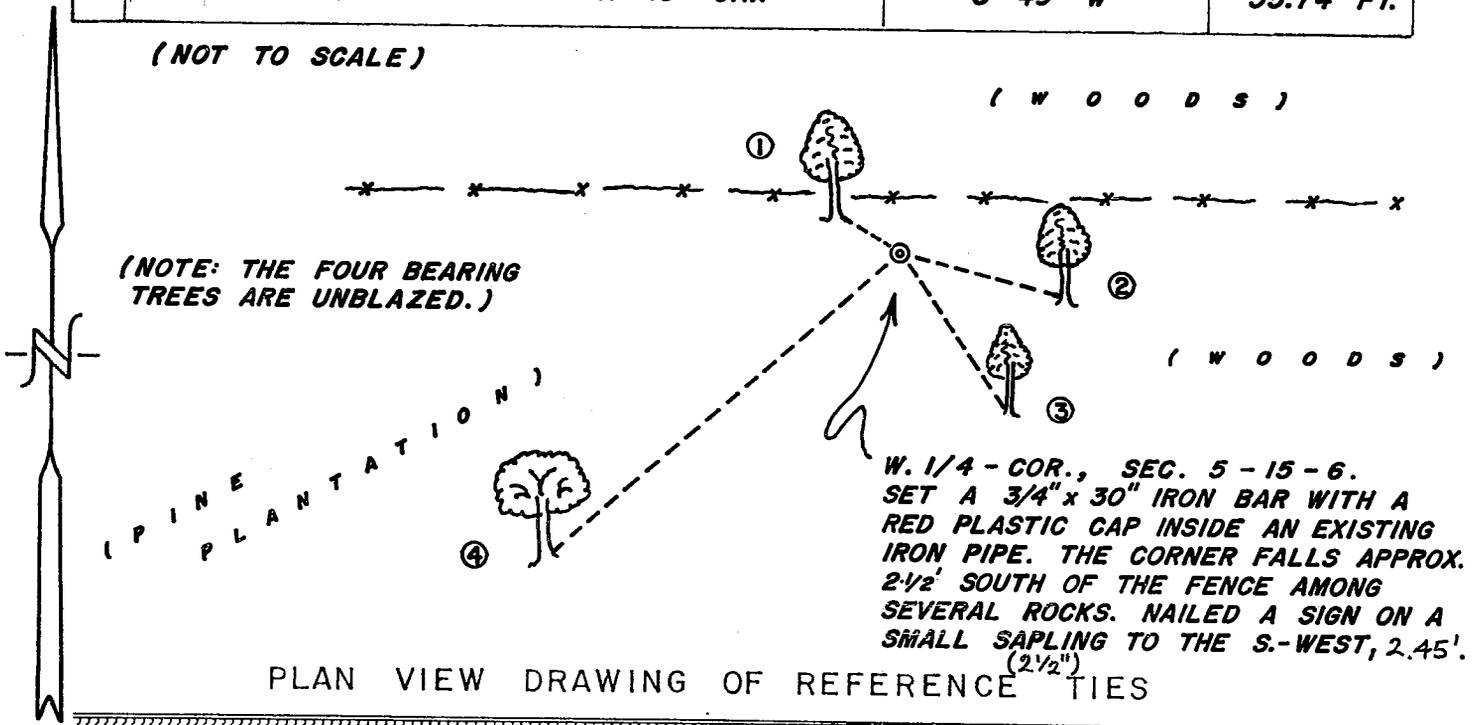

PLAN VIEW DRAWING OF REFERENCE TIES

MAP SHOWING DISTANCE AND DIRECTION TO OTHER PUBLIC LAND SURVEY CORNERS USED FOR REESTABLISHING THE CORNER


(GRID BEARINGS AND DISTANCES)  
(GRID FACTOR: 0.999908)  
(NOT TO SCALE)

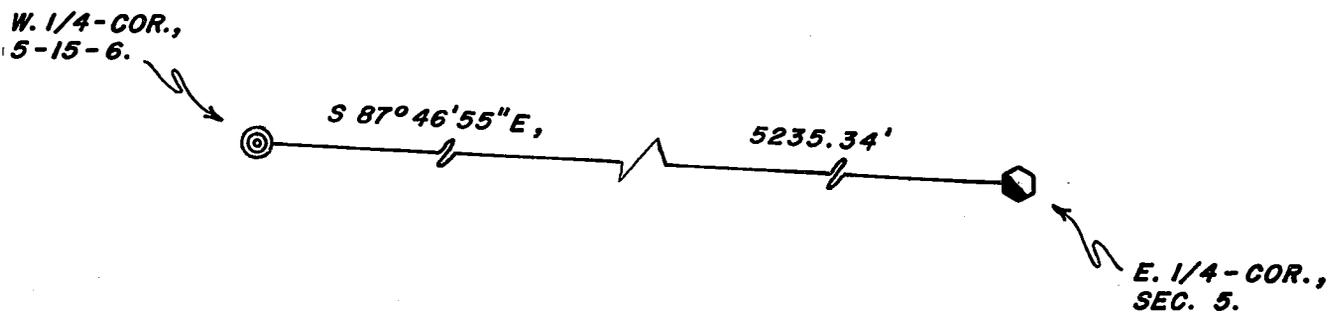

I, WILLIAM C. JUNG, COUNTY SURVEYOR  
HEREBY CERTIFY THAT THE CORNER LOCATION SHOWN ON THIS RECORD  
WAS DETERMINED BY ME OR UNDER MY DIRECTION AND CONTROL AND  
THAT THIS U. S. PUBLIC LAND SURVEY MONUMENT RECORD IS CORRECT  
AND COMPLETE TO THE BEST OF MY KNOWLEDGE AND BELIEF.

William C. Jung  
Signature

7/12/07  
Date

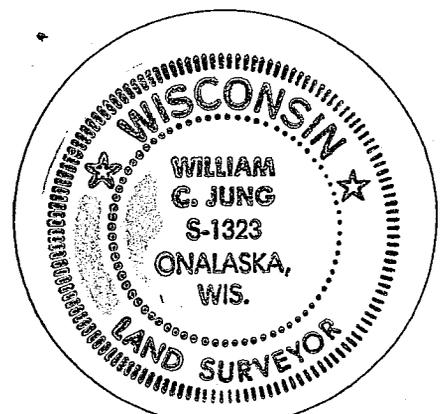


Seal

U. S. PUBLIC LAND SURVEY MONUMENT RECORD

SECTION 5 T 15 N, R 6 W, TOWN OF GREENFIELD

LA CROSSE COUNTY

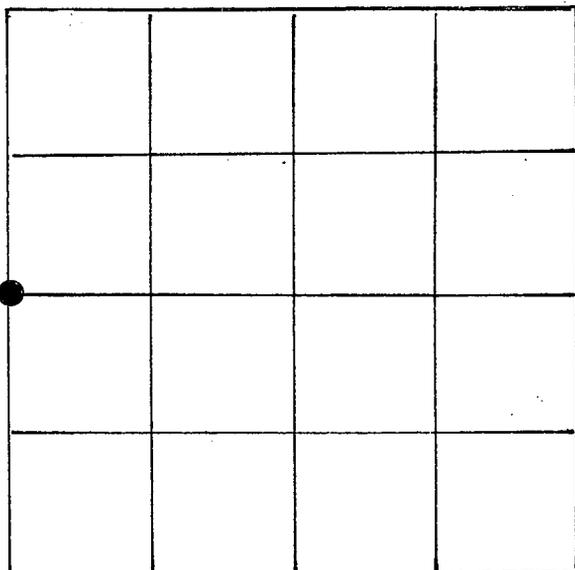

LOCATION OF LANDMARK

WISCONSIN COORDINATE SYSTEM
North
East
Theta Angle
Horiz. Order
Vert. Order
TYPE OF LANDMARK
1" IRON PIPE
BEARINGS ARE REFERENCED TO


Describe any record evidence, monument evidence, testimonial evidence or any other material evidence you considered and whether the monument was found or restored through acceptance of an obliterated evidence location.

1" IRON PIPE FOUND CALLED FOR IN C.S.M. #151 & 220

Describe or show any material discrepancy between the location of the restored corner and that of the corner previously restored or reestablished.

RECORD OF DURABLE WITNESS MONUMENTS

NO	DESCRIPTION	BEARING	DISTANCE
1	PK NAIL SET 5" HICKORY		5.47'
2	PK NAIL SET 30" OAK		33.07'
3	PK NAIL SET 36" OAK		21.33'
4	PK NAIL SET 6" OAK		12.83'

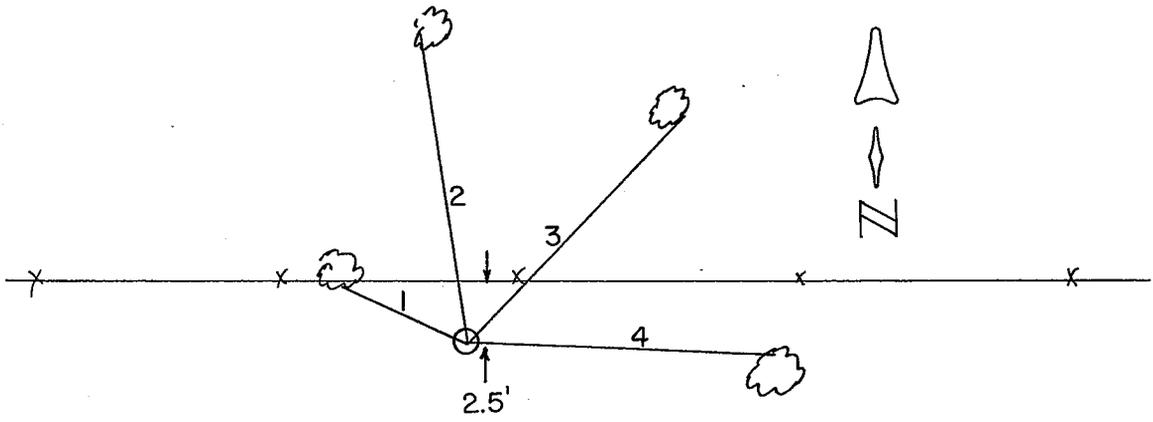

PLAN VIEW DRAWING OF REFERENCE TIES

MAP SHOWING DISTANCE AND DIRECTION TO OTHER PUBLIC LAND SURVEY CORNERS USED FOR REESTABLISHING THE CORNER

I, GARY A. WATTS  
 HEREBY CERTIFY THAT THE CORNER LOCATION SHOWN ON THIS RECORD  
 WAS DETERMINED BY ME OR UNDER MY DIRECTION AND CONTROL AND  
 THAT THIS U. S. PUBLIC LAND SURVEY MONUMENT RECORD IS CORRECT  
 AND COMPLETE TO THE BEST OF MY KNOWLEDGE AND BELIEF.

Gary A. Watts Signature Nov. 18, 1985 Date



Seal