


U. S. PUBLIC LAND SURVEY MONUMENT RECORD

SECTION 8 T 15 N, R 6 W, TOWN OF Greenfield

LA CROSSE COUNTY

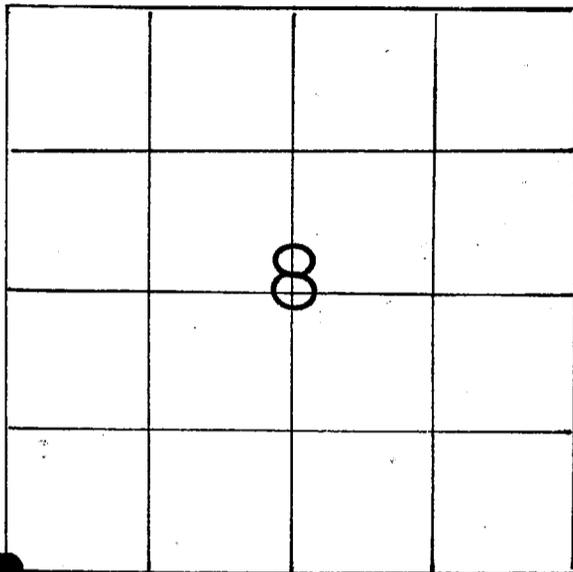

LOCATION OF LANDMARK

Crew: William C. Jung
Peter Follansbee

Date: 10/20/89

Describe any record evidence, monument evidence, testimonial evidence or any other material evidence you considered and whether the monument was found or restored through acceptance of an obliterated evidence location.

While surveying in Section 8, Steve Solberg set an iron pipe at this corner. He found what he believed to be the original bearing trees, one living and one dead, and set the corner from these trees. He then replaced the pipe with a Lunde at a later date. I found the Lunde and tied it off. I agree with his analysis of the trees. The tree to the Northwest was living. The tree to the Southeast was dead, but the old hollowed scar in the rotted white oak stump was visible. The old fences near the corner are somewhat "wild".

Describe or show any material discrepancy between the location of the restored corner and that of the corner previously restored or reestablished.

None known.

WISCONSIN COORDINATE SYSTEM

North

East

Theta Angle

Horiz. Order

Vert. Order


TYPE OF LANDMARK

Brass capped Lunde marker

BEARINGS ARE REFERENCED TO

RECORD OF DURABLE WITNESS MONUMENTS
Magnetic

NO	DESCRIPTION	BEARING	DISTANCE
1	P.K. nail in unblazed 15" white oak	N60°W	12.43
2	P.K. nail in double blazed 27" white oak	N24°W	49.62
3	" " " " " 17" " "	N7°E	15.02
4	" " " " " 14" oak	N52°E	18.51

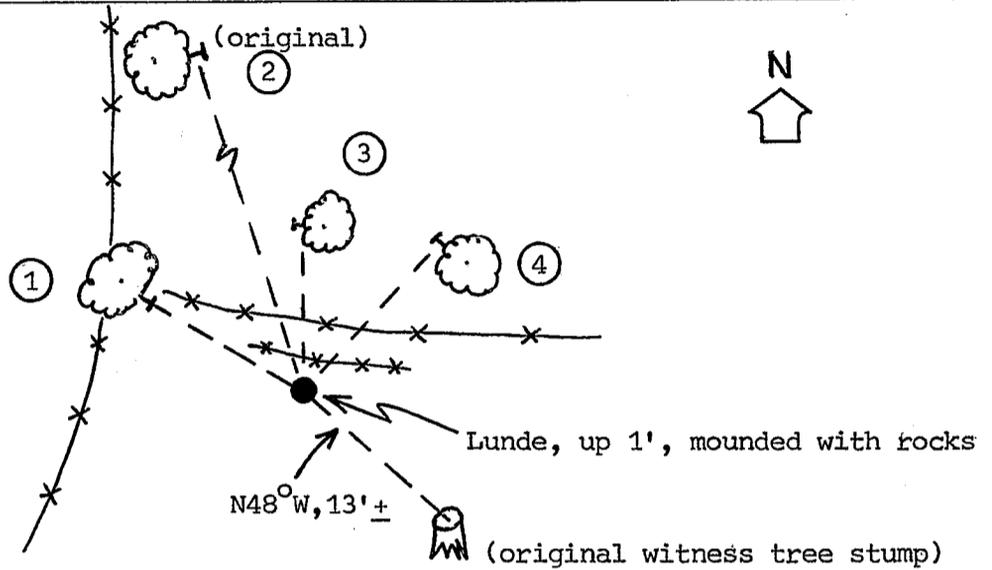

PLAN VIEW DRAWING OF REFERENCE TIES


MAP SHOWING DISTANCE AND DIRECTION TO OTHER PUBLIC LAND SURVEY CORNERS USED FOR REESTABLISHING THE CORNER

(no section measurements made by me at this time)

I, William C. Jung, Deputy County Surveyor,
HEREBY CERTIFY THAT THE CORNER LOCATION SHOWN ON THIS RECORD
WAS DETERMINED BY ME OR UNDER MY DIRECTION AND CONTROL AND
THAT THIS U. S. PUBLIC LAND SURVEY MONUMENT RECORD IS CORRECT
AND COMPLETE TO THE BEST OF MY KNOWLEDGE AND BELIEF.

William C. Jung
Signature

11/29/89
Date

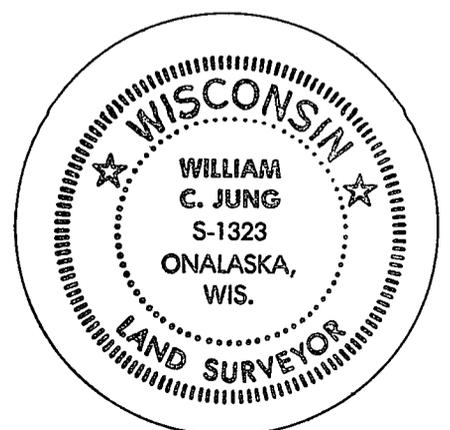

Seal