


U. S. PUBLIC LAND SURVEY MONUMENT RECORD

SECTION 8 T 15 N, R 6 W, TOWN OF SHELBY/GREENFIELD
 LA CROSSE COUNTY

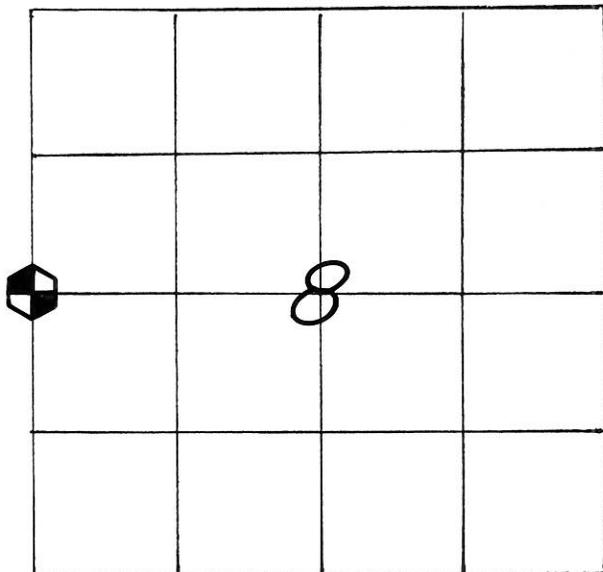

LOCATION OF LANDMARK

CREW: **BRYAN H. MEYER**
PETER F. FOLLANSBEE
 DATE: 10/05/2009

WISCONSIN COORDINATE SYSTEM	
North	654,611.737
East	1,669,873.050
Theta Angle	
Horiz. Order	
Vert. Order	
DATUM:	NAD 1983('91)
TYPE OF LANDMARK	
BRASS CAP LUNDE MARKER.	
BEARINGS ARE REFERENCED TO	
GRID NORTH AS PER SECTION DATA.	


Describe any record evidence, monument evidence, testimonial evidence or any other material evidence you considered and whether the monument was found or restored through acceptance of an obliterated evidence location.

Describe or show any material discrepancy between the location of the restored corner and that of the corner previously restored or reestablished.


RECORD OF DURABLE WITNESS MONUMENTS

MAGNETIC

NO	DESCRIPTION	BEARING	DISTANCE
1	SET A NAIL IN N.W.-SIDE OF A 6-1/2" HICKORY	N 57° E	32.93 FT.
2	SET A NAIL IN N.-SIDE OF A 6-1/2" HICKORY	S 49° E	38.27 FT.
3	SET A NAIL IN N.-SIDE OF A 7" HICKORY	S 33° E	43.73 FT.
4	EX. 1" IRON PIPE NEAR THE FENCE	S 02° E	39.77 FT.

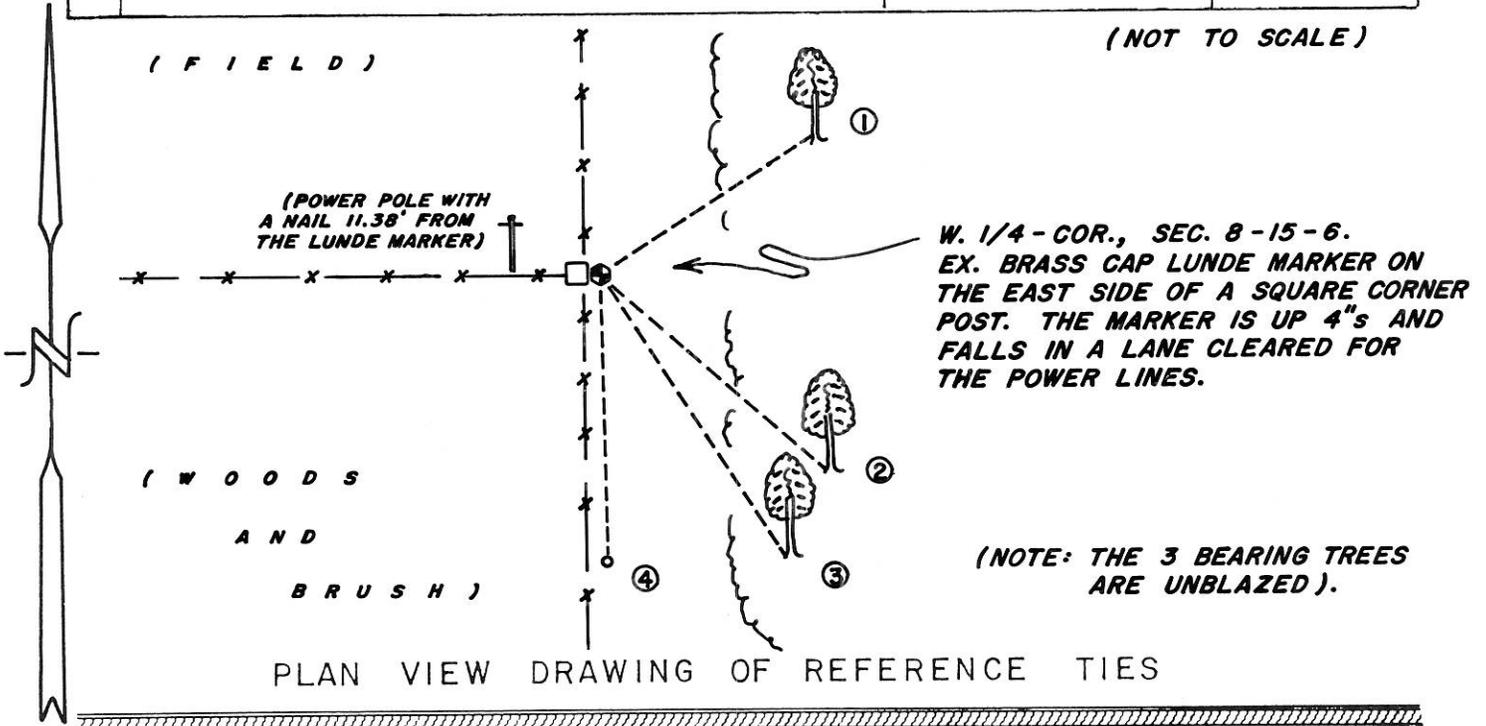

MAP SHOWING DISTANCE AND DIRECTION TO OTHER PUBLIC LAND SURVEY CORNERS USED FOR REESTABLISHING THE CORNER
(GRID BEARINGS AND DISTANCES)
(GRID FACTOR: 0.99994)
(NOT TO SCALE)

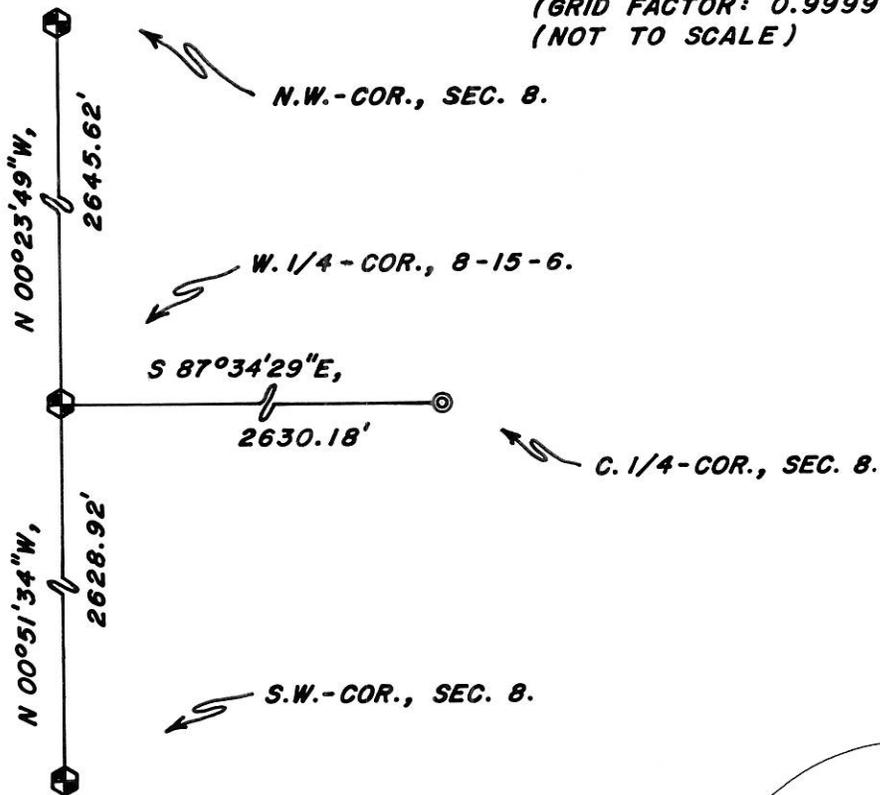

I, BRYAN H. MEYER, COUNTY SURVEYOR
HEREBY CERTIFY THAT THE CORNER LOCATION SHOWN ON THIS RECORD WAS DETERMINED BY ME OR UNDER MY DIRECTION AND CONTROL AND THAT THIS U. S. PUBLIC LAND SURVEY MONUMENT RECORD IS CORRECT AND COMPLETE TO THE BEST OF MY KNOWLEDGE AND BELIEF.

Signature: [Signature] Date: 10/16/2009




Seal

21506072000

U. S. PUBLIC LAND SURVEY MONUMENT RECORD

SECTION 8 T 15 N, R 6 W, TOWN OF Greenfield/Shelby

LA CROSSE COUNTY

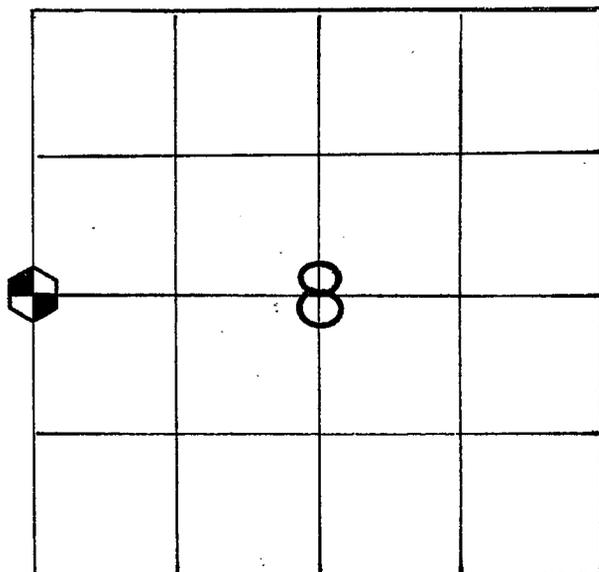

LOCATION OF LANDMARK

Crew: WILLIAM C. JUNG
PETER F. FOLLANSBEE

Date: 4/22/1991

Describe any record evidence, monument evidence, testimonial evidence or any other material evidence you considered and whether the monument was found or restored through acceptance of an obliterated evidence location.

Steve Solberg accepted the occupied fence corner as the best available evidence of the original government corner position and monumented it with one of our brass capped Lunde markers. We found and tied off the Lunde marker.

Describe or show any material discrepancy between the location of the restored corner and that of the corner previously restored or reestablished.

None known

WISCONSIN COORDINATE SYSTEM

North

East

Theta Angle

Horiz. Order

Vert. Order


TYPE OF LANDMARK

Found brass cap Lunde marker

BEARINGS ARE REFERENCED TO

RECORD OF DURABLE WITNESS MONUMENTS
MAGNETIC

NO	DESCRIPTION	BEARING	DISTANCE
1	Set P.K. Nail in 10" Hickory	S 70°W	79.95 Ft.
2	Set P.K. Nail in 15 " Hickory	S 88°W	58.33 Ft.
3	Set P.K. Nail in 9" Birch	S 82°E	32.63 Ft.
4	Found 1" Iron Pipe under fence	S 02°E	39.77 Ft.

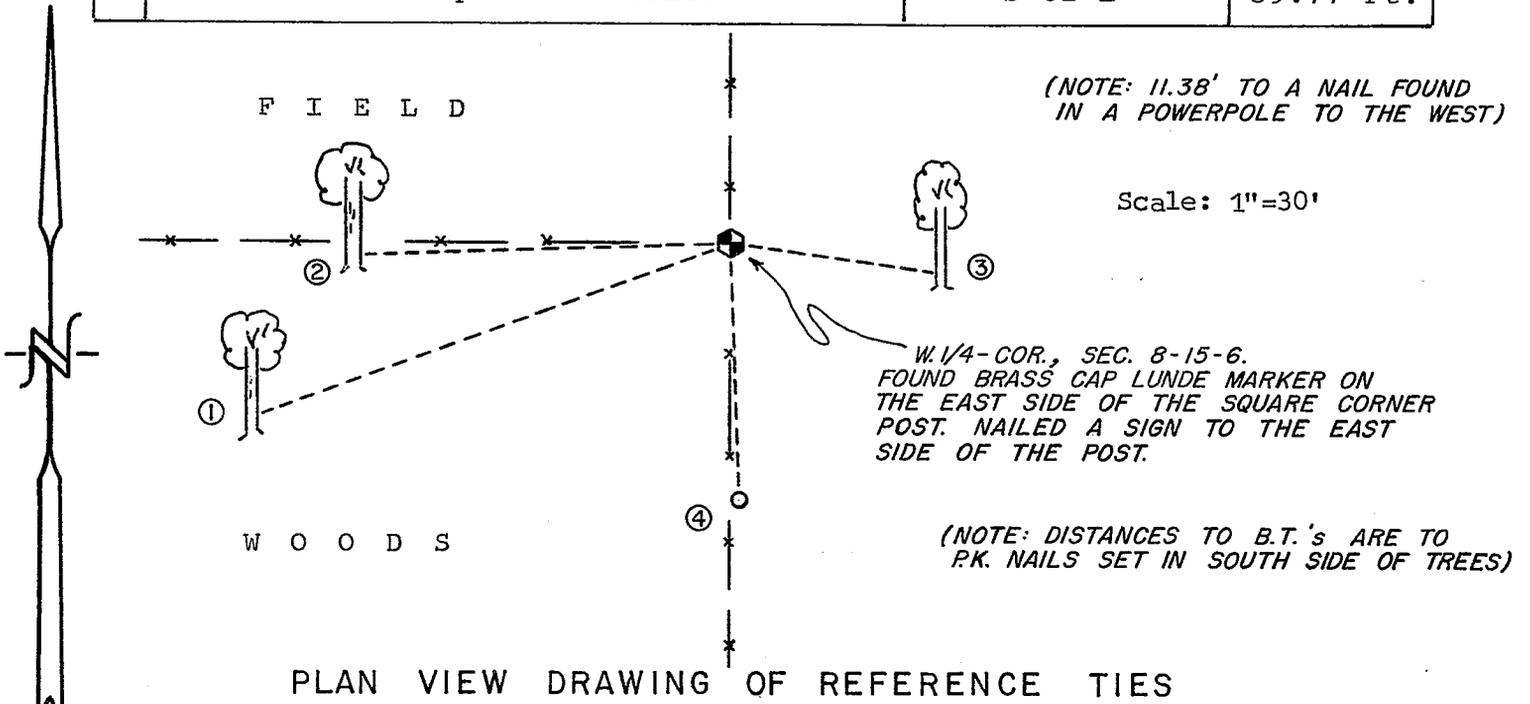

MAP SHOWING DISTANCE AND DIRECTION TO OTHER PUBLIC LAND SURVEY CORNERS USED FOR REESTABLISHING THE CORNER

No section measurements made by me at this time.

I, William C. Jung, Deputy County Surveyor
HEREBY CERTIFY THAT THE CORNER LOCATION SHOWN ON THIS RECORD
WAS DETERMINED BY ME OR UNDER MY DIRECTION AND CONTROL AND
THAT THIS U. S. PUBLIC LAND SURVEY MONUMENT RECORD IS CORRECT
AND COMPLETE TO THE BEST OF MY KNOWLEDGE AND BELIEF.

William C. Jung December 2, 1991
Signature Date



Seal