


U. S. PUBLIC LAND SURVEY MONUMENT RECORD

SECTION 9 T 15 N, R 6 W, TOWN OF Greenfield

LA CROSSE COUNTY

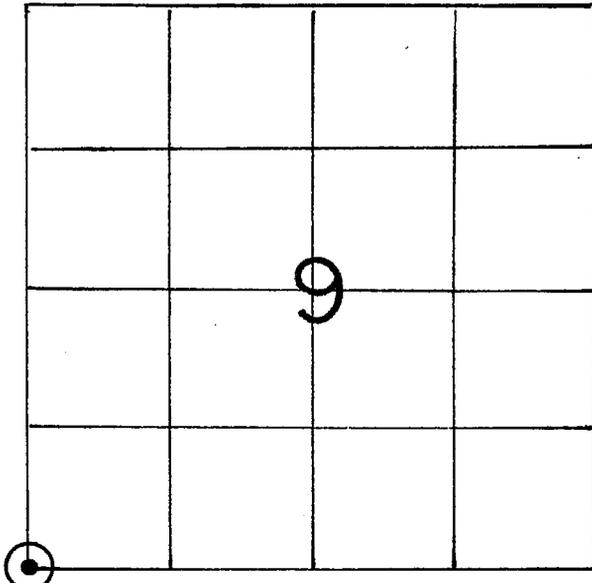

LOCATION OF LANDMARK

Crew: WILLIAM C. JUNG
PETER F. FOLLANSBEE

Date: 11/19/1991

Describe any record evidence, monument evidence, testimonial evidence or any other material evidence you considered and whether the monument was found or restored through acceptance of an obliterated evidence location.

As Dick Walter did, I accepted a large spike at the old occupied corner as the best available evidence of the original government corner position. This spike had been used as the corner in previous surveys. Also, I believe the 29" white oak to the Southeast to be an original bearing tree.

Describe or show any material discrepancy between the location of the restored corner and that of the corner previously restored or reestablished.

None known

WISCONSIN COORDINATE SYSTEM

North

East

Theta Angle

Horiz. Order

Vert. Order

TYPE OF LANDMARK


Found existing spike

BEARINGS ARE REFERENCED TO

ASSUMED NORTH

RECORD OF DURABLE WITNESS MONUMENTS


NO	DESCRIPTION	BEARING	DISTANCE
1	Set P.K. Nail in S.E.-side 1g. dbl. Oak (unblazed)		10.77 Ft.
2	Set P.K. Nail in S.-side 18" Oak (dbl. blazed)		23.44 Ft.
3	Set P.K. Nail in N.E.-side 29" W. Oak (dbl. blazed)		35.83 Ft.
4	Set P.K. Nail in S.W.-side 8" W. Oak (dbl. blazed)		16.93 Ft.

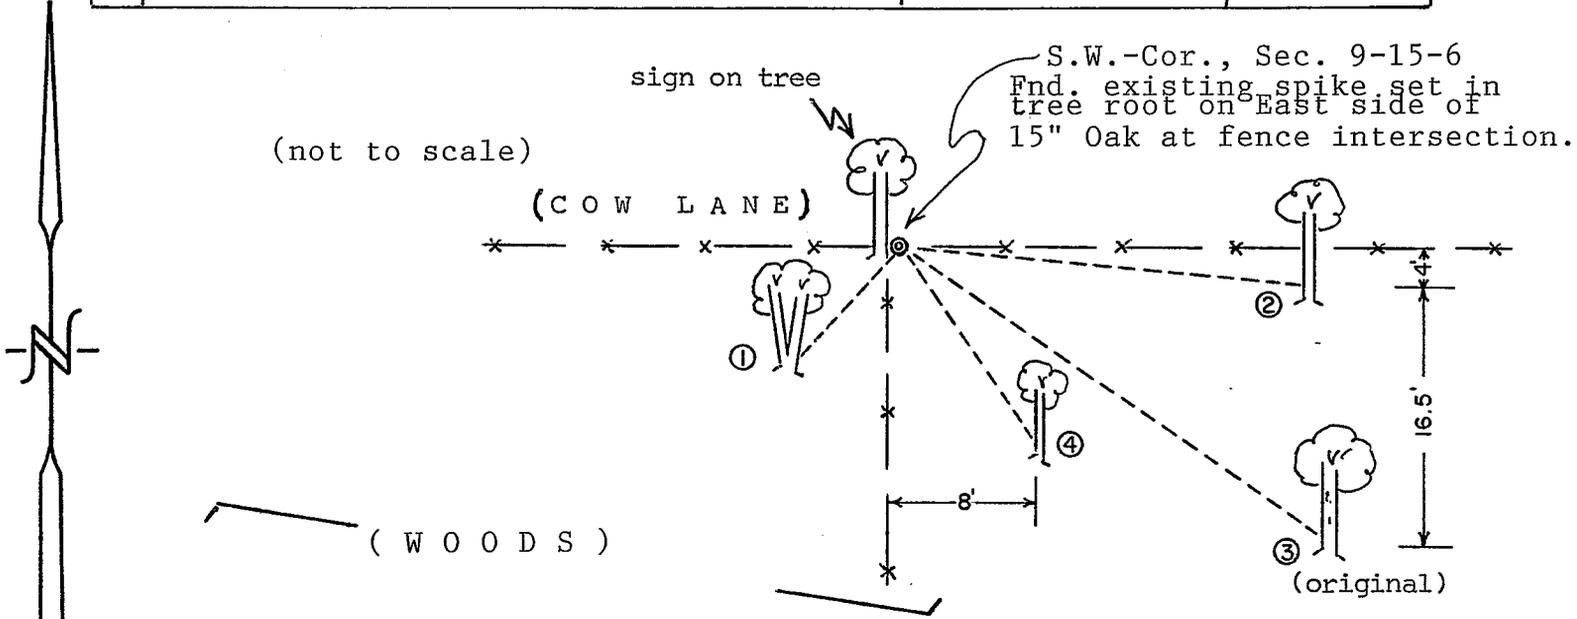

PLAN VIEW DRAWING OF REFERENCE TIES


MAP SHOWING DISTANCE AND DIRECTION TO OTHER PUBLIC LAND SURVEY CORNERS USED FOR REESTABLISHING THE CORNER

(not to scale)

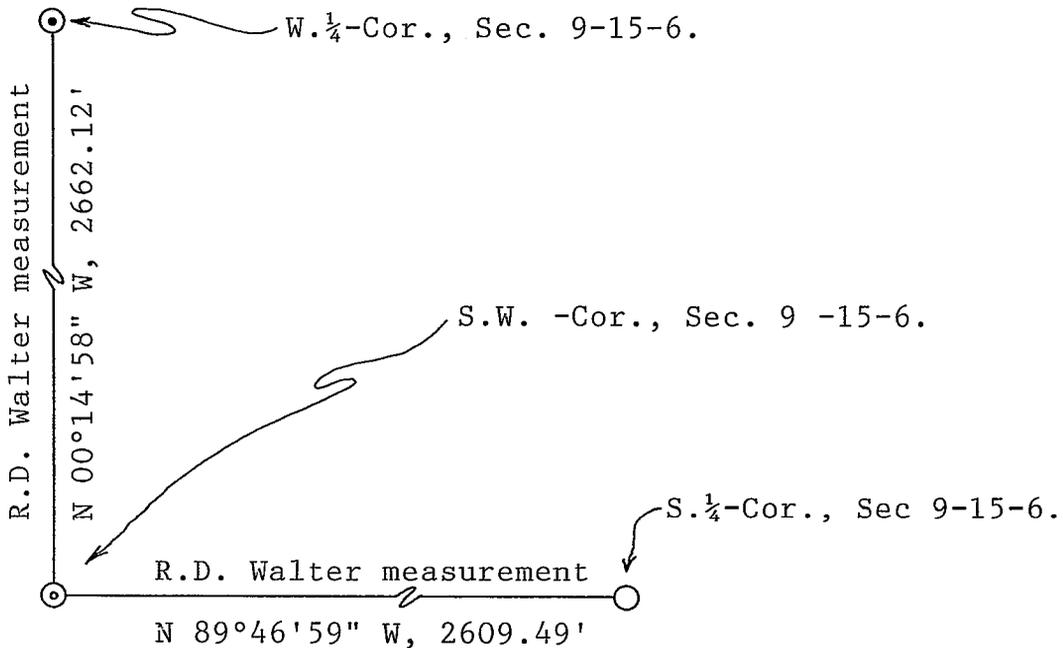

I, William C. Jung, Deputy County Surveyor
 HEREBY CERTIFY THAT THE CORNER LOCATION SHOWN ON THIS RECORD
 WAS DETERMINED BY ME OR UNDER MY DIRECTION AND CONTROL AND
 THAT THIS U. S. PUBLIC LAND SURVEY MONUMENT RECORD IS CORRECT
 AND COMPLETE TO THE BEST OF MY KNOWLEDGE AND BELIEF.

William C. Jung December 2, 1991
 Signature Date

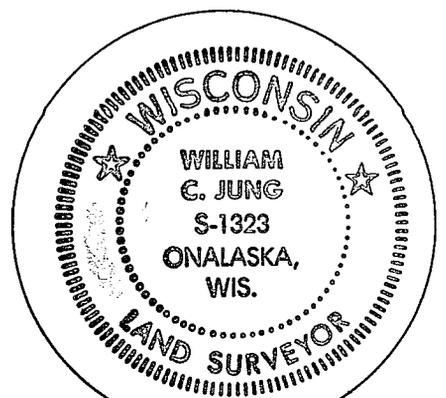

Seal



WALTER LAND SURVEYS

Spring
1991

Richard D. Walter
550 Skunk Hollow Road
La Crescent, MN 55947
(507) 895-2446

SOUTHWEST CORNER SECTION 9, T15N, R6W

April 1991

After a thorough search of the county records I found some surveys tied to this corner and the old plat books show occupation lines at section corner. Richard D. Walter P.L.S. traversed to the area of the corner and found no original corner or any bearing tree evidence.

We found no other survey monumentation at the corner.

We did find a well defined fence coming from the South. We also found a well defined fence coming from the East and West. At the fence intersection we found a large spike with survey ribbon around it.

Accept spike and three way fence intersection as best evidence of section corner.

Found survey spike @
Fence Intersection

