


## U. S. PUBLIC LAND SURVEY MONUMENT RECORD

SECTION 17 T 15 N, R 6 W, TOWN OF GREENFIELD

LA CROSSE COUNTY

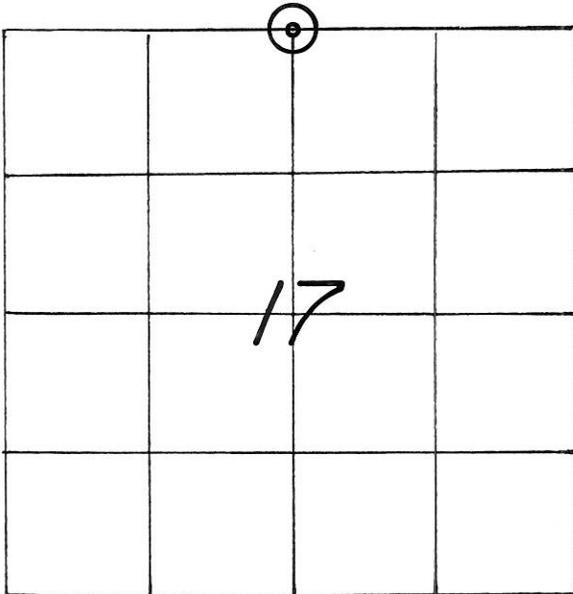

LOCATION OF LANDMARK

CREW: **BRYAN H. MEYER**  
**PETER F. FOLLANSBEE**  
 DATE: **9/30/2009**

## WISCONSIN COORDINATE SYSTEM

North **651,839.280**East **1,672,534.539**

Theta Angle

Horiz. Order

Vert. Order

**DATUM: NAD 1983('91)**

## TYPE OF LANDMARK

**1-1/4" (O.D.) IRON PIPE WITH PLASTIC PLUG.**

BEARINGS ARE REFERENCED TO

**GRID NORTH AS PER SECTION DATA.**


Describe any record evidence, monument evidence, testimonial evidence or any other material evidence you considered and whether the monument was found or restored through acceptance of an obliterated evidence location.

Describe or show any material discrepancy between the location of the restored corner and that of the corner previously restored or reestablished.

RECORD OF DURABLE WITNESS MONUMENTS


MAGNETIC

NO	DESCRIPTION	BEARING	DISTANCE
1	EX. SPIKE IN E.-SIDE OF A 19-1/2" OAK	S 66° W	18.74 FT.
2	EX. SPIKE IN S.E.-SIDE OF A 16" OAK	N 41° W	13.93 FT.
3	EX. SPIKE IN S.-SIDE OF A 19" OAK	N 06° W	3.19 FT.
4	EX. SPIKE IN N.W.-SIDE OF A 17" OAK	S 49° E	20.66 FT.

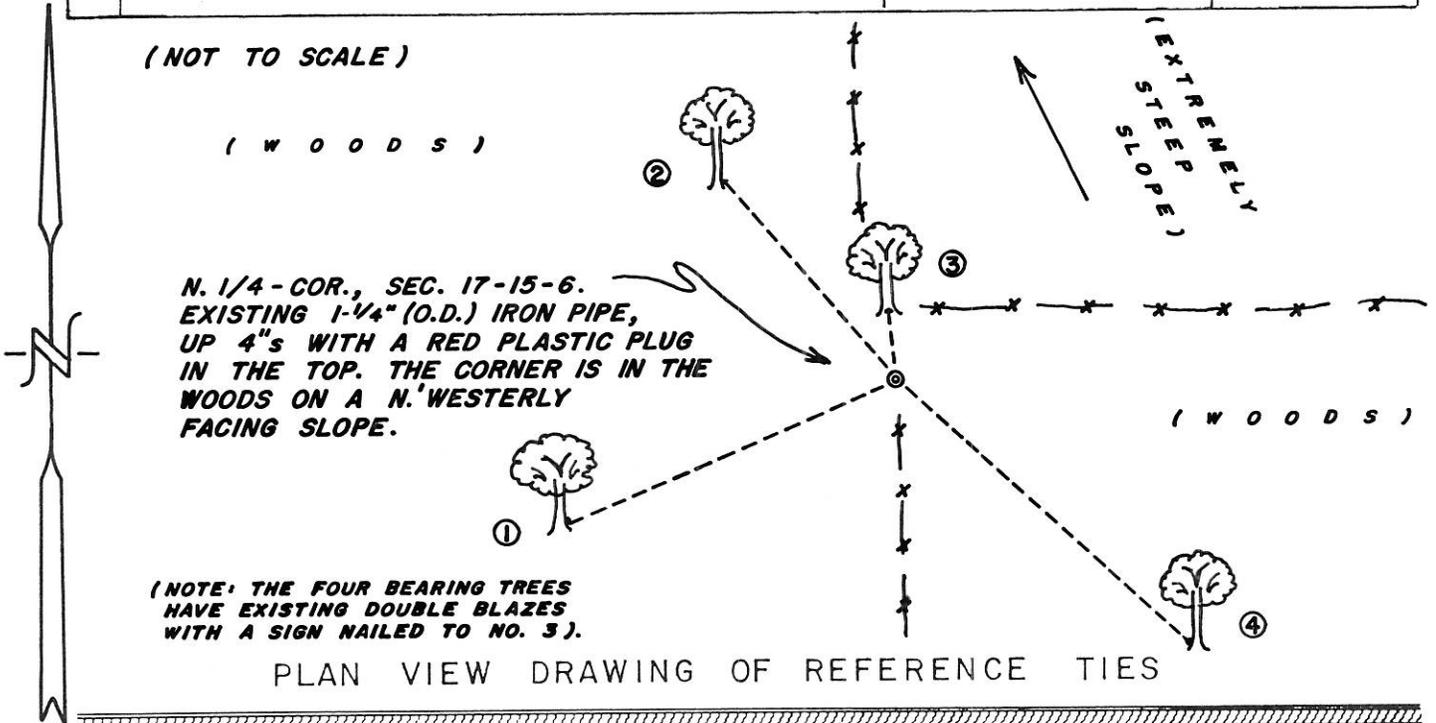

MAP SHOWING DISTANCE AND DIRECTION TO OTHER PUBLIC LAND SURVEY CORNERS USED FOR REESTABLISHING THE CORNER

(GRID BEARINGS AND DISTANCES)  
(GRID FACTOR: 0.999756106)  
(NOT TO SCALE)

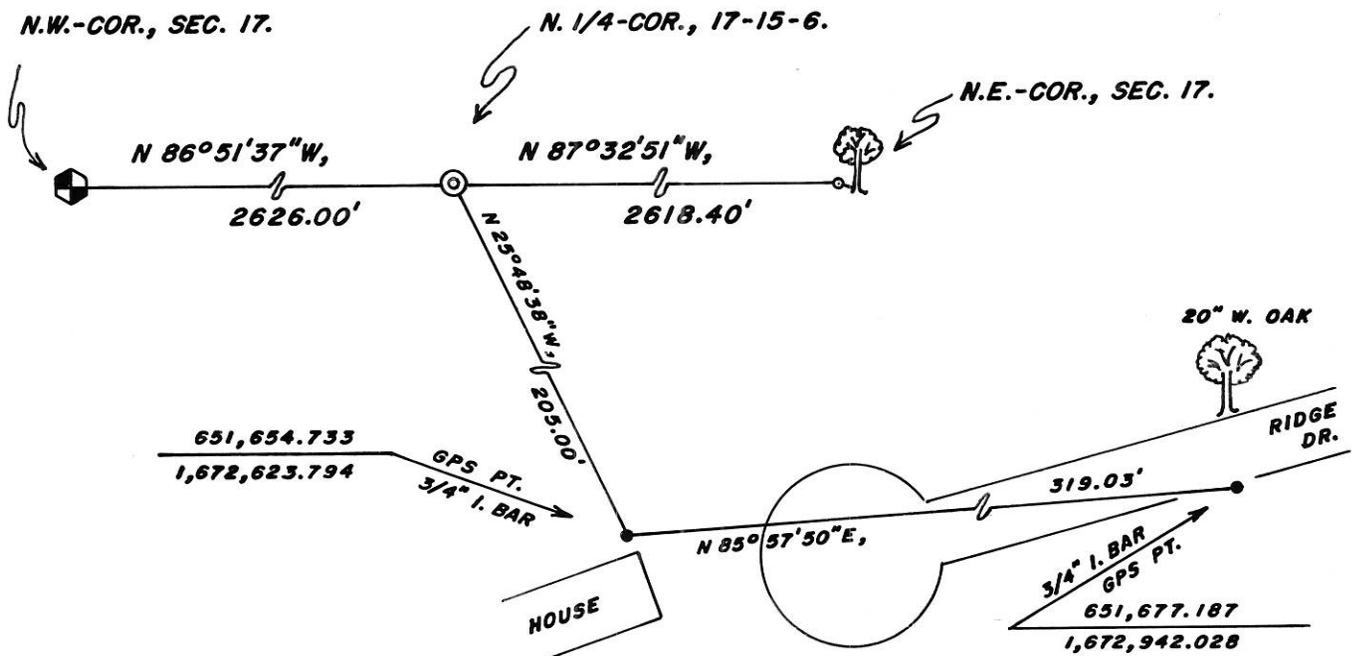

I, BRYAN H. MEYER, COUNTY SURVEYOR  
HEREBY CERTIFY THAT THE CORNER LOCATION SHOWN ON THIS RECORD  
WAS DETERMINED BY ME OR UNDER MY DIRECTION AND CONTROL AND  
THAT THIS U. S. PUBLIC LAND SURVEY MONUMENT RECORD IS CORRECT  
AND COMPLETE TO THE BEST OF MY KNOWLEDGE AND BELIEF.

Signature \_\_\_\_\_ Date 10/9/2009




Seal

21506080020

## U. S. PUBLIC LAND SURVEY MONUMENT RECORD

SECTION 17 T 15 N, R 6 W, TOWN OF GREENFIELD

LA CROSSE COUNTY

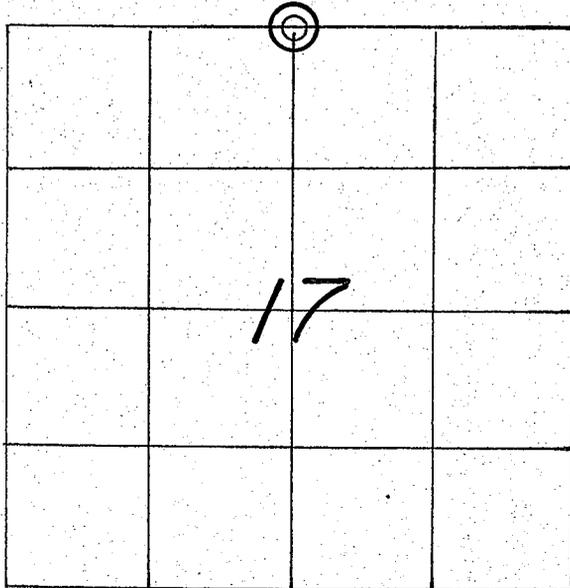

LOCATION OF LANDMARK

CREW: **WILLIAM C. JUNG**  
**PETER F. FOLLANSBEE**  
 DATE: **1/16/2004**

WISCONSIN COORDINATE SYSTEM

North

East

Theta Angle

Horiz. Order

Vert. Order

TYPE OF LANDMARK

**1-1/4" (O.D.) IRON PIPE WITH PLASTIC PLUG.**

BEARINGS ARE REFERENCED TO

Describe any record evidence, monument evidence, testimonial evidence or any other material evidence you considered and whether the monument was found or restored through acceptance of an obliterated evidence location.


I found an iron pipe at the corner that had been used as the corner in several previous surveys of record. I accepted this pipe as the best available evidence of the original government corner location/position. One of our red plastic caps was set in the pipe. The pipe had obviously been tied off before. However, no tie sheet was filed.

Describe or show any material discrepancy between the location of the restored corner and that of the corner previously restored or reestablished.

**NONE KNOWN.**

RECORD OF DURABLE WITNESS MONUMENTS

NO	DESCRIPTION	MAGNETIC	
		BEARING	DISTANCE
1	EX. SPIKE IN E.-SIDE OF A 19-1/2" OAK	S 66° W	18.74 FT.
2	EX. SPIKE IN S.E.-SIDE OF A 16" OAK	N 41° W	13.93 FT.
3	EX. SPIKE IN S.-SIDE OF A 19" OAK	N 06° W	3.19 FT.
4	EX. SPIKE IN N.W.-SIDE OF A 17" OAK	S 49° E	20.66 FT.

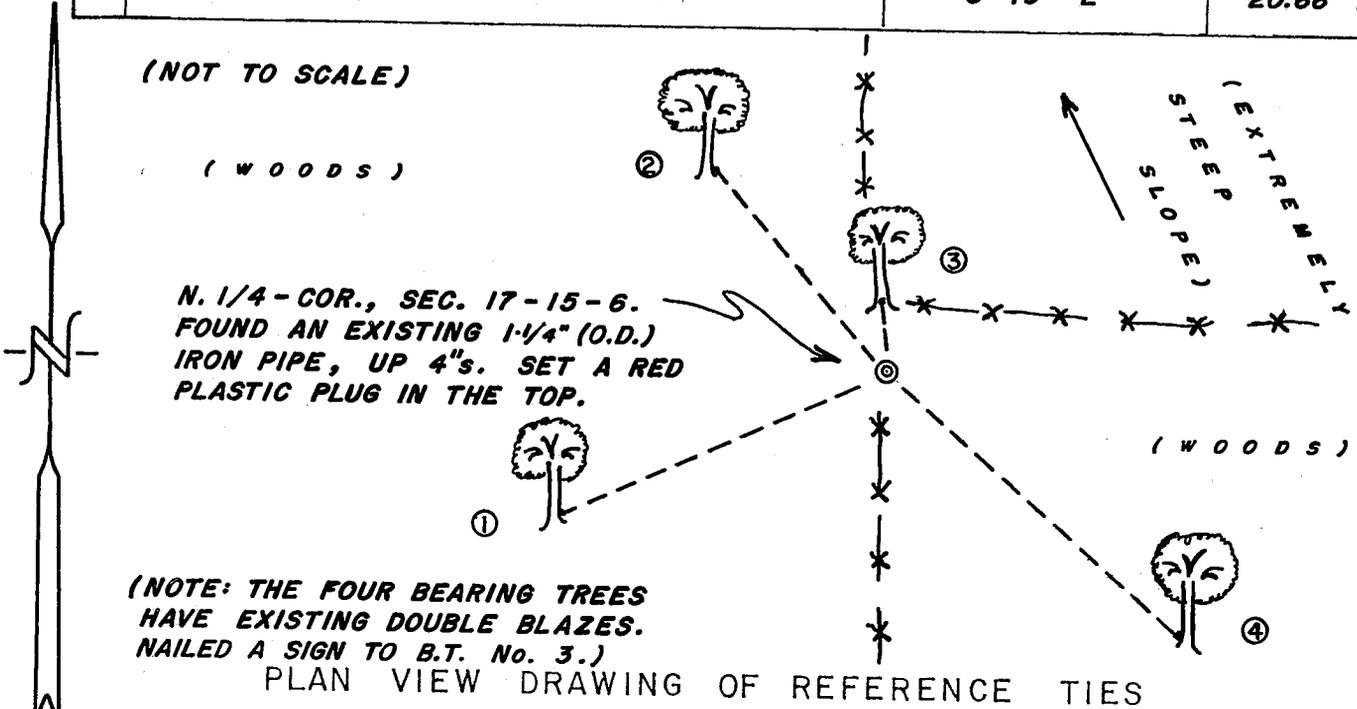


MAP SHOWING DISTANCE AND DIRECTION TO OTHER PUBLIC LAND SURVEY CORNERS USED FOR REESTABLISHING THE CORNER

No section measurements were made by me at this time. The location of this corner was confirmed by section measurements of record.

I, WILLIAM C. JUNG, COUNTY SURVEYOR  
HEREBY CERTIFY THAT THE CORNER LOCATION SHOWN ON THIS RECORD  
WAS DETERMINED BY ME OR UNDER MY DIRECTION AND CONTROL AND  
THAT THIS U. S. PUBLIC LAND SURVEY MONUMENT RECORD IS CORRECT  
AND COMPLETE TO THE BEST OF MY KNOWLEDGE AND BELIEF.

William C. Jung 1/27/04  
Signature Date

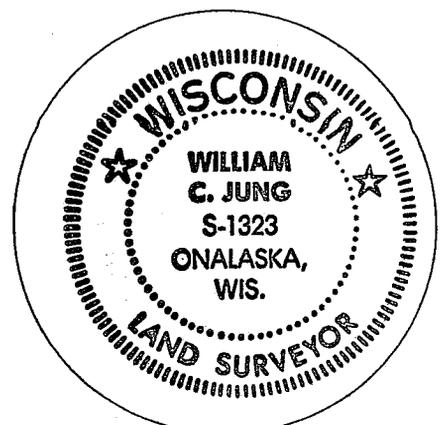

Seal