


21506082000

U. S. PUBLIC LAND SURVEY MONUMENT RECORD

SECTION 9 T 15 N, R 6 W, TOWN OF GREENFIELD

LA CROSSE COUNTY

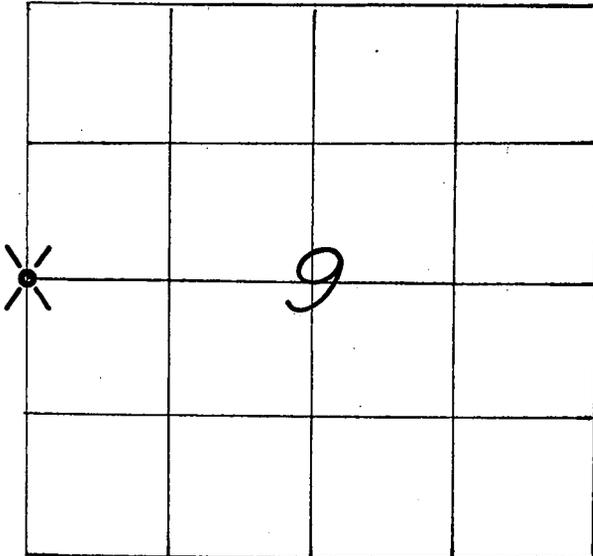

LOCATION OF LANDMARK

CREW: WILLIAM C. JUNG
 PETER F. FOLLANSBEE
 DATE: 11/07/2007

WISCONSIN COORDINATE SYSTEM	
North	654,389.107
East	1,675,173.544
Theta Angle	
Horiz. Order	
Vert. Order	
DATUM:	1983('91)
TYPE OF LANDMARK	
COMPUTED LOCATION (NOTHING SET).	
BEARINGS ARE REFERENCED TO	
ASSUMED NORTH AS PER SECTION DATA.	

Describe any record evidence, monument evidence, testimonial evidence or any other material evidence you considered and whether the monument was found or restored through acceptance of an obliterated evidence location.

The old corner as per my 1991 tie sheet was destroyed during road construction. I don't feel that it is now safe to occupy a corner on this highly travelled highway. Therefore this is now a computed location with all of the necessary control needed on the tie points.


Describe or show any material discrepancy between the location of the restored corner and that of the corner previously restored or reestablished.

NONE KNOWN.

U. S. PUBLIC LAND SURVEY MONUMENT RECORD

SECTION 9 T 15 N, R 6 W, TOWN OF Greenfield

LA CROSSE COUNTY

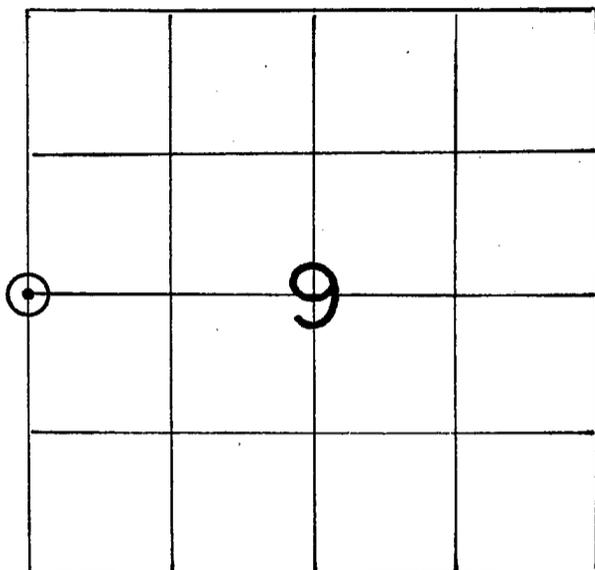

LOCATION OF LANDMARK

Crew: WILLIAM C. JUNG
 PETER F. FOLLANSBEE

Date: 11/18/1991

Describe any record evidence, monument evidence, testimonial evidence or any other material evidence you considered and whether the monument was found or restored through acceptance of an obliterated evidence location.

I found and accepted Dick Walter's P.K. nail as the best available evidence of the original government corner position.

Describe or show any material discrepancy between the location of the restored corner and that of the corner previously restored or reestablished.


None known

WISCONSIN COORDINATE SYSTEM
North
East
Theta Angle
Horiz. Order
Vert. Order
TYPE OF LANDMARK
Existing P.K. Nail
BEARINGS ARE REFERENCED TO ASSUMED NORTH

VOID weg


RECORD OF DURABLE WITNESS MONUMENTS

NO	DESCRIPTION	BEARING	DISTANCE
1	Set 3/4"x 16" Bolt N.E. of fence corner	N.W. <u>+</u>	72.93 Ft.
2	Set 7/8"x 17" Rebar 1' S. of sign post	N.E. <u>+</u>	115.26 Ft.
3	Set 7/8"x 17" Rebar by fence intersection	N.E. <u>+</u>	59.32 Ft.
4	Existing Iron Pipe w/R.D. Walter plug	South <u>+</u>	38.68 Ft.

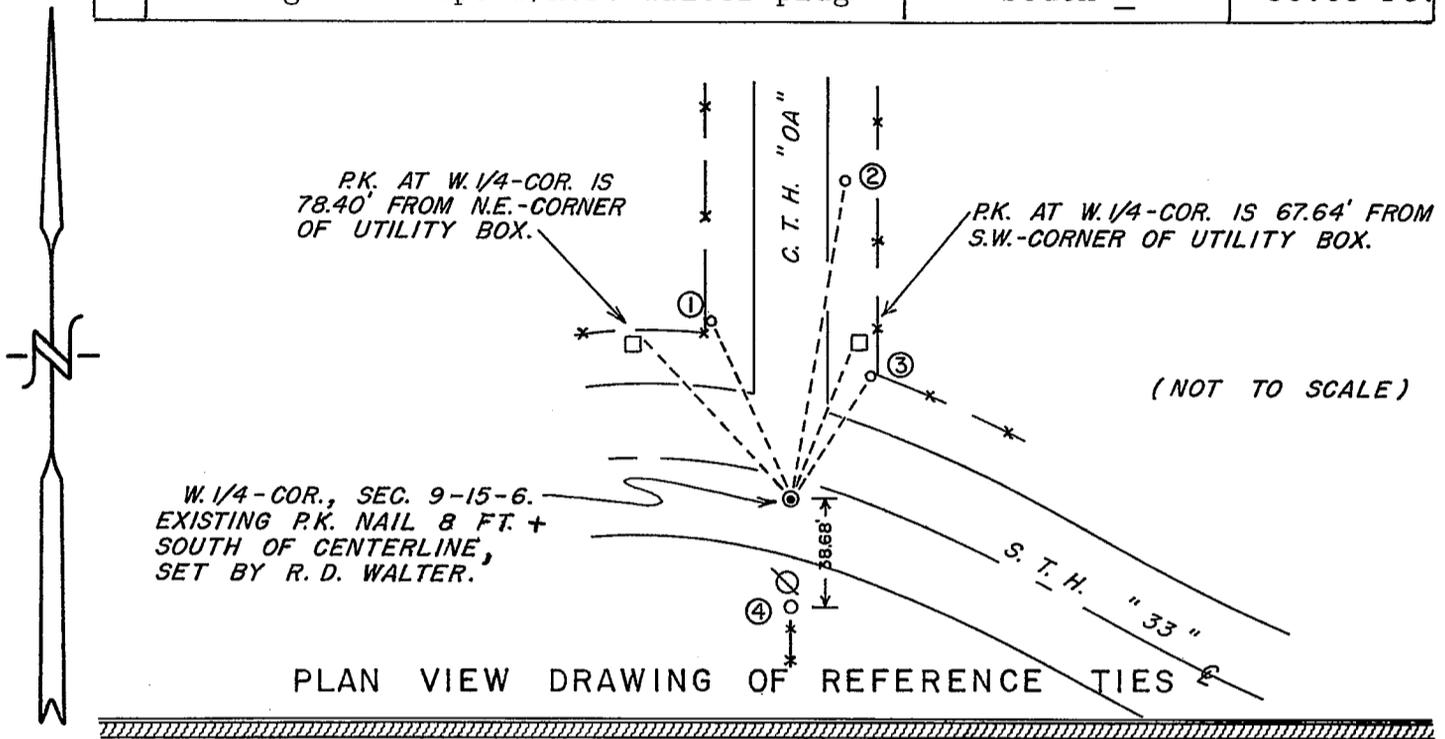

MAP SHOWING DISTANCE AND DIRECTION TO OTHER PUBLIC LAND SURVEY CORNERS USED FOR REESTABLISHING THE CORNER

(not to scale)

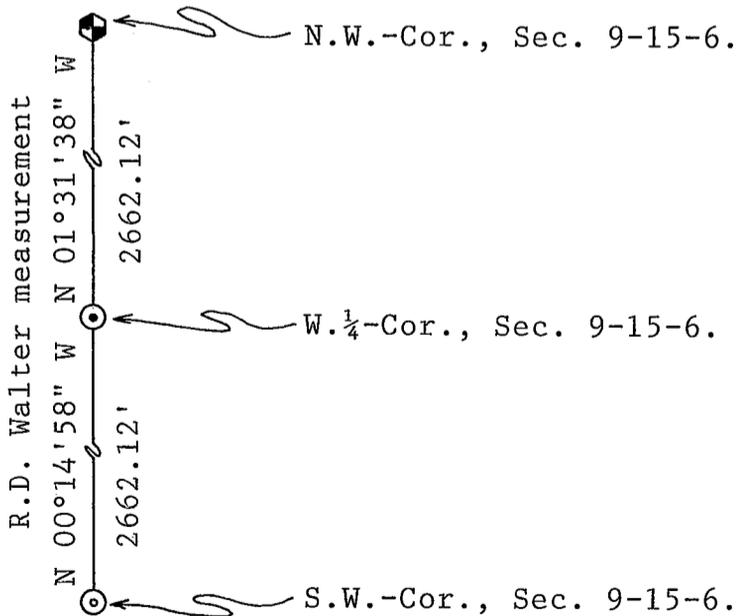

I, William C. Jung, Deputy County Surveyor
 HEREBY CERTIFY THAT THE CORNER LOCATION SHOWN ON THIS RECORD
 WAS DETERMINED BY ME OR UNDER MY DIRECTION AND CONTROL AND
 THAT THIS U. S. PUBLIC LAND SURVEY MONUMENT RECORD IS CORRECT
 AND COMPLETE TO THE BEST OF MY KNOWLEDGE AND BELIEF.

William C. Jung
 Signature

December 2, 1991
 Date



Seal

