


## U. S. PUBLIC LAND SURVEY MONUMENT RECORD

SECTION 9 T 15 N, R 6 W, TOWN OF GREENFIELD

LA CROSSE COUNTY

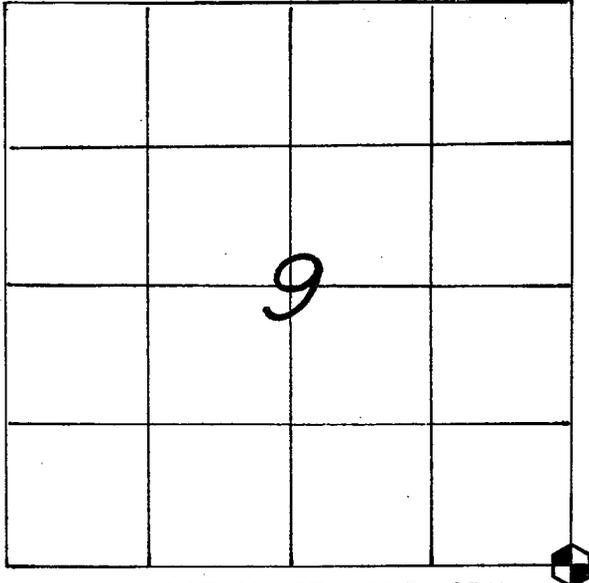

LOCATION OF LANDMARK

Crew: WILLIAM C. JUNG  
 PETER F. FOLLANSBEE  
 Date: 6/24/1996

Describe any record evidence, monument evidence, testimonial evidence or any other material evidence you considered and whether the monument was found or restored through acceptance of an obliterated evidence location.

Dick Walter set an iron pipe at this corner. He set it at a computed location that we had agreed on. The iron pipe was removed and replaced with a brass capped Lunde marker.

Describe or show any material discrepancy between the location of the restored corner and that of the corner previously restored or reestablished.

None Known.

## WISCONSIN COORDINATE SYSTEM

North

East

Theta Angle

Horiz. Order

Vert. Order

## TYPE OF LANDMARK

Set brass cap Lunde marker.

## BEARINGS ARE REFERENCED TO

Assumed

