


21506100000

## U. S. PUBLIC LAND SURVEY MONUMENT RECORD

SECTION 11 T 15 N, R 6 W, TOWN OF Greenfield

LA CROSSE COUNTY

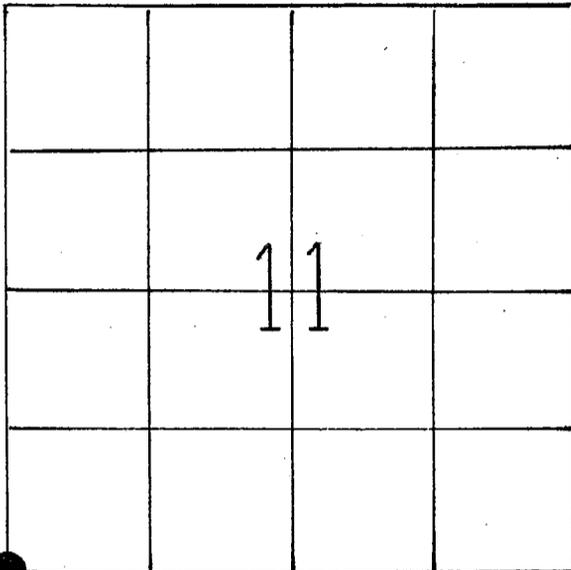

LOCATION OF LANDMARK

Crew: William C. Jung  
Peter Follansbee

Date: December 11, 1989

## WISCONSIN COORDINATE SYSTEM

North

East

Theta Angle

Horiz. Order

Vert. Order

## TYPE OF LANDMARK

~~Existing iron pipe~~ Lunde marker

## BEARINGS ARE REFERENCED TO

True (as per Scholze survey)

Crew: William C. Jung  
Peter F. Follansbee  
Witness: Eugene Bahr

Date: July 10, 1990

Describe any record evidence, monument evidence, testimonial evidence or any other material evidence you considered and whether the monument was found or restored through acceptance of an obliterated evidence location.

Phil Scholze set an iron pipe at his computed corner. He said that the field evidence indicates to him that the 1/2 mile to the West is a chain long. I agree with his analysis of the problem. I accepted Scholze's iron pipe as the best evidence of the original government corner position.

On July 10, 1990, Follansbee and I removed the iron pipe and replaced it with a brass capped Lunde marker. We also set a sign and post to the Southwest and buried a liquor bottle with a shell casing to the Southeast.

Describe or show any material discrepancy between the location of the restored corner and that of the corner previously restored or reestablished.

This corner location and the section line to the East would not agree with the data as shown on the CSM done by James Logan for Steve Bahr in the SW1/4 of the SW1/4 of Section 11 in September of 1988.


RECORD OF DURABLE WITNESS MONUMENTS

NO	DESCRIPTION	BEARING	DISTANCE
1	P.K. nail on North side of unblazed hickory	West <sub>±</sub>	15.45'
2	Buried an iron pipe, down 19"	East <sub>±</sub>	35.31
3			
4			

(not to scale)

Note: No other ties near, ground frozen, wind chill below zero.

F I E L D

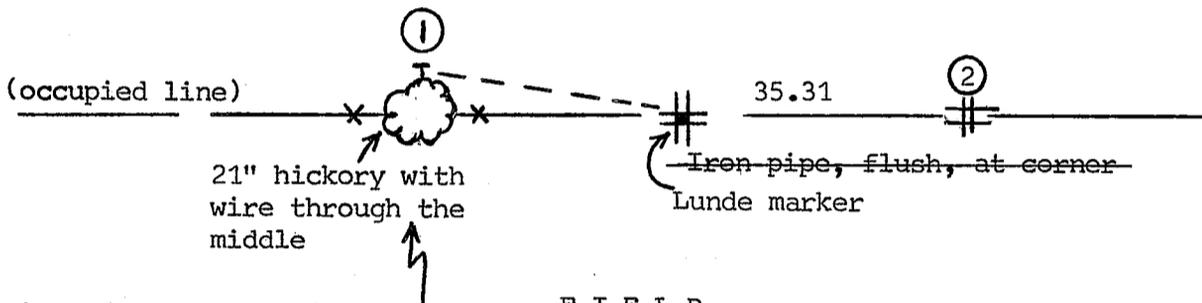


Note: Bahr said that the old line fence from the South went to the tree, but he didn't know how accurate it was.

PLAN VIEW DRAWING OF REFERENCE TIES

MAP SHOWING DISTANCE AND DIRECTION TO OTHER PUBLIC LAND SURVEY CORNERS USED FOR REESTABLISHING THE CORNER

(not to scale)

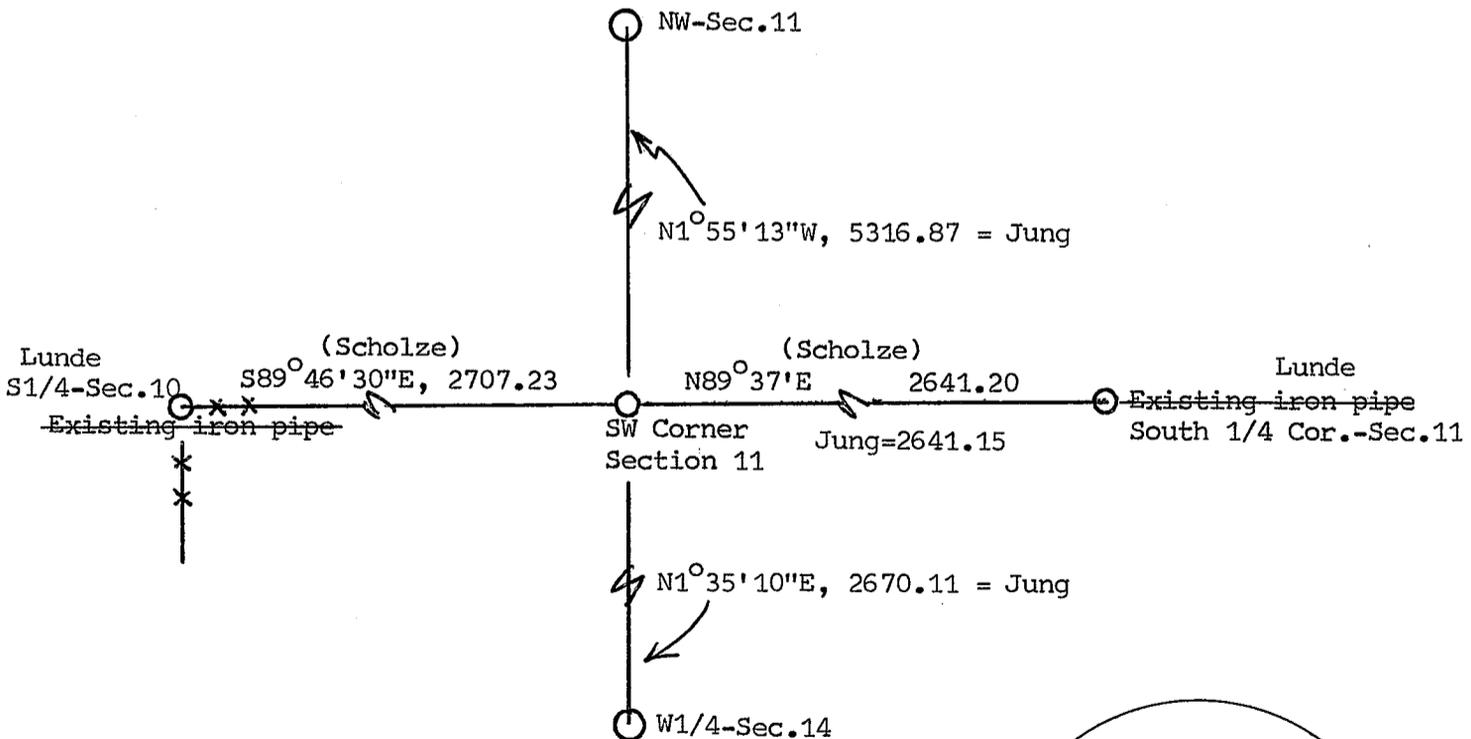


I, William C. Jung, Deputy County Surveyor,  
 HEREBY CERTIFY THAT THE CORNER LOCATION SHOWN ON THIS RECORD  
 WAS DETERMINED BY ME OR UNDER MY DIRECTION AND CONTROL AND  
 THAT THIS U. S. PUBLIC LAND SURVEY MONUMENT RECORD IS CORRECT  
 AND COMPLETE TO THE BEST OF MY KNOWLEDGE AND BELIEF.

William C. Jung  
 Signature

December 19, 1989

Date

Revised: January 7, 1991

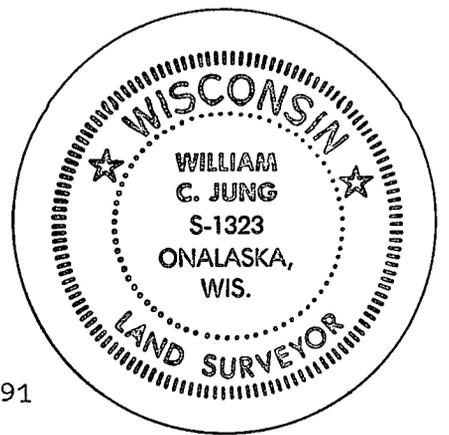

Seal