


## U. S. PUBLIC LAND SURVEY MONUMENT RECORD

SECTION 10 T 15 N, R 6 W, TOWN OF Greenfield

LA CROSSE COUNTY

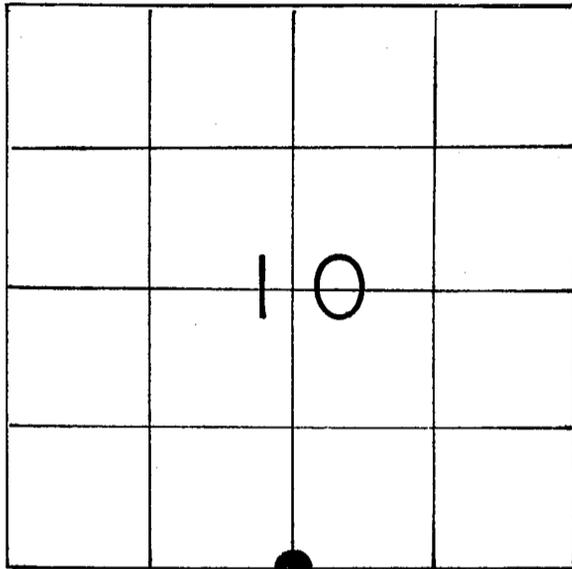

LOCATION OF LANDMARK

Crew: William C. Jung  
Peter F. Follansbee

Date: October 1, 1990

Describe any record evidence, monument evidence, testimonial evidence or any other material evidence you considered and whether the monument was found or restored through acceptance of an obliterated evidence location.

Phil Scholze set an iron pipe at the occupied corner. I accepted the occupied corner as the best available evidence of the original government corner position. I removed the pipe and replaced it with a Lunde marker. I also buried a bottle with a shell casing on the NW side of the marker.

Describe or show any material discrepancy between the location of the restored corner and that of the corner previously restored or reestablished.

Logan supposedly set an iron pipe at this corner but neither Scholze or I found it.

## WISCONSIN COORDINATE SYSTEM

North

East

Theta Angle

Horiz. Order

Vert. Order

## TYPE OF LANDMARK

Brass capped Lunde marker

## BEARINGS ARE REFERENCED TO

True

