


21506102000

## U. S. PUBLIC LAND SURVEY MONUMENT RECORD

SECTION II T 15 N, R 6 W, TOWN OF GREENFIELD  
 LA CROSSE COUNTY

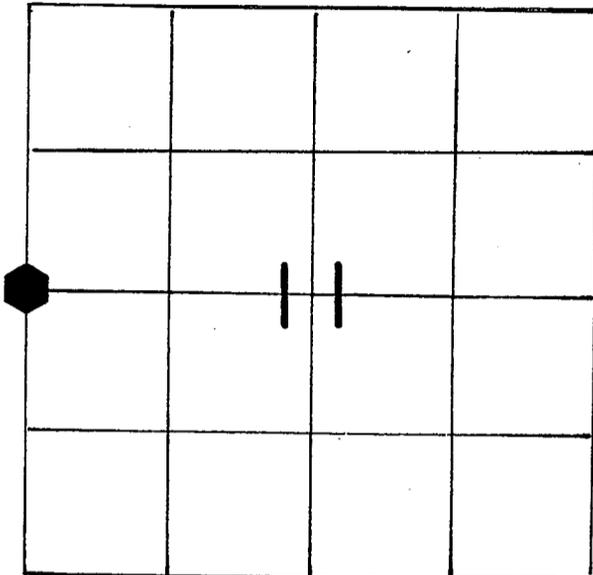

LOCATION OF LANDMARK

Crew: WILLIAM C. JUNG  
 PETER F. FOLLANSBEE

Date: 6/09/1994

Describe any record evidence, monument evidence, testimonial evidence or any other material evidence you considered and whether the monument was found or restored through acceptance of an obliterated evidence location.

After reconstructing the location of the old occupied corner, I accepted it as the best available evidence of the original government corner position. This corner falls 4.33' South and 1.19' West of the single proportionate position. I set a Berntsen top at the corner. While digging I hit a stone which could have been an old corner stone.

Describe or show any material discrepancy between the location of the restored corner and that of the corner previously restored or reestablished.

None Known.

## WISCONSIN COORDINATE SYSTEM

North

East

Theta Angle

Horiz. Order

Vert. Order

## TYPE OF LANDMARK


Set Berntsen Top in centerline.

## BEARINGS ARE REFERENCED TO


True North.

RECORD OF DURABLE WITNESS MONUMENTS

| NO | DESCRIPTION                                    | BEARING               | DISTANCE   |
|----|--|-----------------------|------------|
| 1  | Set 1 1/4" x 28" I.P. down 12"s in hayfield    | West ±                | 33.03 Ft.  |
| 2  | Center of Top Nut of well cap 33' W. of c'line | Northwesterly±        | 191.90 Ft. |
| 3  | Set 1 1/4" x 28" I.P. 3' S. of SW-cor of shed  | NE'ly±(44.1' E. c'ln) | 86.56 Ft.  |
| 4  | Set P.K. Nail in SW-cor. of machine shed       | Easterly ±            | 82.44 Ft.  |

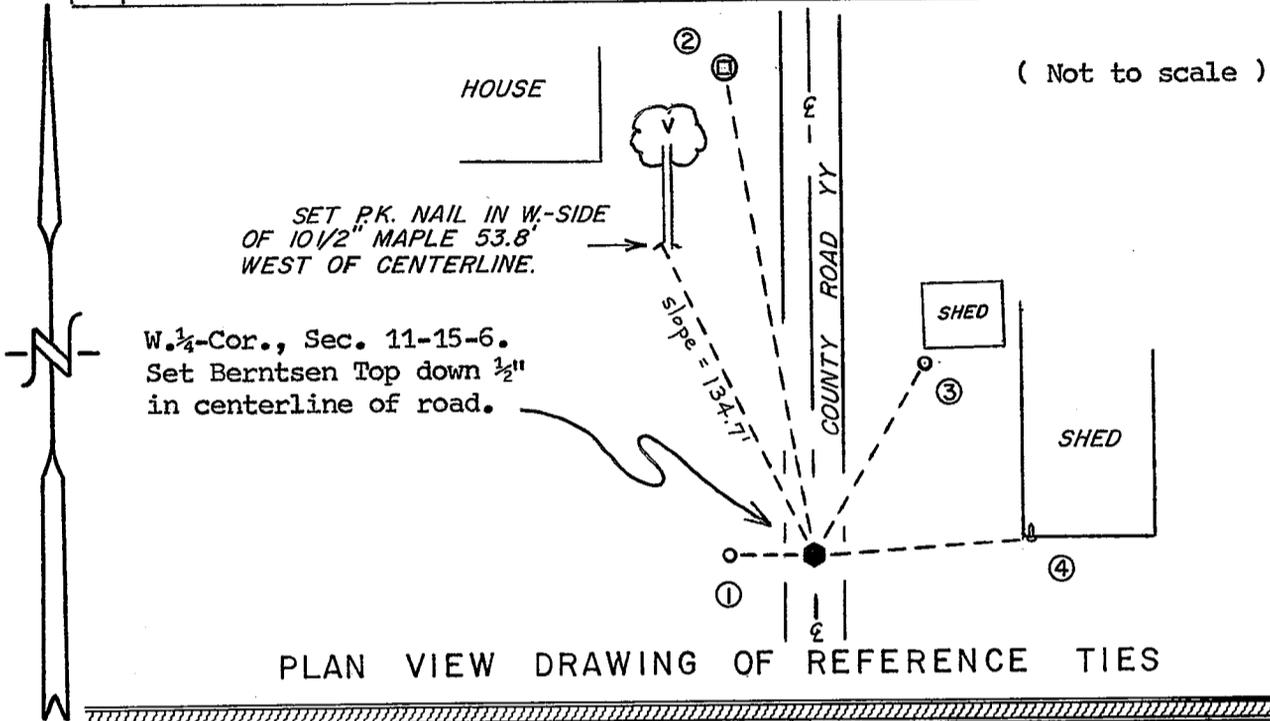


MAP SHOWING DISTANCE AND DIRECTION TO OTHER PUBLIC LAND SURVEY CORNERS USED FOR REESTABLISHING THE CORNER

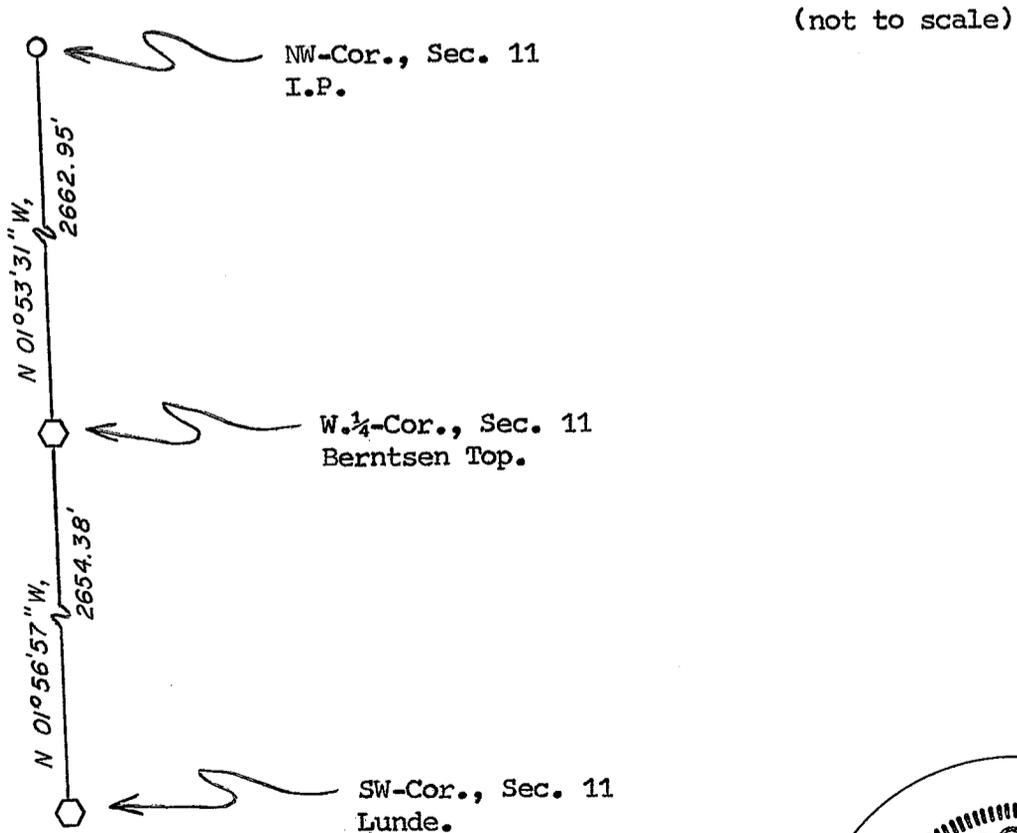

I, William C. Jung, County Surveyor,  
 HEREBY CERTIFY THAT THE CORNER LOCATION SHOWN ON THIS RECORD WAS DETERMINED BY ME OR UNDER MY DIRECTION AND CONTROL AND THAT THIS U. S. PUBLIC LAND SURVEY MONUMENT RECORD IS CORRECT AND COMPLETE TO THE BEST OF MY KNOWLEDGE AND BELIEF.

William C. Jung  
 Signature

9/26/94  
 Date

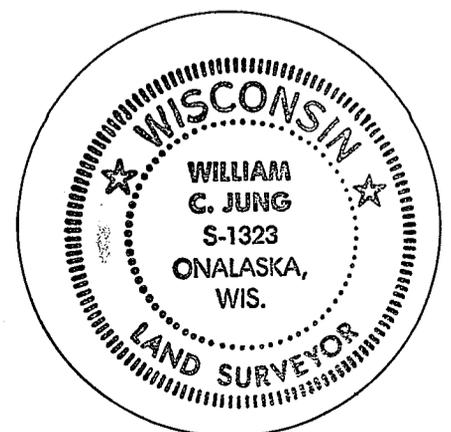

Seal